

DAIDO KAIUN  
KOSEI MARU

CONSTRUCTION PROFILE  
AND  
DECK PLAN  
SHEET I  
(FINISHED PLAN)

SCALE 1/400 GLASS 1/2

HULL DESIGNING SECTION  
SHIP DESIGNING DEPARTMENT  

CHEF OF DEPT. *[Signature]*  
HEAD *[Signature]*  
CHECKED *[Signature]*  
DRAWN *[Signature]*

JTB NO. 1485  
SHIP NO. 1485  
DSN NO. H-207A



RECORDS DEPT.,  
LONDON.

3

SHIMONOSEKI

R.P.T. NO. 775

DATED. \_\_\_\_\_



KOSEI MARU



Construction Profile 8

Deck plan  
(Sheet 1)

*Certified in accordance with  
approved Plan.*

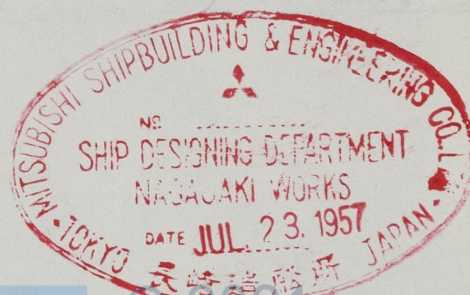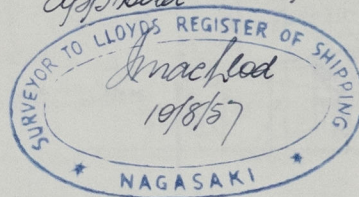

© 2021

Lloyd's Register  
Foundation

013018-013026-0165