

DRAWING NO 1304/2  
TWIN SCREW FERRIES - BIRKENHEAD




SCANTLING PROFILE & PROMENADE DECK

SCALE 1/4" TO ONE FOOT



NOTE: CAMBER ON ALL DECKS EXCEPT LOWER DECKS 10" IN 100' HALF BREADTH  
CAMBER ON LOWER DECKS 6"

Girders to be supported by tryping  
brackets in accordance with Q 1500  
of the Rules.

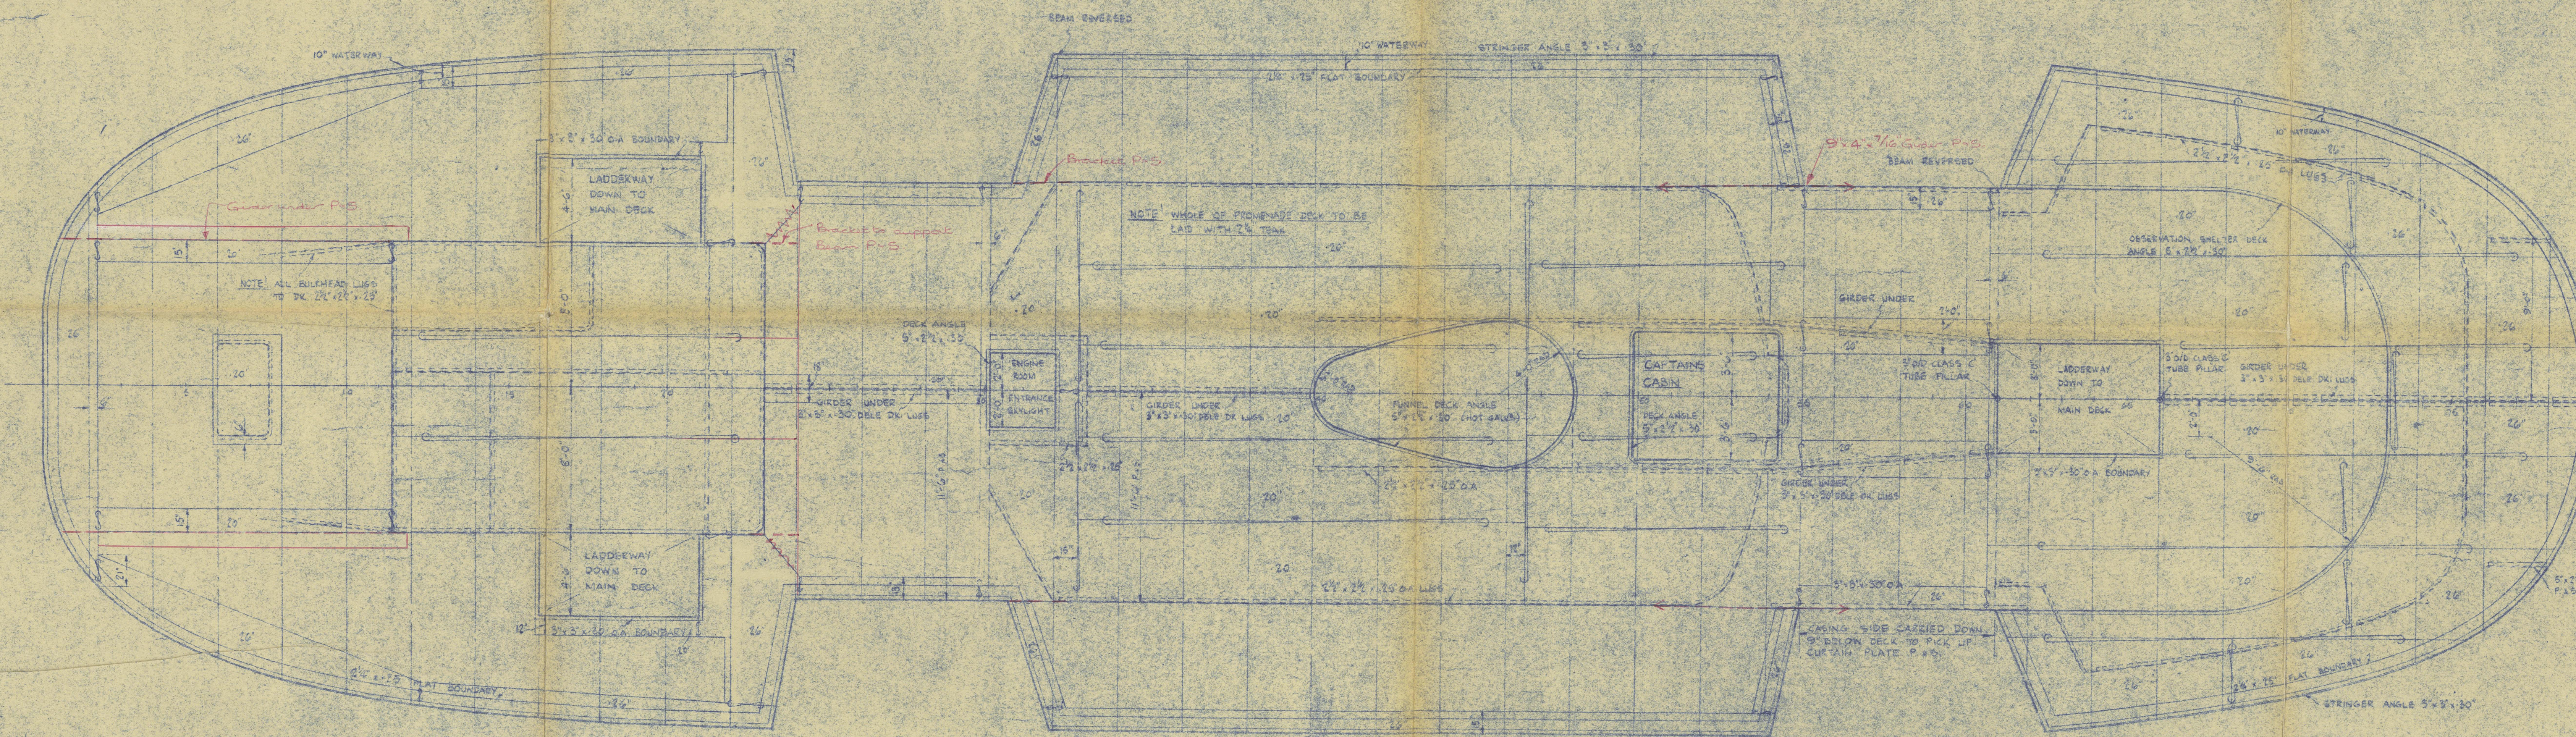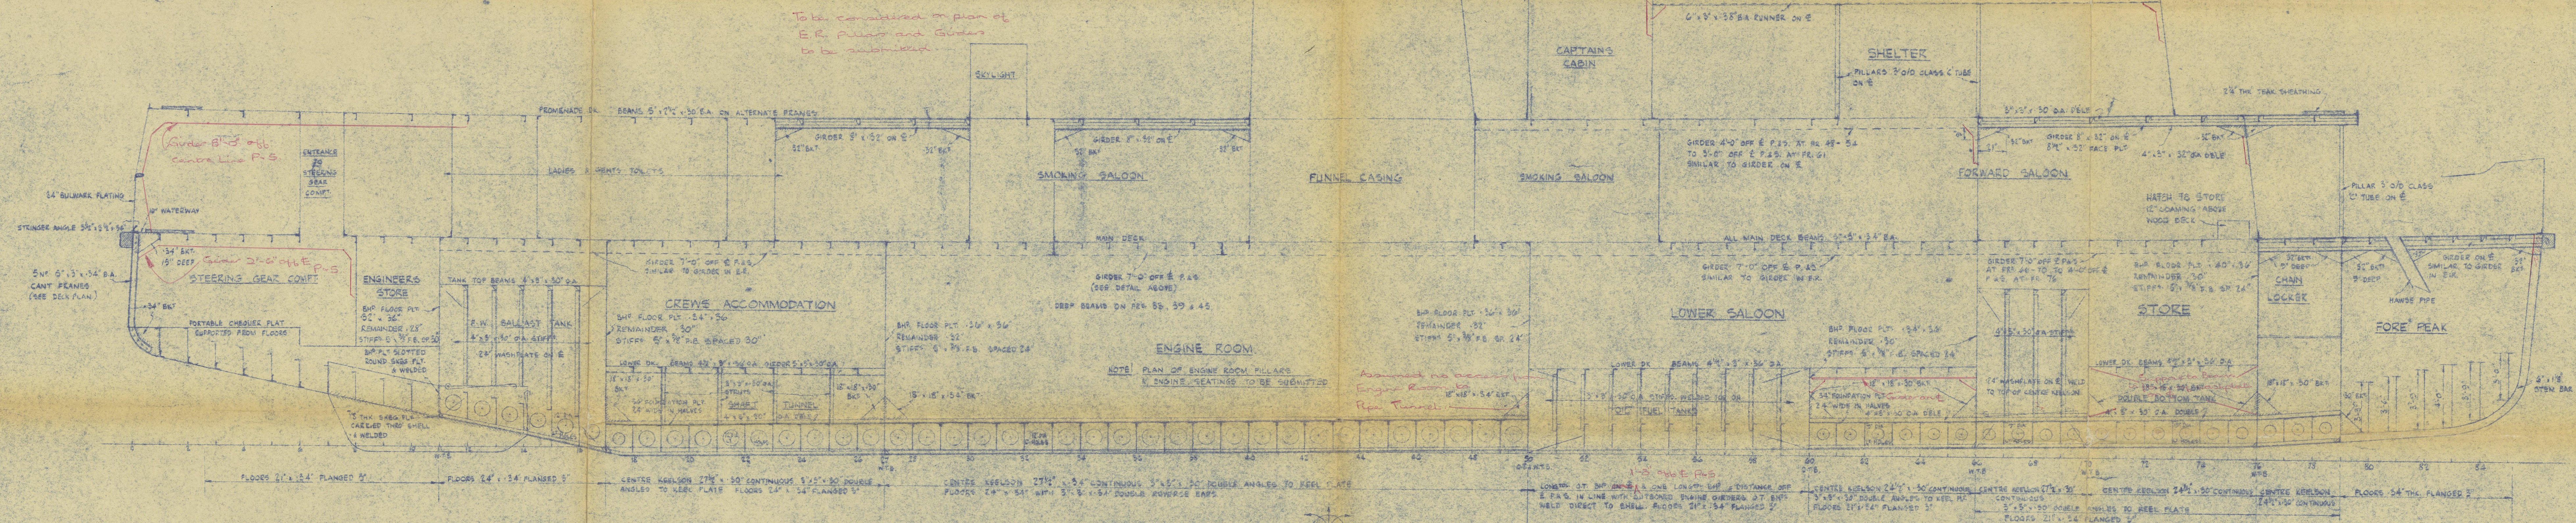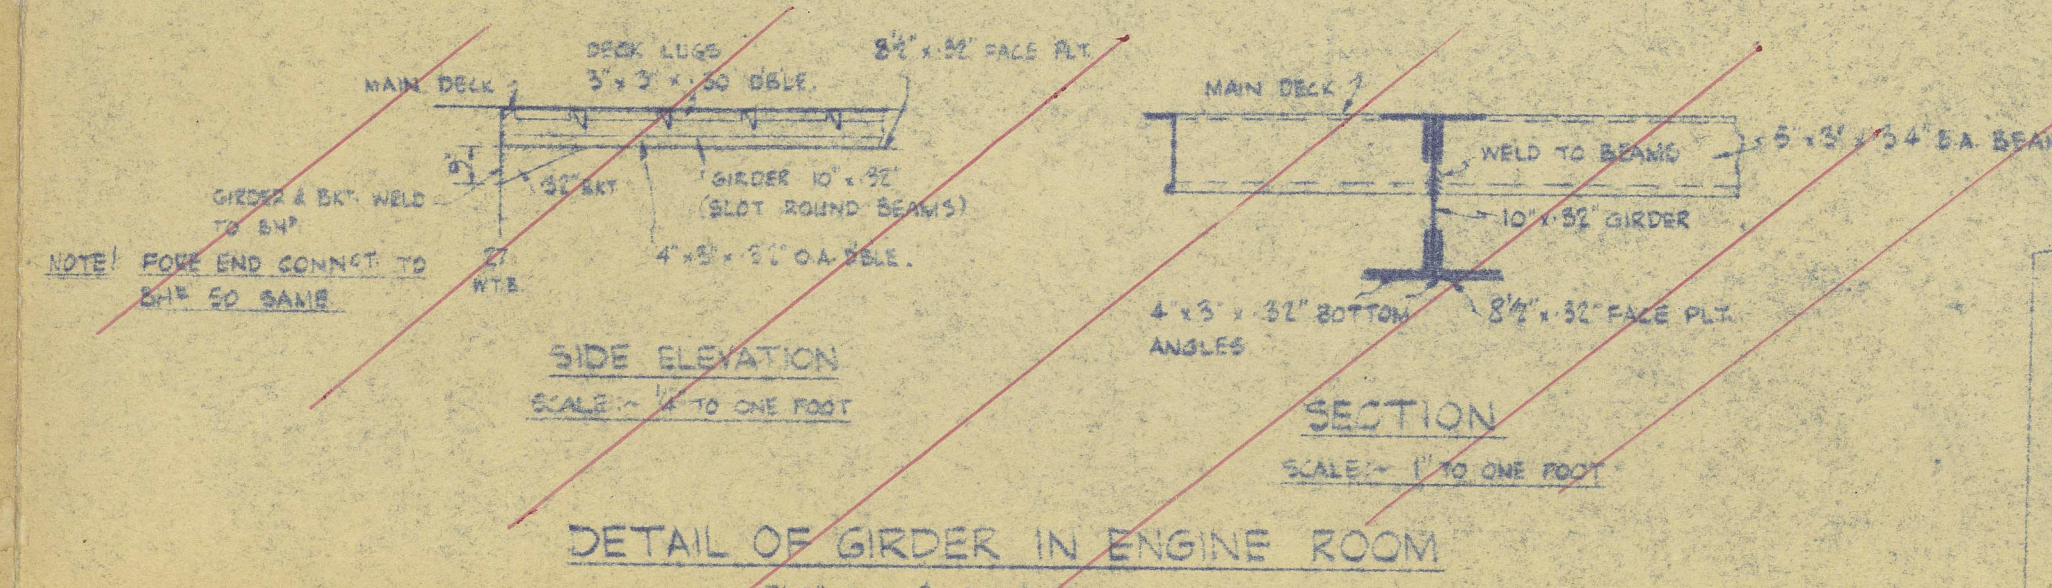

YARD NO 1304 & 1305

NOTE: ALL PROMENADE DECK BEAMS 5' x 2 1/2' x 30' 6A  
ON ALTERNATE FRAMES  
BEAM KESSES 12' x 1 1/2' x 30' 5' 6A EACH WAY

013027-013032-0022021



★  
ms. "MOUNTWOOD" & "WOODCHURCH"


Profile & decks.

2

RECORDS DEPT.  
LONDON.



© 2021

Lloyd's Register  
Foundation

013027-013032-0022