

# S.S. "KAULDI".

## STANDARD STEAMER TYPE C.


### MIDSHIP SECTION, AS BUILT.

SCALE  $\frac{1}{2}$ " = 1 FOOT.

DIMENSIONS 331' 0" B.P. x 46' 6" M.D. x 25' 6" M.D.

CLASS: 100.A.1. LLOYDS.

	POOP	F'CSLE.
SIDE PLATING	36	38
STRINGER PLATE	32 x 32	32 x 32
" ANGLE	3 x 3 x 32	3 x 3 x 32
DECK PLATING	25	30
BEAMS	7 x 3 x 36 BA	8 x 3 x 44 BA
BEAM KNEES	20 x 40	20 x 40
PILLARS	2 1/2	2 1/2

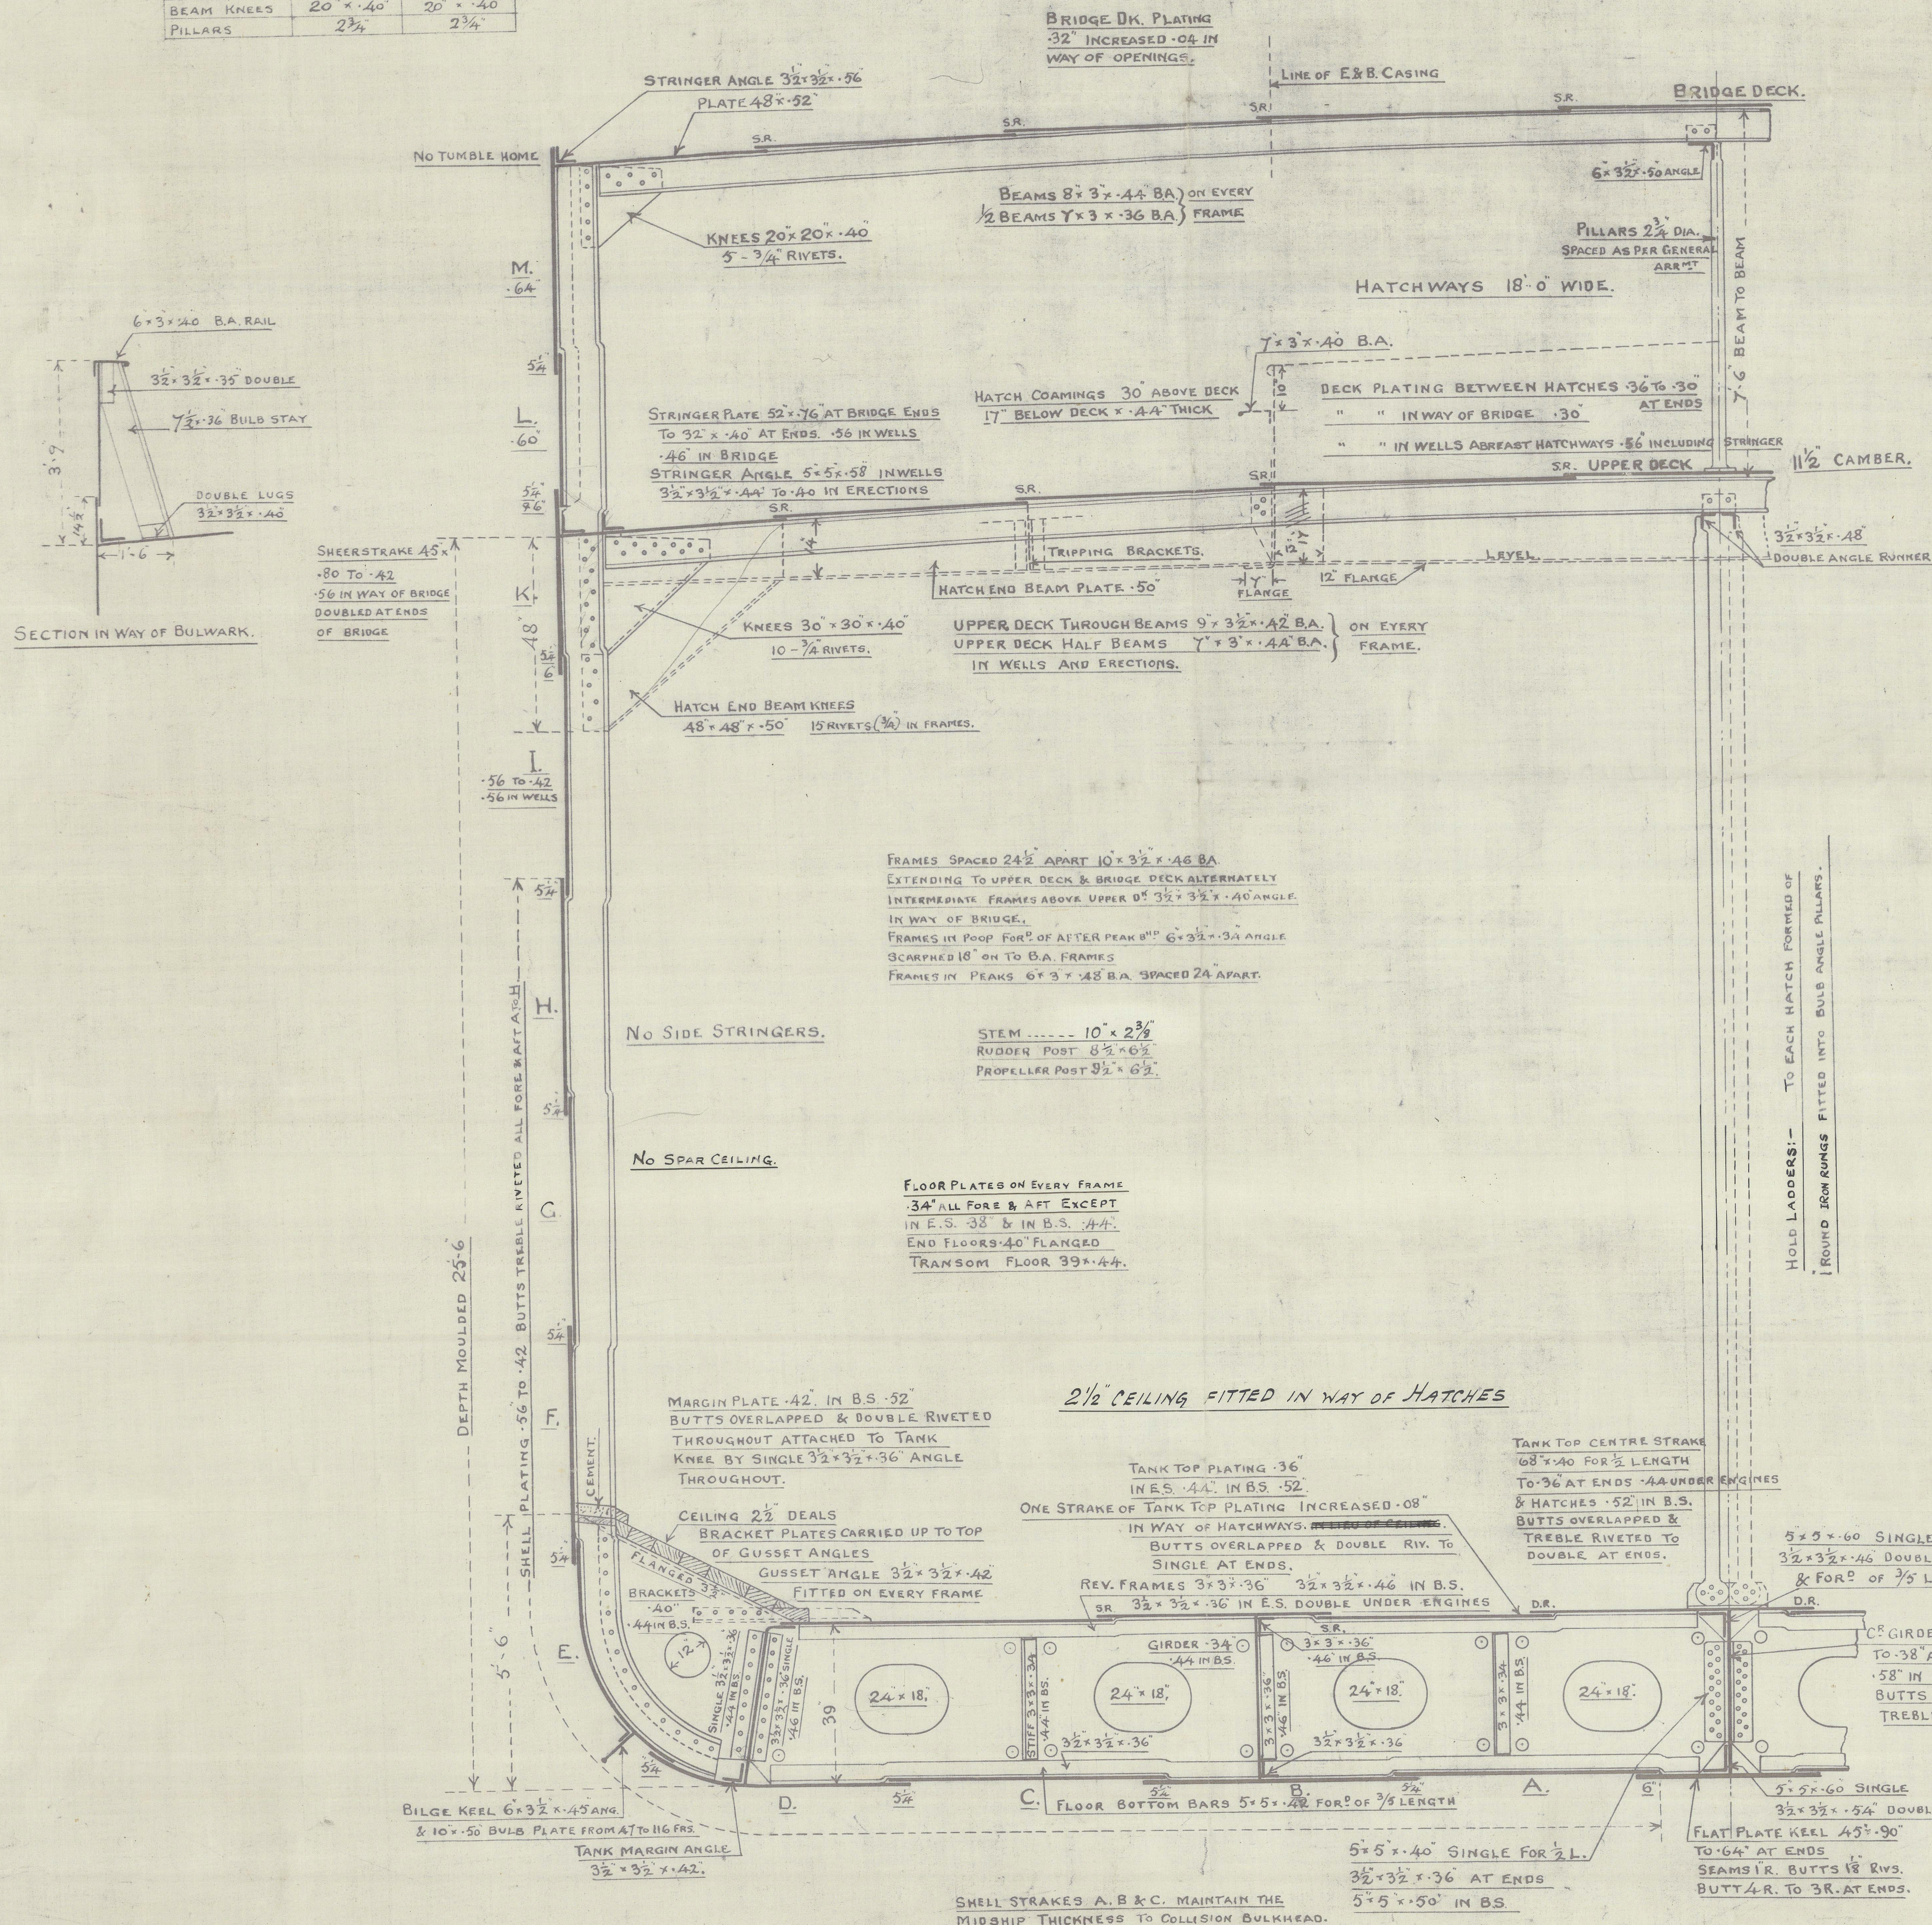

#### LLOYDS' NUMERALS.

MOULDED BREADTH (B)	= 46.5
DEPTH (D)	= 25.5
B + D	= 72.0 = 13' 0"
LENGTH (L)	= 331.0
L x (B + D)	= 23832.0 = 2ND NO.

#### PROPORTIONS.

LENGTHS TO DEPTH U.D.	= 12.98
L WITH INCREASED BRACKETS	= 21.75

SHEER FOR D	8'-6"	1/2 LEN. FOR D	4'-8"
AFT	4'-3"	1/2 AFT	2'-4"

#### EQUIPMENT NUMERALS.

L x (B + D)	= 331 x (46.5 + 25.5)	= 23832.00
-------------	-----------------------	------------

ERECTOR:-	
POOP	32.92
BRIDGE	92.00
F'CSLE	23.58
	159.50 x 7.5 x 75 = 897.19

#### CASINGS & HOUSES.

ENGINE CASING	29.46 x 7 x 5	103.11
SALOON HOUSE	26.54 x 7.5 x 75	149.29 252.40

EQUIPMENT NO.	= 24921.59
---------------	------------

#### EQUIPMENT.

2 BOWER ANCHORS	STOCKLESS	45 CWT.
1 " "	" "	38 "
1 STREAM ANCHOR	EX. STOCK	12 "
1 KEDGE	" "	5 1/2 "
210 FATHOMS	1/16" STUD CHAIN CABLE	
90 "	2" MANILLA	STREAM.
14 "	4" G.S.W.	
100 "	4" STEEL WIRE TOWLINE	

1-90 FMS	7" MANILLA HAWSER	& 1.90 FMS	2 1/2" STEEL WIRE
1 "	6 "	& 1.90 "	2 1/4 "





Midship Section. (As Built)

---

S.S. "KAULDI".  
NEWCASTLE ON TYNE.

Report No. 76363.

---

NN. VALENTINA FRIAS

N/N<sup>17</sup> "ARTAGAN"  
D/S 682



© 2021

Lloyd's Register  
Foundation

013033-013041-0176