

1.10.10

PLAN No. 9664  
FOR ENCLOSURE TO  
Messrs Lloyd's Surveyors  
Hull  
COCHRANE & SONS,  
SHIPBUILDERS, SEASIDE,  
DA. 28/9/10 R.R.

# MIDSHIP SECTION

STEEL SCREW TRAWLER

N<sup>o</sup> 479

DIM<sup>s</sup> - 130'-0" x 23'-6" EX. x 13'-3" M<sup>LD</sup>.

SCALE 1/2" = 1 FOOT.


TO BE CLASSED 100.A.1. AT LLOYD'S FOR FISHING PURPOSES

ENGINE & BOILER CASING AS PREVIOUSLY APPROVED.

DECK PLATED OVER IN WAY OF MACHINERY SPACE

**RIVETING**  
BUTTS OF SHELL PLATING LAPPED & DOUBLE RIV.  
EXCEPT GARBOARD & SHEERSTAKE WHICH ARE TO  
BE STRAPPED. LANDINGS DOUBLE RIV. BULKHEADS  
SINGLE RIV. BUTTS OF STRINGER & TIE PLATES  
OVERLAPPED & DOUBLE RIV.

10'-0" x { 4 1/2" x 3" x 7/16" ANGLES  
10" x 5/16" BULB PLATE.

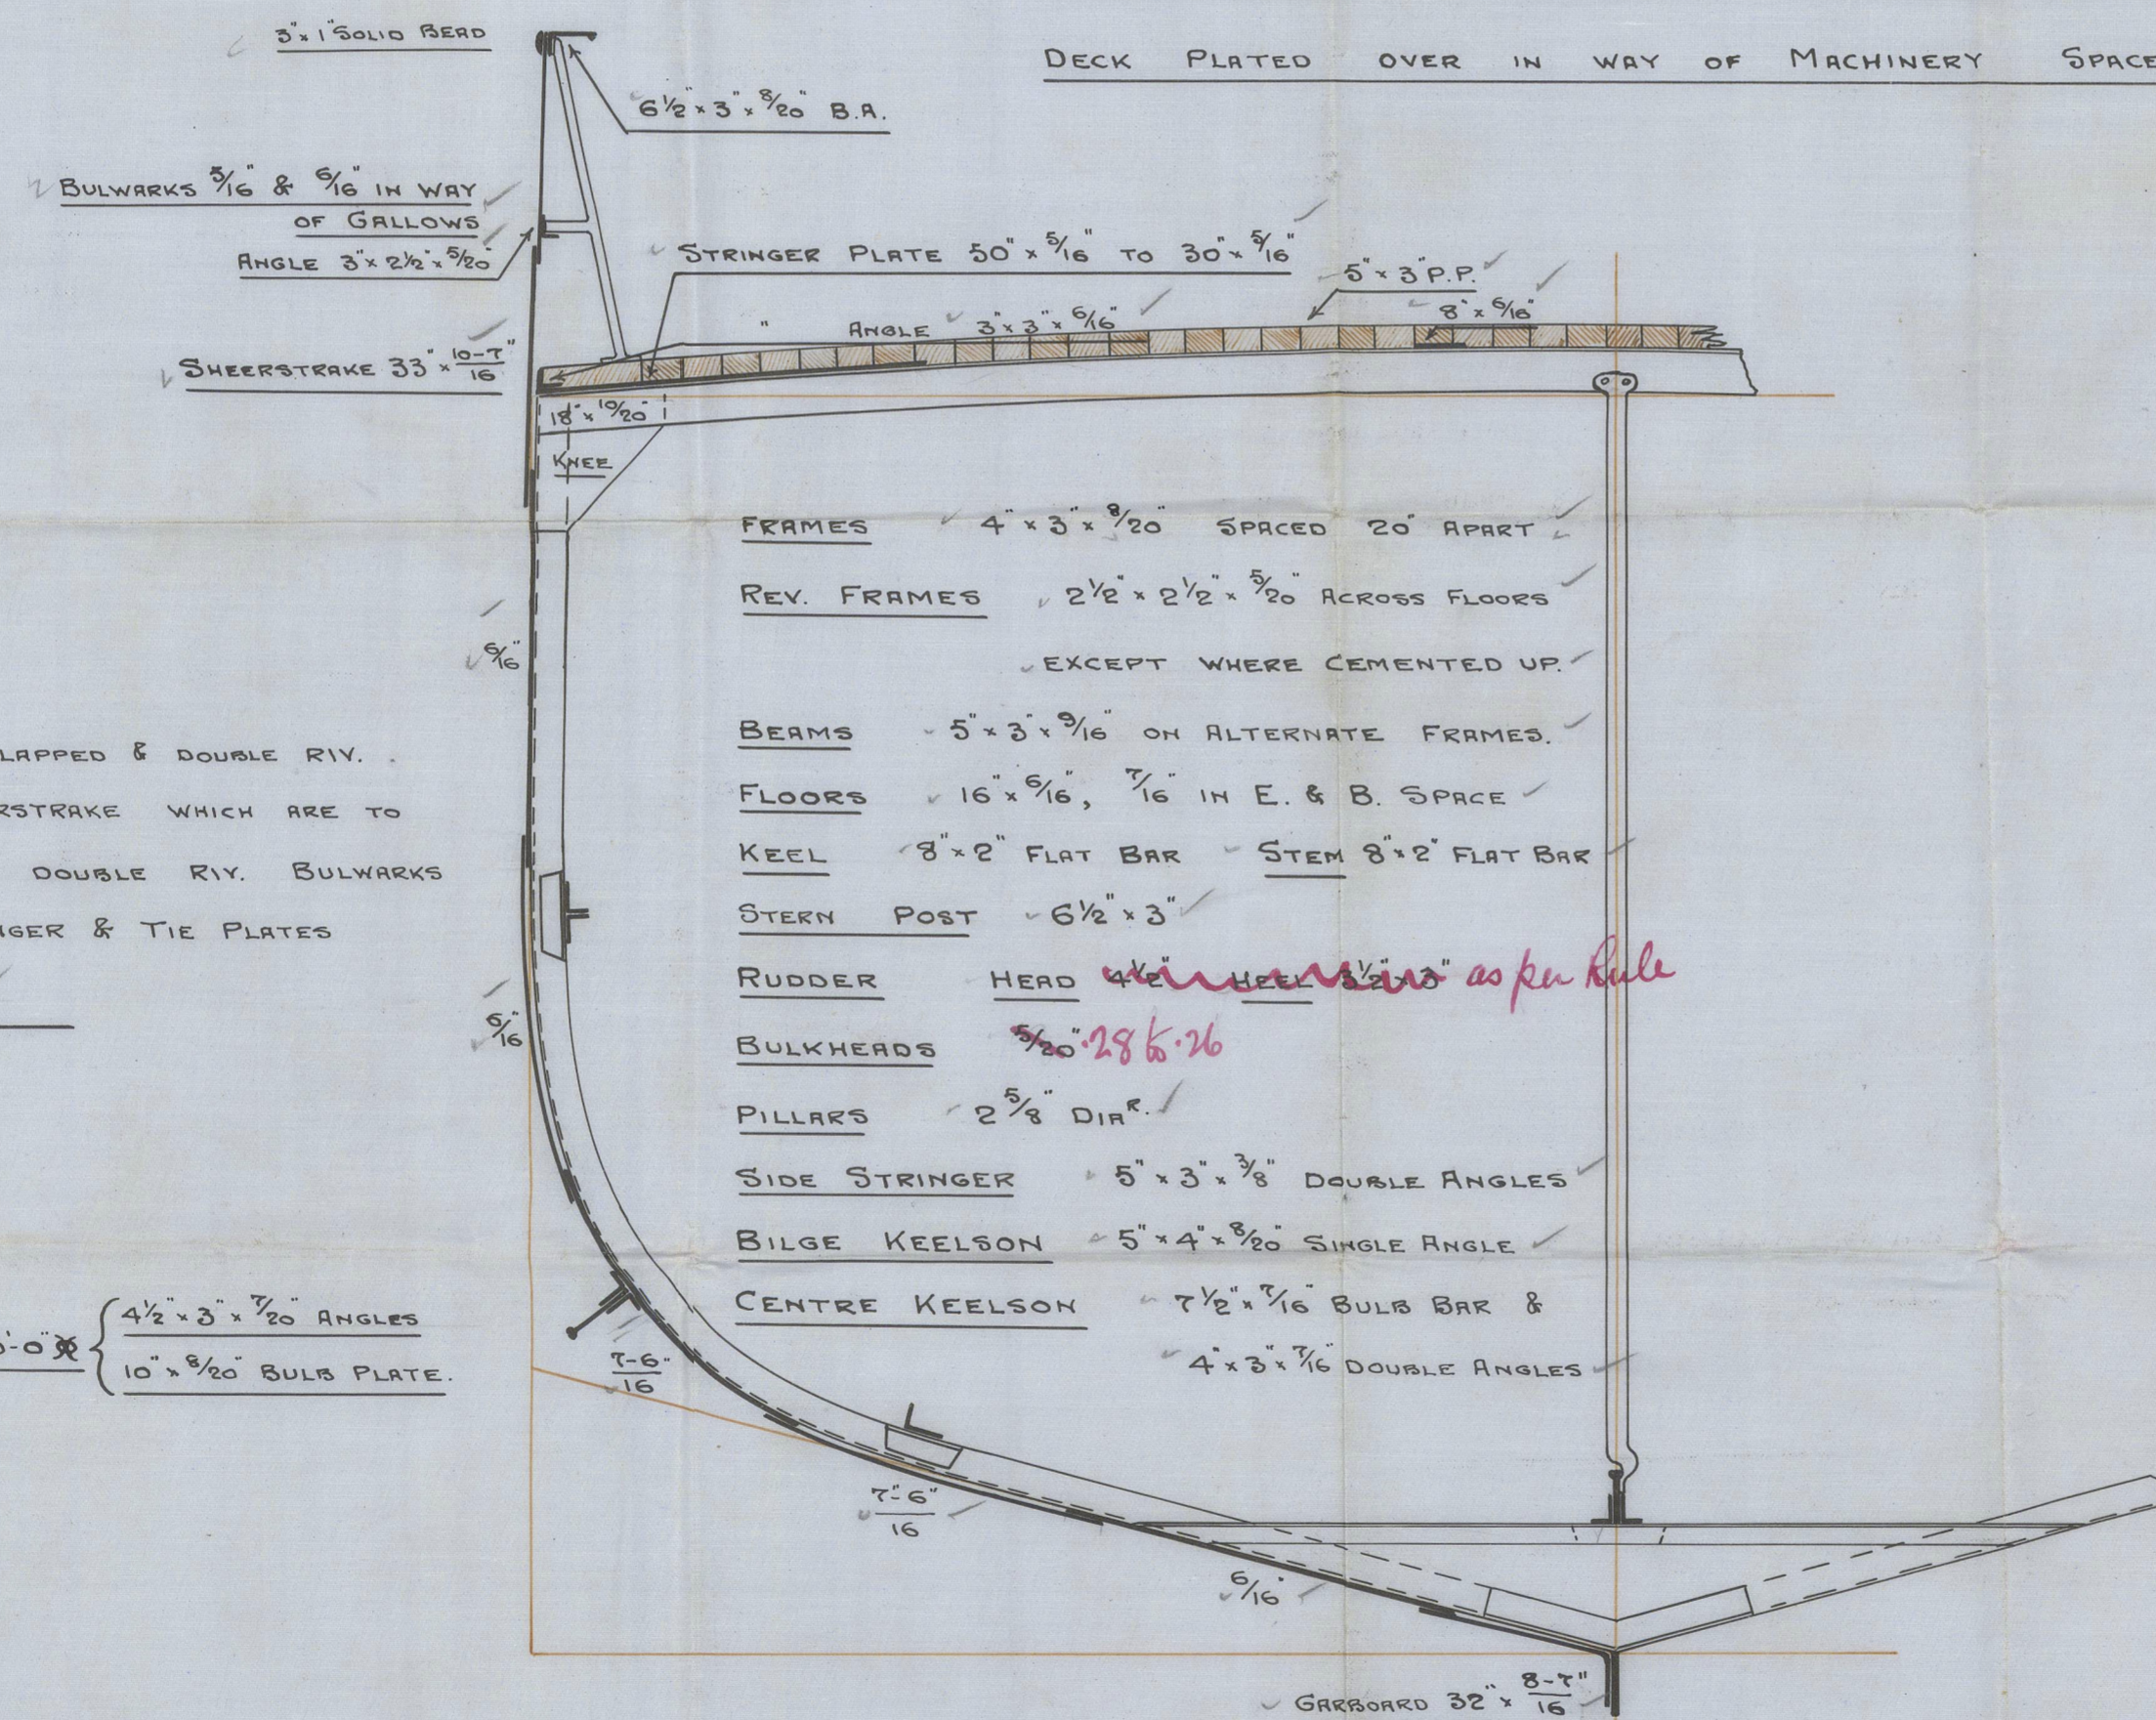

## LLOYD'S NUMERALS

|             |   |         |
|-------------|---|---------|
| D + B       | = | 36.62   |
| L x (D + B) | = | 4760.60 |

## PROPORTIONS

|      |   |     |
|------|---|-----|
| 1/10 | = | 5.5 |
| 1/10 | = | 9.8 |

## EQUIPMENT

|                              |         |               |
|------------------------------|---------|---------------|
| 1 <sup>ST</sup> BOWER ANCHOR | 5 3/4"  | CWTS EX STOCK |
| 2 <sup>ND</sup> "            | 5 1/4"  | "             |
| 3 <sup>RD</sup> "            | 3       | "             |
| 105 FATHOMS                  | 1 1/16" | CABLE         |
| 60 "                         | 6"      | HAWSER        |
| 60 "                         | 5"      | WARP          |

C.B.  
1.10.10.

1/2" = 1 FOOT

NOTED  
COCHRANE & SONS  
SHIPBUILDERS  
SEASIDE  
MIDSHIP SECTION

MIDSHIP SECTION -  
COCHRANE & SONS

No 449

s/s Phoebe's  
Hull Report No.



© 2021

013042-013051-0059

Lloyd's Register  
Foundation

5/4

01/11/85