


## PROFILE & DECK PLAN

N<sup>o</sup>. 479

DIM<sup>NS.</sup> 130'-0" B.P. x 23'-6" EX. x 13'-3" DEPTH M<sup>LO.</sup>

SCALE  $\frac{1}{4}'' = 1 \text{ FOOT}$

PLAN No 9663  
FOR ENCLOSURE TO  
Messrs Lloyd's Surveyors  
Hull  
COCHRANE & SONS,  
SHIPBUILDERS, SELE  
DATE 28/9/10 R.R.

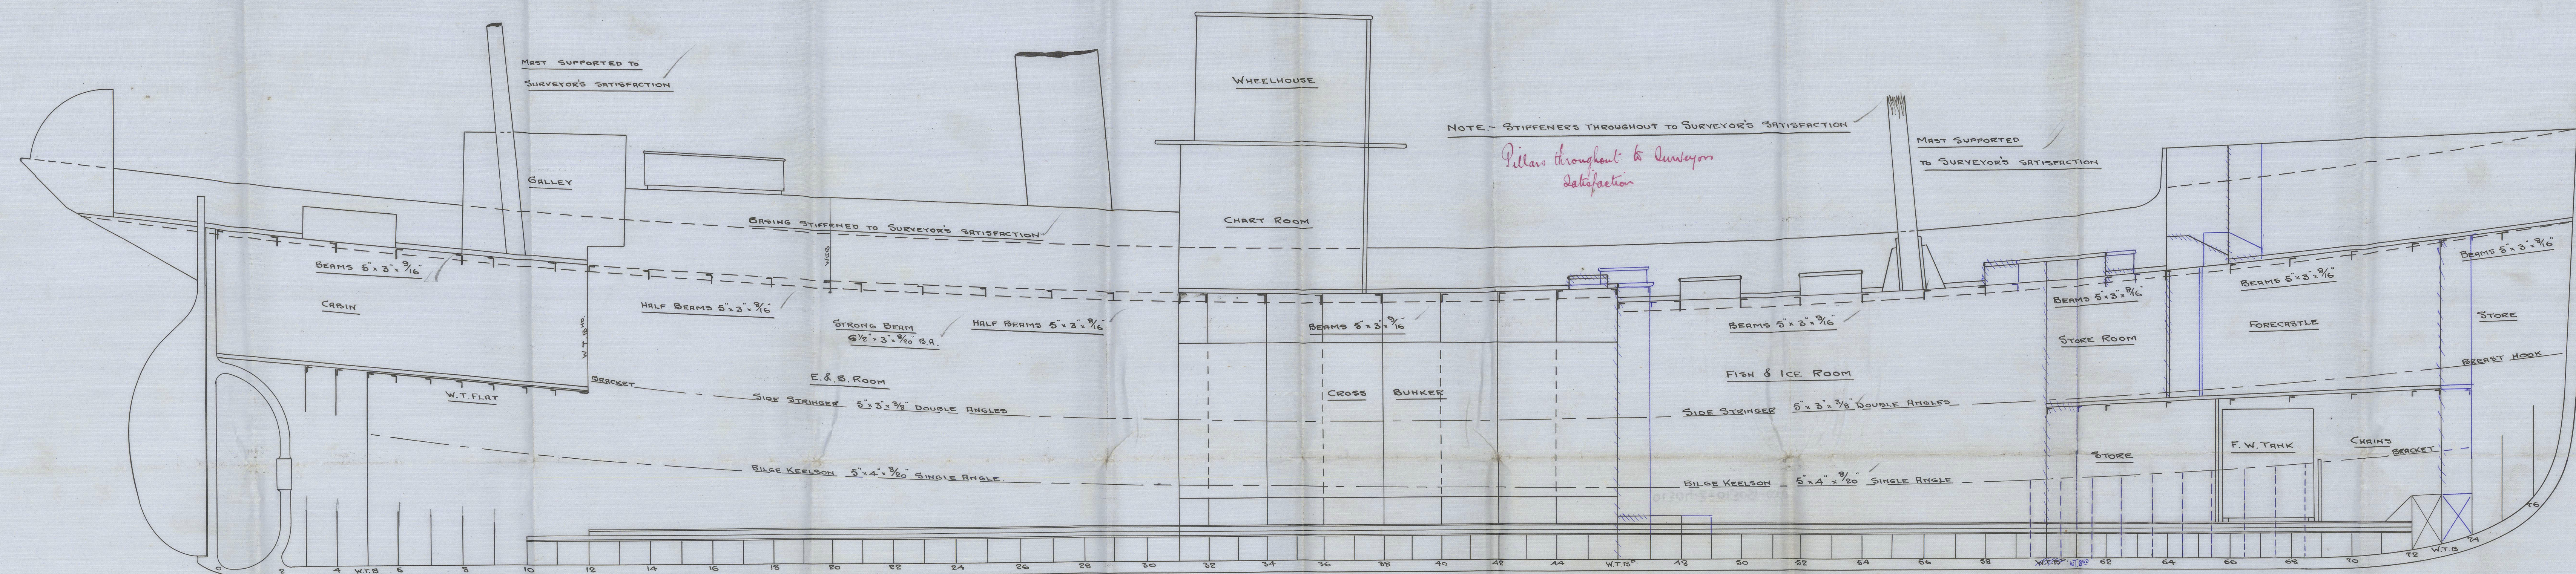

NO H/d





-PROFILE & DECK PLAN-  
COCHRANE & SONS

No 479

s/s Phronis

Hull Rpt. No. 23602



© 2021

Lloyd's Register  
Foundation

013042-013051-0060  
BIRCH KEELESON