


9632.

4-3-20

N^o 1343.
 STEEL MOTOR BARGE
 IRONWORK ARRANGEMENT.
 SCALE $\frac{1}{4}$ " = 1 FOOT.
 DRAWING N^o 9632.

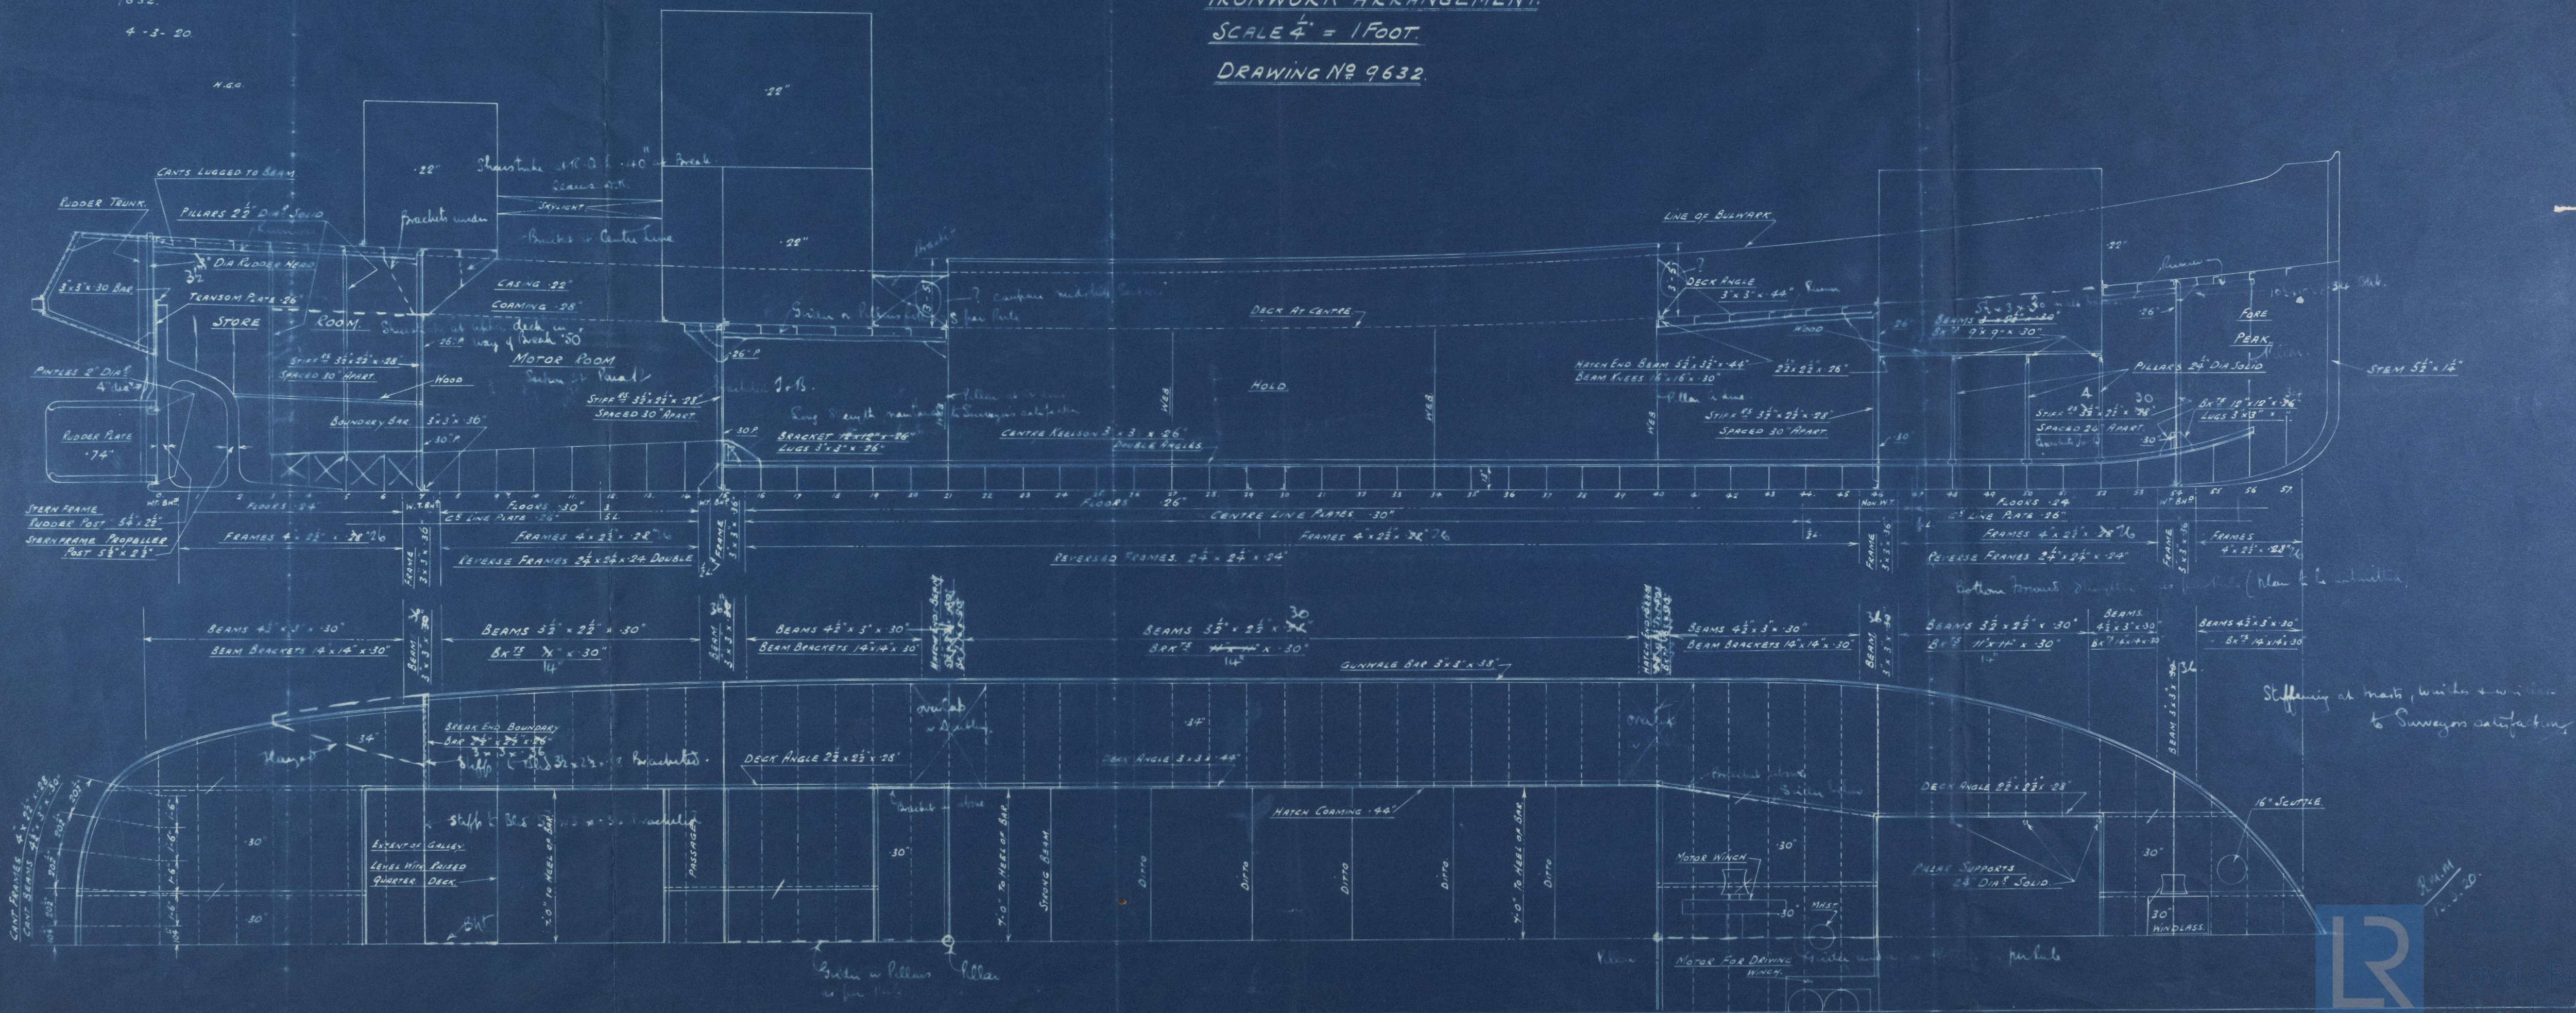

R
 10-3-20

Lloyd's Register
 Foundation

Rennie Forrest 134 3

Profile

~~Gen Box 5105~~

El Mico

San 8492.



© 2021

Lloyd's Register
Foundation

013057-013062-0085