


13/11/08

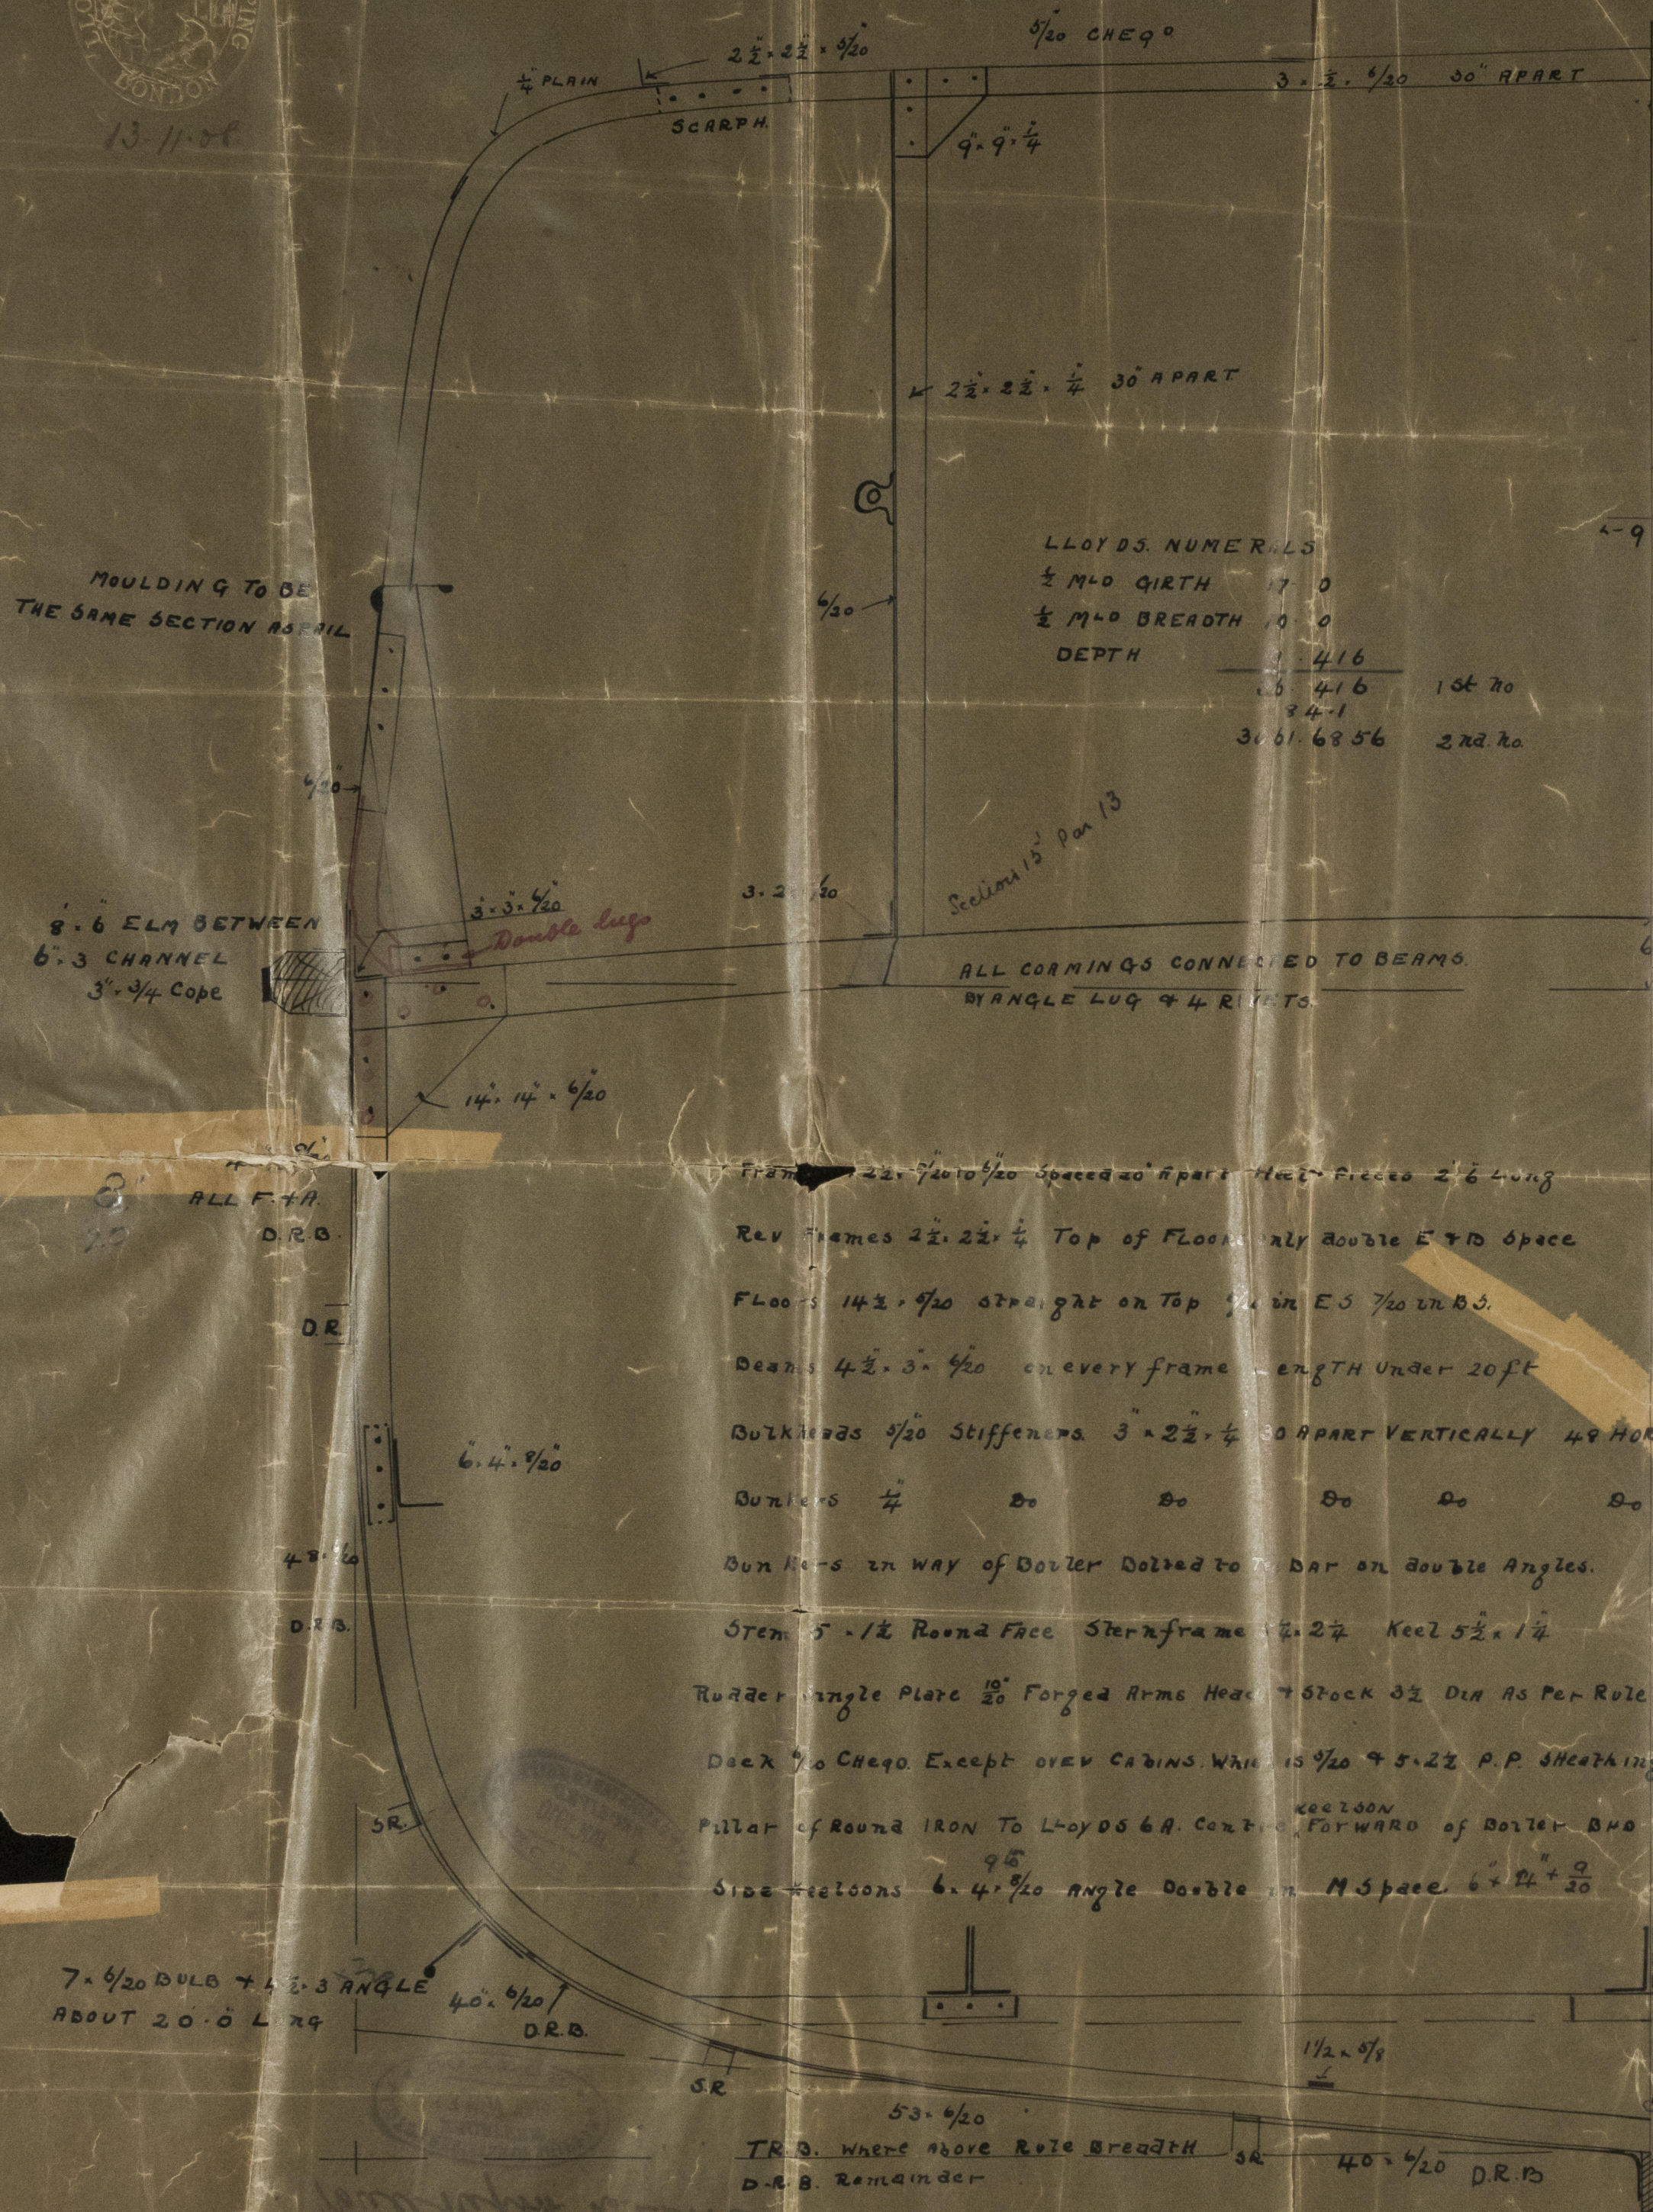


STEEL SCREW TUG

85.0 BP 20.0 MLD 9.0 MLD

SCALE 1" = 1 FOOT

TO CLASS LLOYD'S 100A1 TOWING PURPOSES.

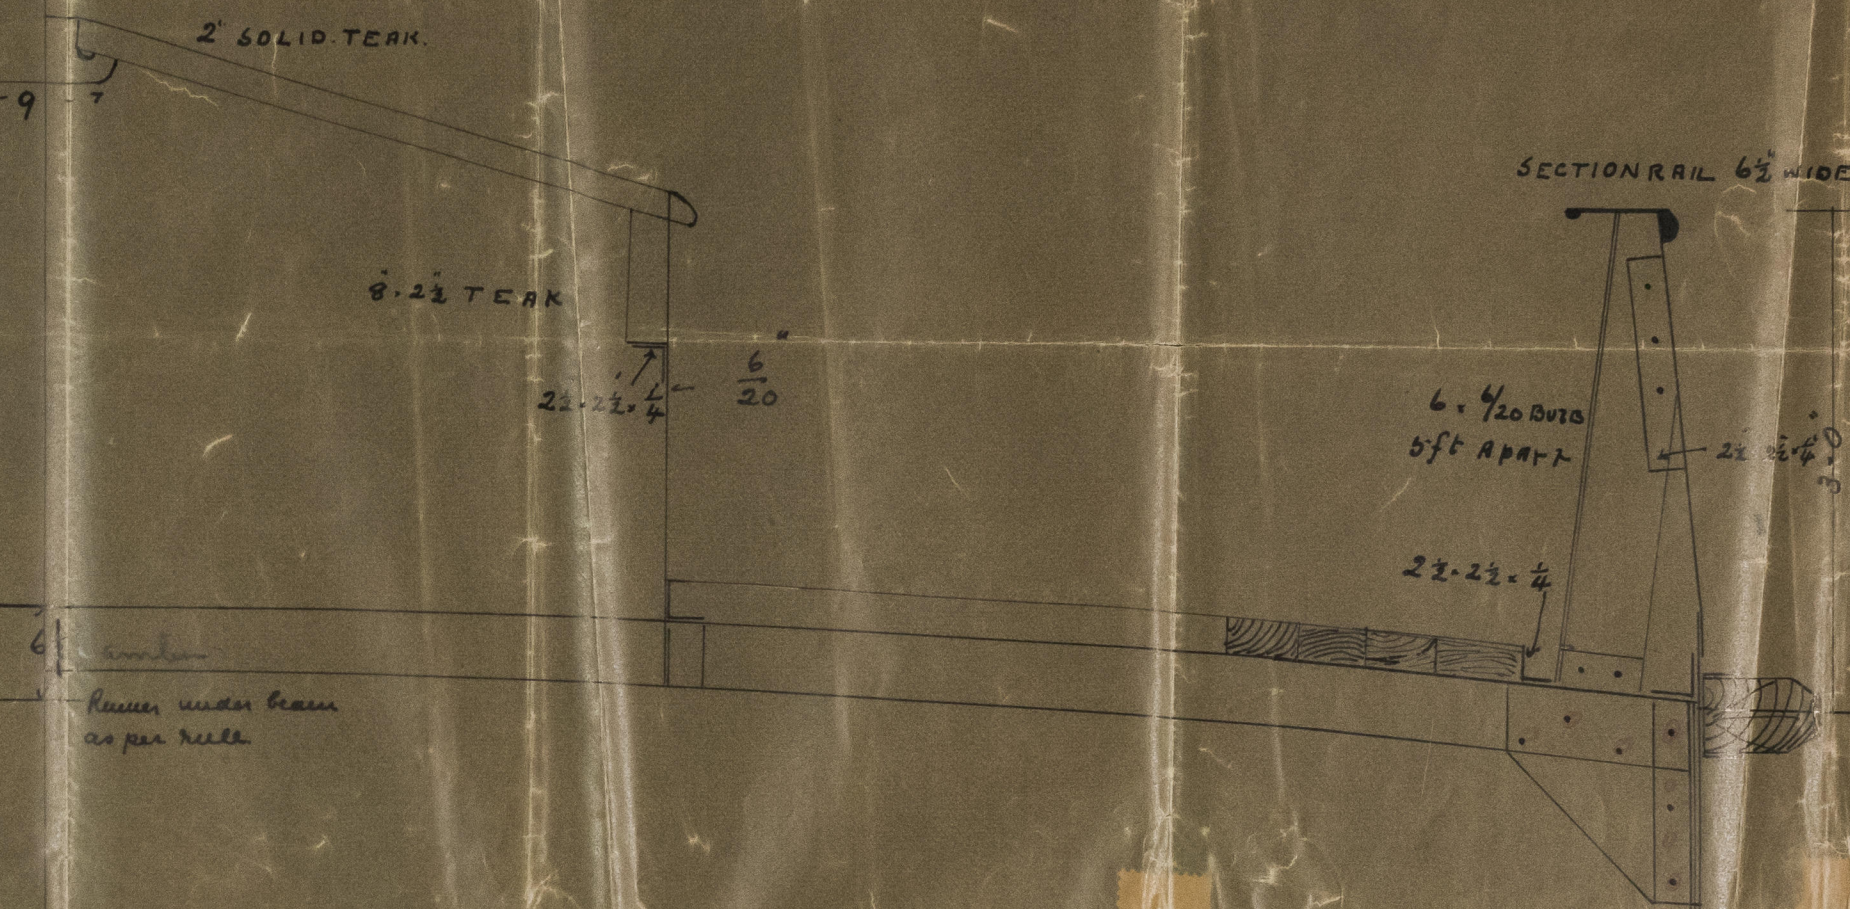

RIVETTING

TO LLOYD'S REQUIREMENTS
ALL PLATING TO HAVE INSIDE BUTT JOINTS
ALL OUTSIDE WORK COUNTER DRILL
EQUIPMENT
TWO 4 1/2 CWT STOCKLESS ANCHORS
ONE 2 " KEDGE EX STOCK
60 FATHOM 1 1/2" STUD CHAIN CABLE
60 " 5 1/2" HAWSER MANILA
60 " 3

Joseph P. P. v. L.
12/11/08

13/11/08


J. Dean & Son
No 259.

Amended

Midship Section.

s/s Concorde

Hull Report No. 22116

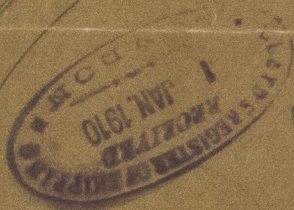

© 2021

Lloyd's Register
Foundation