

13.11.08



Pillars throughout to surveyors satisfaction

C.B.
13.11.08

AMENDED

S.T. 850 x 20-0 x 8-6 Hold

SCALE $\frac{3}{8}$ = 1 Foot

TO CLASS 100 A-1 LLOYDS



© 2021 Lloyd's Register Foundation

J. Lewis & Son
10 Gt St 100 H 1 Gt St

No 259.


20875 38 1000
amended

Profile & Deck Plan.

R.L. 82 0 50 0 8

J. Conson
WENDED

Hull Report No 22116.

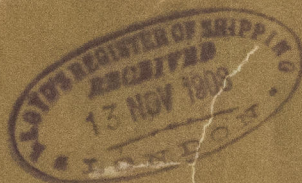

© 2021

Lloyd's Register
Foundation

[Faint handwritten notes, possibly 'Hull Report No 22116' and 'amended']

[Faint handwritten notes at the bottom left corner]