


BUTTS OF SIMMERER ALL F&A TO BE DOUBLE RIVETED.
BUTTS AND SEAMS OF DECK PLATING IN WAY OF OIL FUEL
TANKS TO BE DOUBLE RIVETED.
BUTTS AND SEAMS OF DECK PLATING ELSEWHERE
BE SINGLE RIVETED.

May 10.

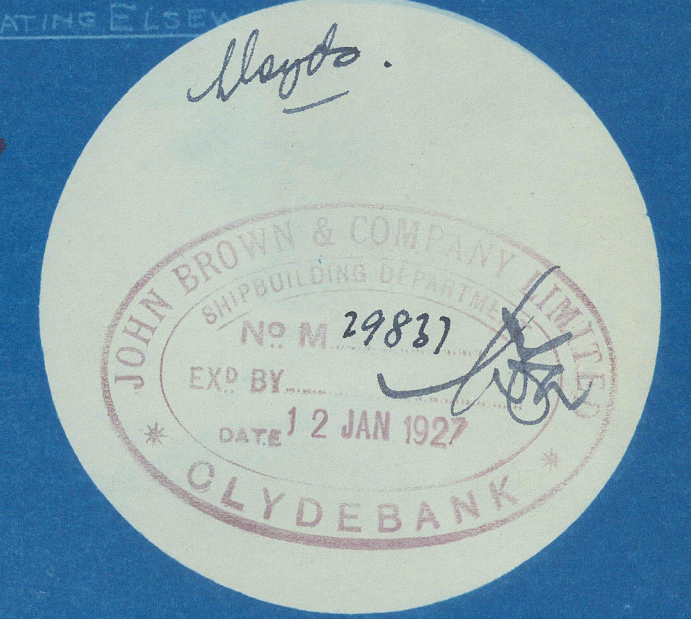

Main & Aloft Decks

Main & Aloft Decks

82020

John Brown & Co. Ltd

Timers Elaine

GLASGOW REPORT No

47659

47659



© 2021

Lloyd's Register
Foundation

013115-013124-0140