

SCALE 1/8" = 1'-0"

## - POOF DECK



BURMEISTER  
& WAIN  
COPENHAGEN.

5/R1.


Rio Ignazu  
NEWB. No. 355.

M/S. "BRETAGNE"

| Longitudinal Section  
& Decks.  
as built.

Copenhagen Report No. 7327

(Interested: Burm & Wain  
No 353. M/S. "IRLAND")  
Chr. Rep. 7605.

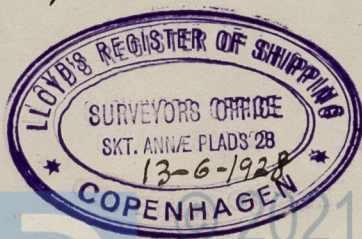

Lloyd's Register  
Foundation

013151-013160-0285