

"DUE GOLF"


D/S 644

Burmeister & Wain
Copenhagen

Newbuilding No 341-42

Midship Section

Duplicate

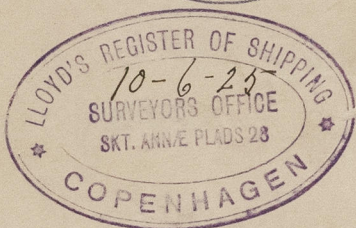

No 341: M/S. MOMBA, 3020 Tons,
of Sydney.

Copenhagen Report No. 7214
18-3-26.

No 342: M/S. MUNDOO, 3018 Tons,
of Sydney.

Copenhagen Report No. 7223
8-4-26.

© 2021

013161 - 013167 - 0023

Lloyd's Register
Foundation

Boggen N^o 341 Middelspant.



© 2021

Lloyd's Register
Foundation

2020-191310-013167-0023