

# No 108-9 PROFILE & DECK PLANS

DIMENSIONS 200' B.P. x 33' BREADTH M<sup>o</sup> 20'6" TO SHELTER D<sup>m</sup> 13'6" TO UPPER D<sup>m</sup>

TO CLASS B.S. & BRITISH CORPORATION Scale 1/8" = 1 foot



No 7  
10/2/20





FOR PROFILE

SEE AMENDED PLANS 11-9-20

12 FEB 1920

all.  
ans.

Approved  
See letter 18-2-20

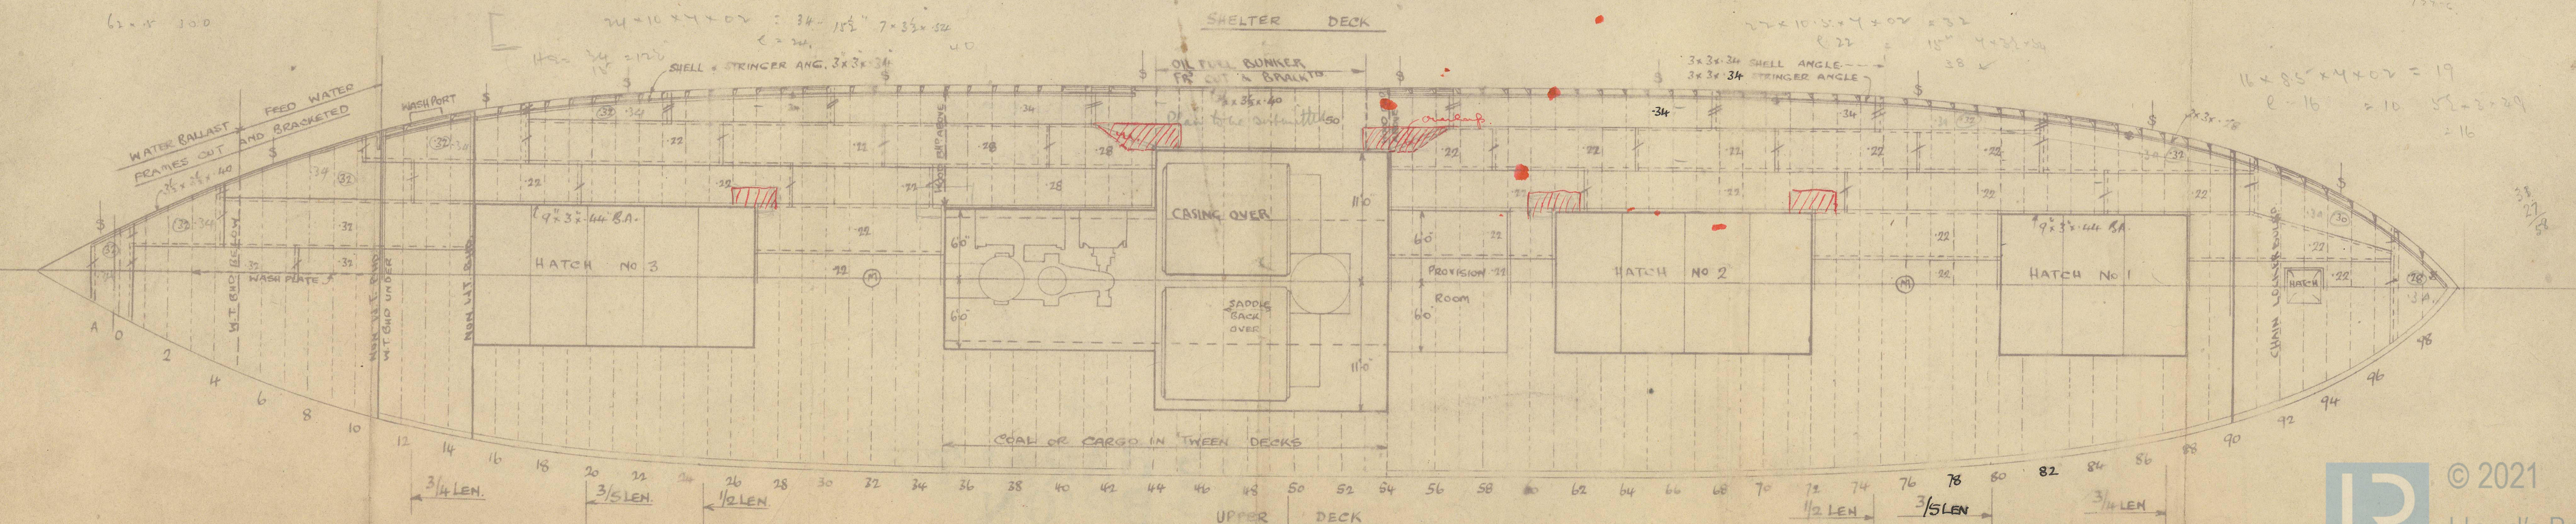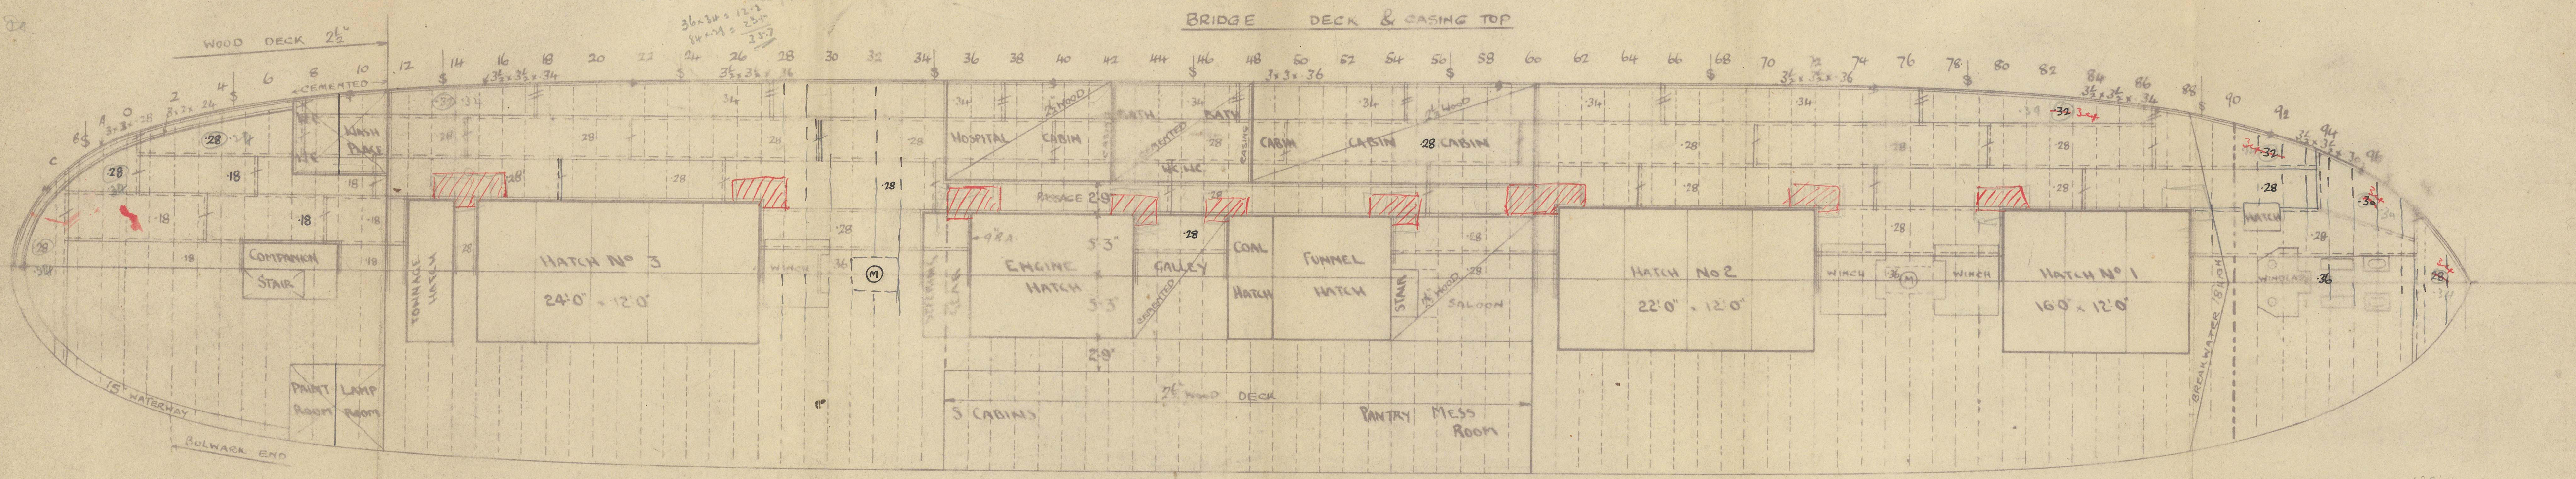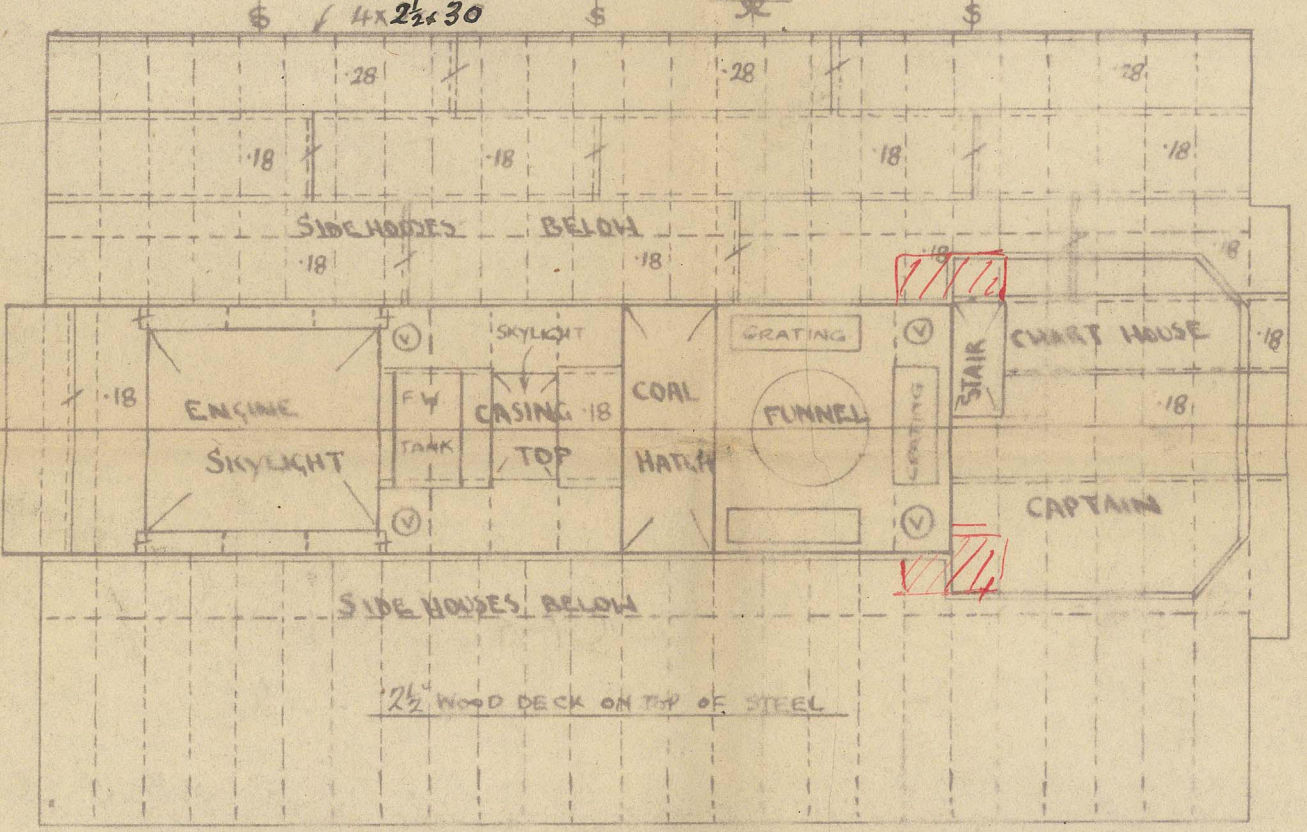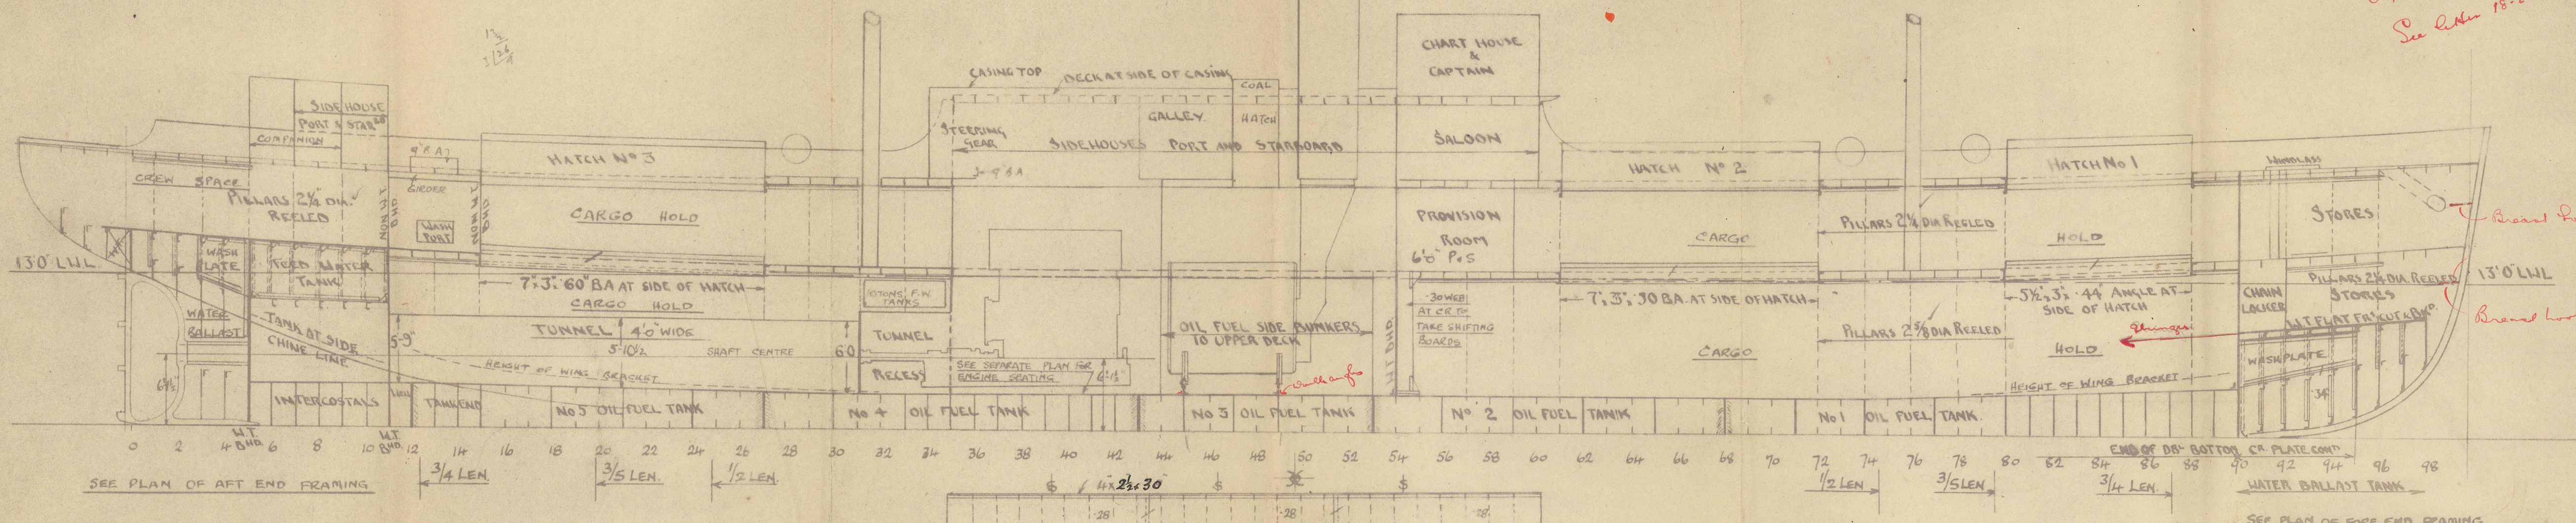



Coaster Con Coy

108-109

Profile + decks

12 FEB 1920

013179-013185-0005

Bay.

See later plan 13

Coaster Construction Co.

108-109

Tc. 25-1-20

Profile + decks

200 x 33 x 13.6

4

SS  
SS

BARALT  
BRION

© 2021 18. 2 20

Lloyd's Register  
Foundation