



No. 7  

TO CLASS B.S. & BRITISH CORPORATION Scale 1/8" = 1 Foot

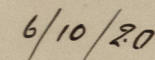

PRULITE & DEAN 92AD9 10801 P/801

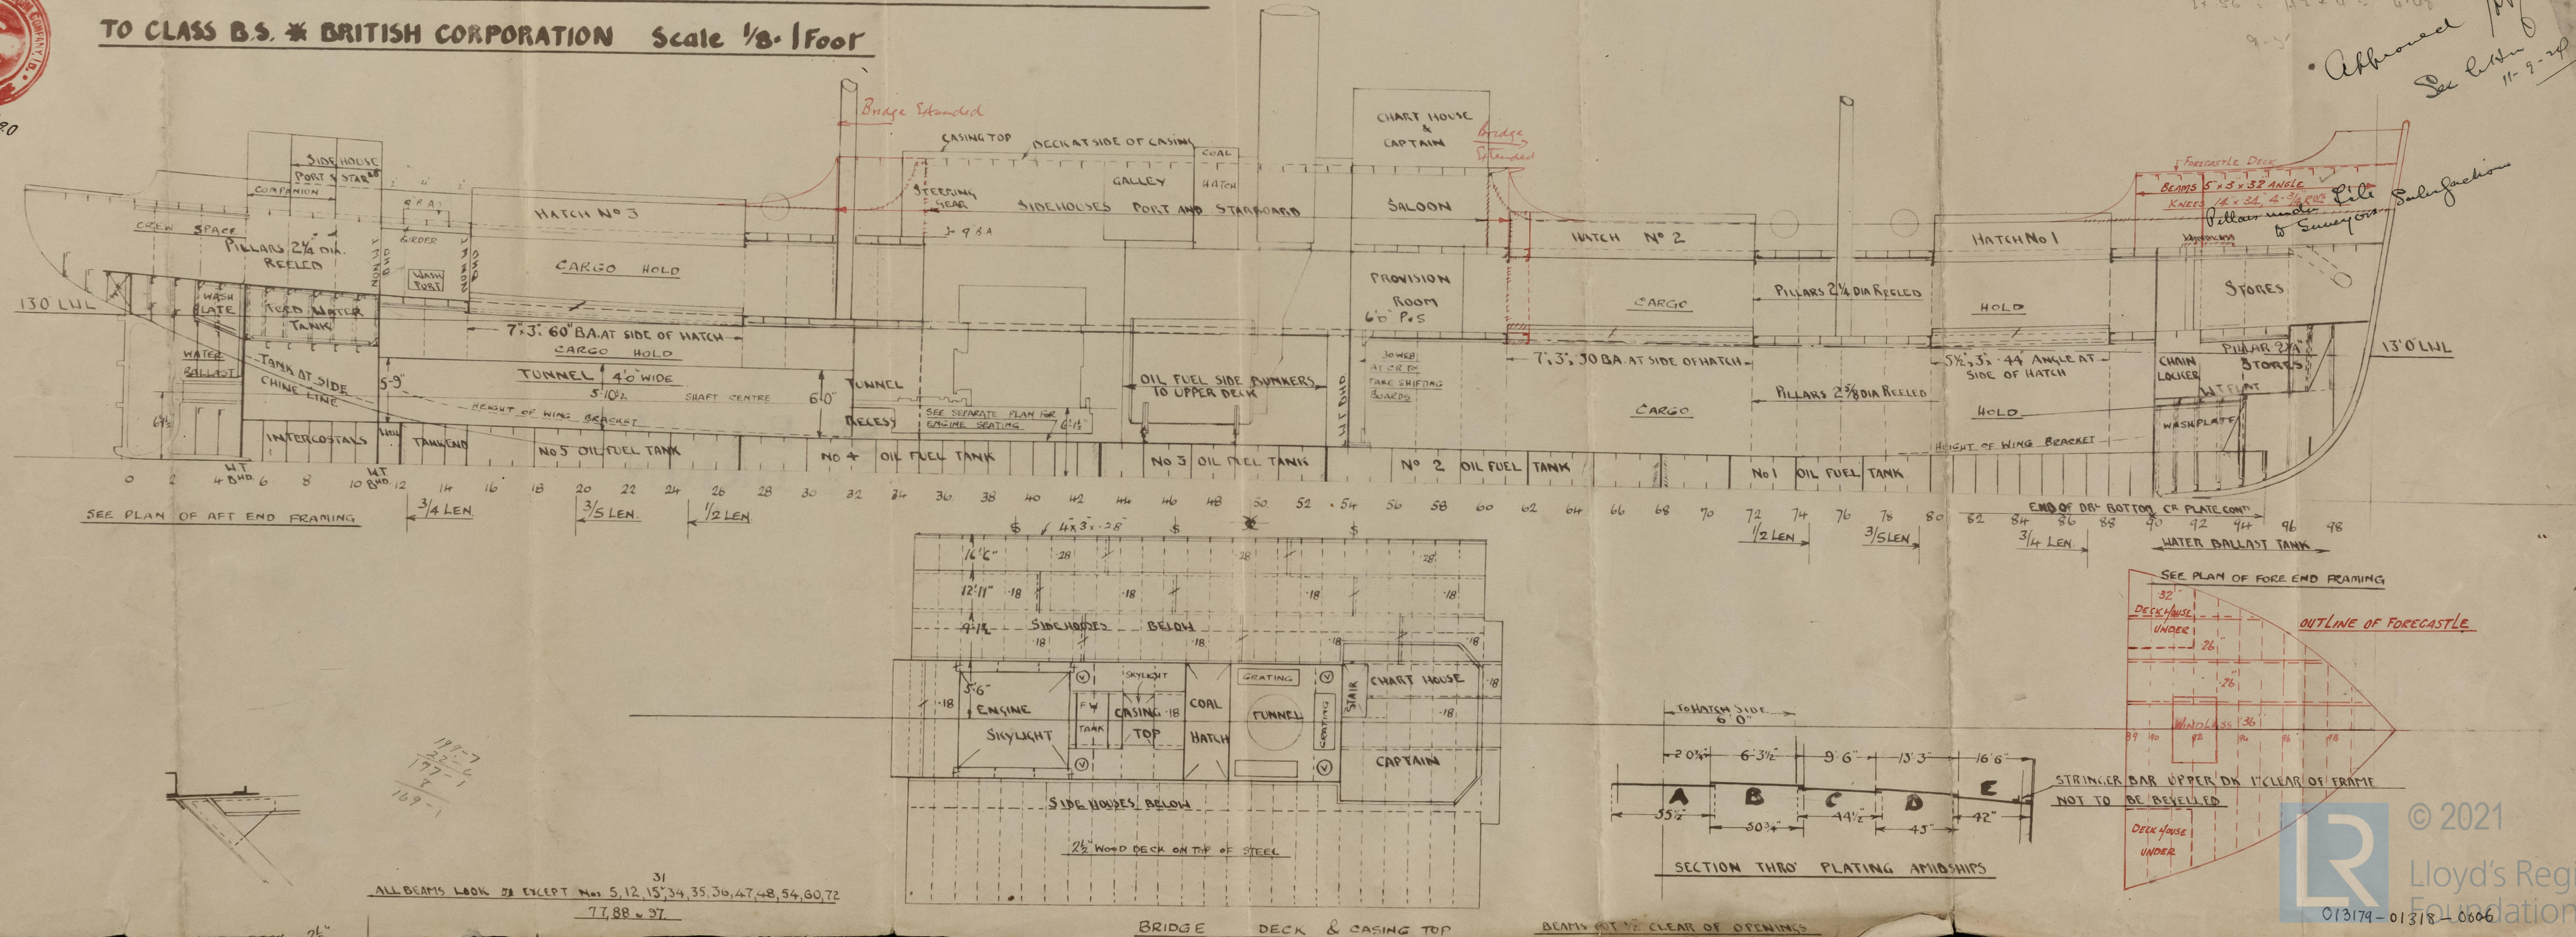

© 2021  
Lloyd's Register  
Foundation  
013179-01318-0006



Coaster Const Co

108/9

Am profile & decks

Bag

013179-013185-0006

PANAGHIA

SS BARALT\*  
SS BRION

Coaster Const Co

N<sup>o</sup> 108 - 109

Amend profile & decks

11. 10. 20



13.

© 2021

Lloyd's Register  
Foundation