
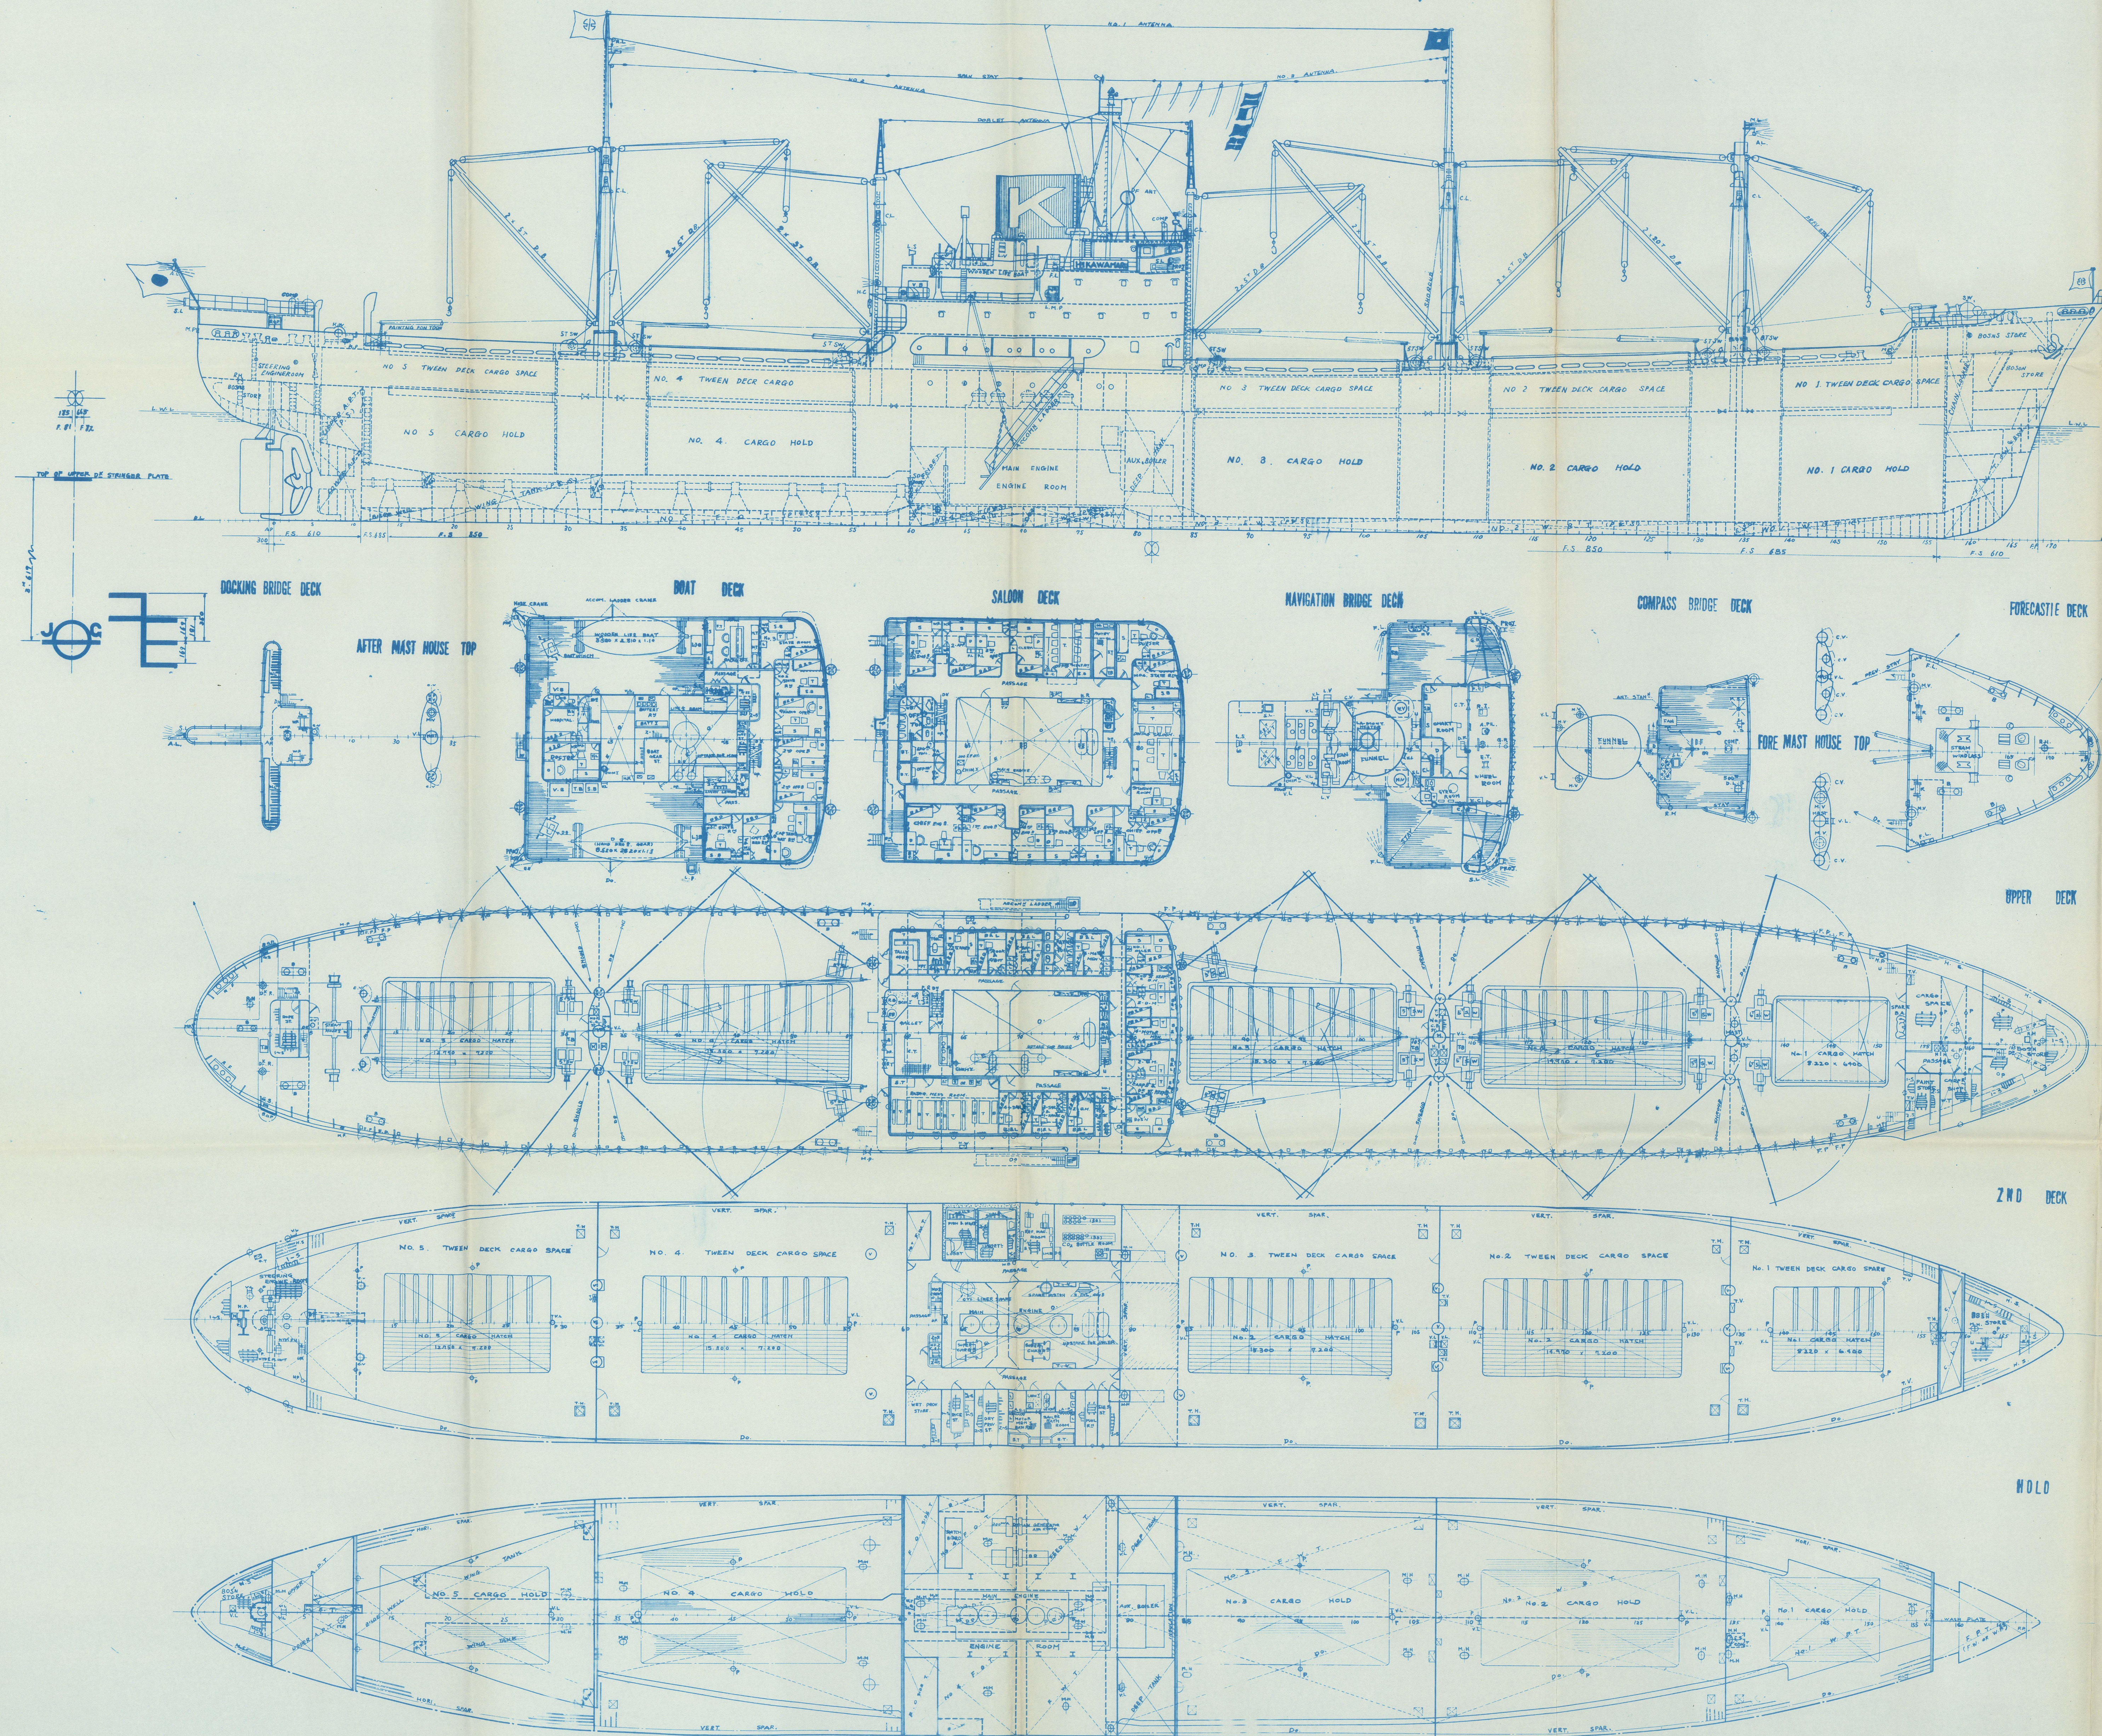


M.S. HIKAWA MARU.

# GENERAL ARRANGEMENT

SCALE  $\frac{1}{200}$

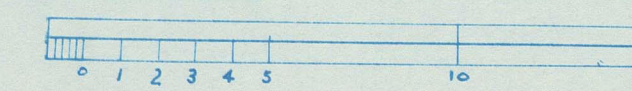

## PRINCIPAL PARTICULARS:

L.P.P.	132'40
B. M.D.	18'20
D. M.D.	11'70
d. EXTREME	8'138
G.T.	8092.32
N.T.	5600.79
D.W.	10881.056
Δ	14922'00
TRIAL SPEED	17.637

## CLASS


L.R.S. \* 100A1, \* L.M.C.  
N.K.K. N.S \* MNS \*

## COMPLEMENT

DECK DEPARTMENT	
CAPTAIN	1
CHIEF OFFICER	1
2ND OFFICER	1
3RD OFFICER	1
APPRENTICE	1
BOATSWAIN	1
CARPENTER	1
DECK STORE KEEPER	1
QUARTER MASTERS	4
SAILORS	7
SPARE	1
ENGINE DEPARTMENT	
CHIEF ENGINEER	1
1ST ENGINEER	1
2ND ENGINEER	1
JUNIOR 2ND ENGINEER	1
3RD ENGINEER	1
APPRENTICE	1
NO. 1 OILER	1
ENGINE STORE KEEPER	1
DONKEY MEN	3
MOTOR MEN	8
SPARE	1
PURSER DEPARTMENT	
CHIEF RADIO OPERATOR	1
PURSER	1
DOCTOR	1
2ND RADIO OPERATOR	1
3RD RADIO OPERATOR	1
CLERK	1
CHIEF STEWARD	1
CHIEF COOK	1
CHIEF BOT	1
COOK	1
BOYS	2

CREW TOTAL 52  
STATE ROOM 4 FOR 8 PERSONS.

ENGINE FLAT.

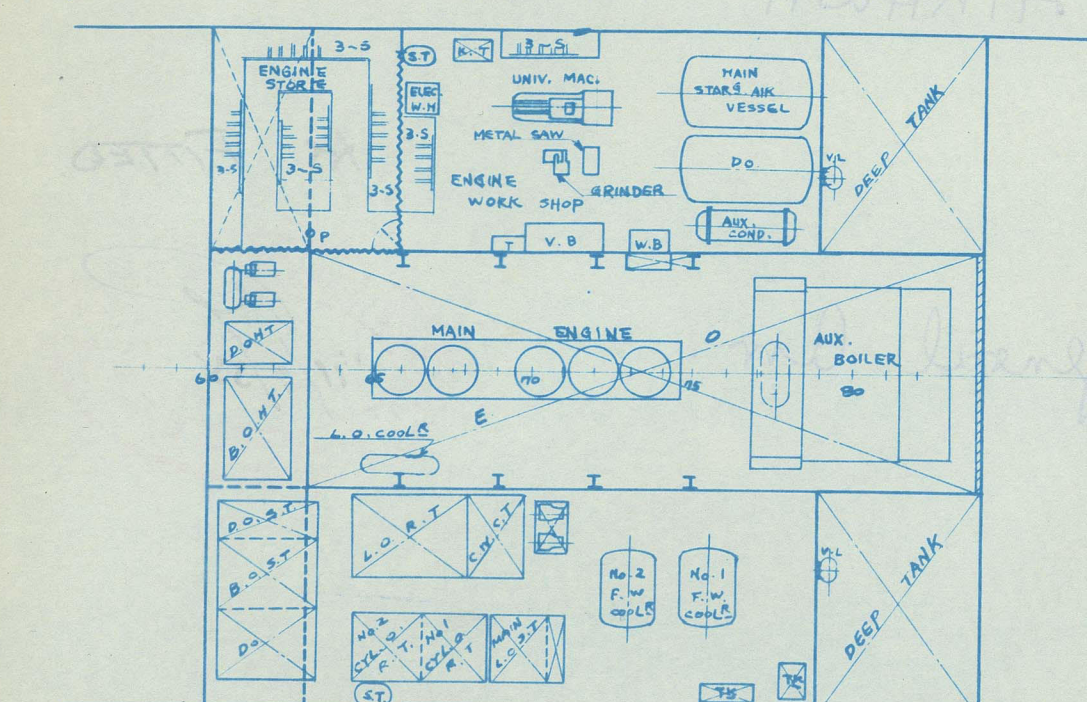

## FINISHED PLAN

KOBE RPT. NO. 3046  
DATED.

HIKAWA MARU  
日川丸  
TITLE.

GENERAL ARRANGEMENT

SCALE  $\frac{1}{200}$

KAWASAKI DOCKYARD CO., LTD.  
KOBE JAPAN  
SHIPDESIGNING DEPARTMENT

CHIEF OF DEPARTMENT *T. Takahashi*  
CHIEF OF SECTION *S. Sugawara*  
CHECKED BY *T. Nagata*  
DRAWN BY *S. Jikino*  
DATE:


DRAWING NO. A-2021



TO LLOYDS REGISTER OF SHIPPING

LONDON  
COPIES

RECORDS DEPT.  
LONDON.

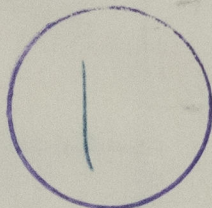


HIKAWA MARU



AS FITTED.

General Arr.

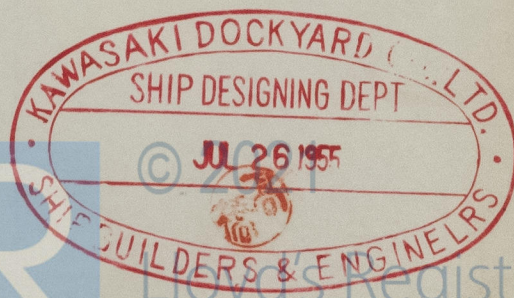

013201-013210-0139

Lloyd's Register  
Foundation