


Lloyd's Register of Shipping.

SURVEYS FOR FREEBOARD.

(CONDITIONS OF ASSIGNMENT.)

Ship's Name WOOLWICH Port of Survey Amblee
Official Number ✓ 186242 Surveyor's Signature J. H. Tait
Nationality and Port of Registry British London Date of Survey W. H. T. Building

Disposition and dimensions of superstructures, trunks, deckhouses and machinery casings to be inserted in the diagrams and tabular statement:—

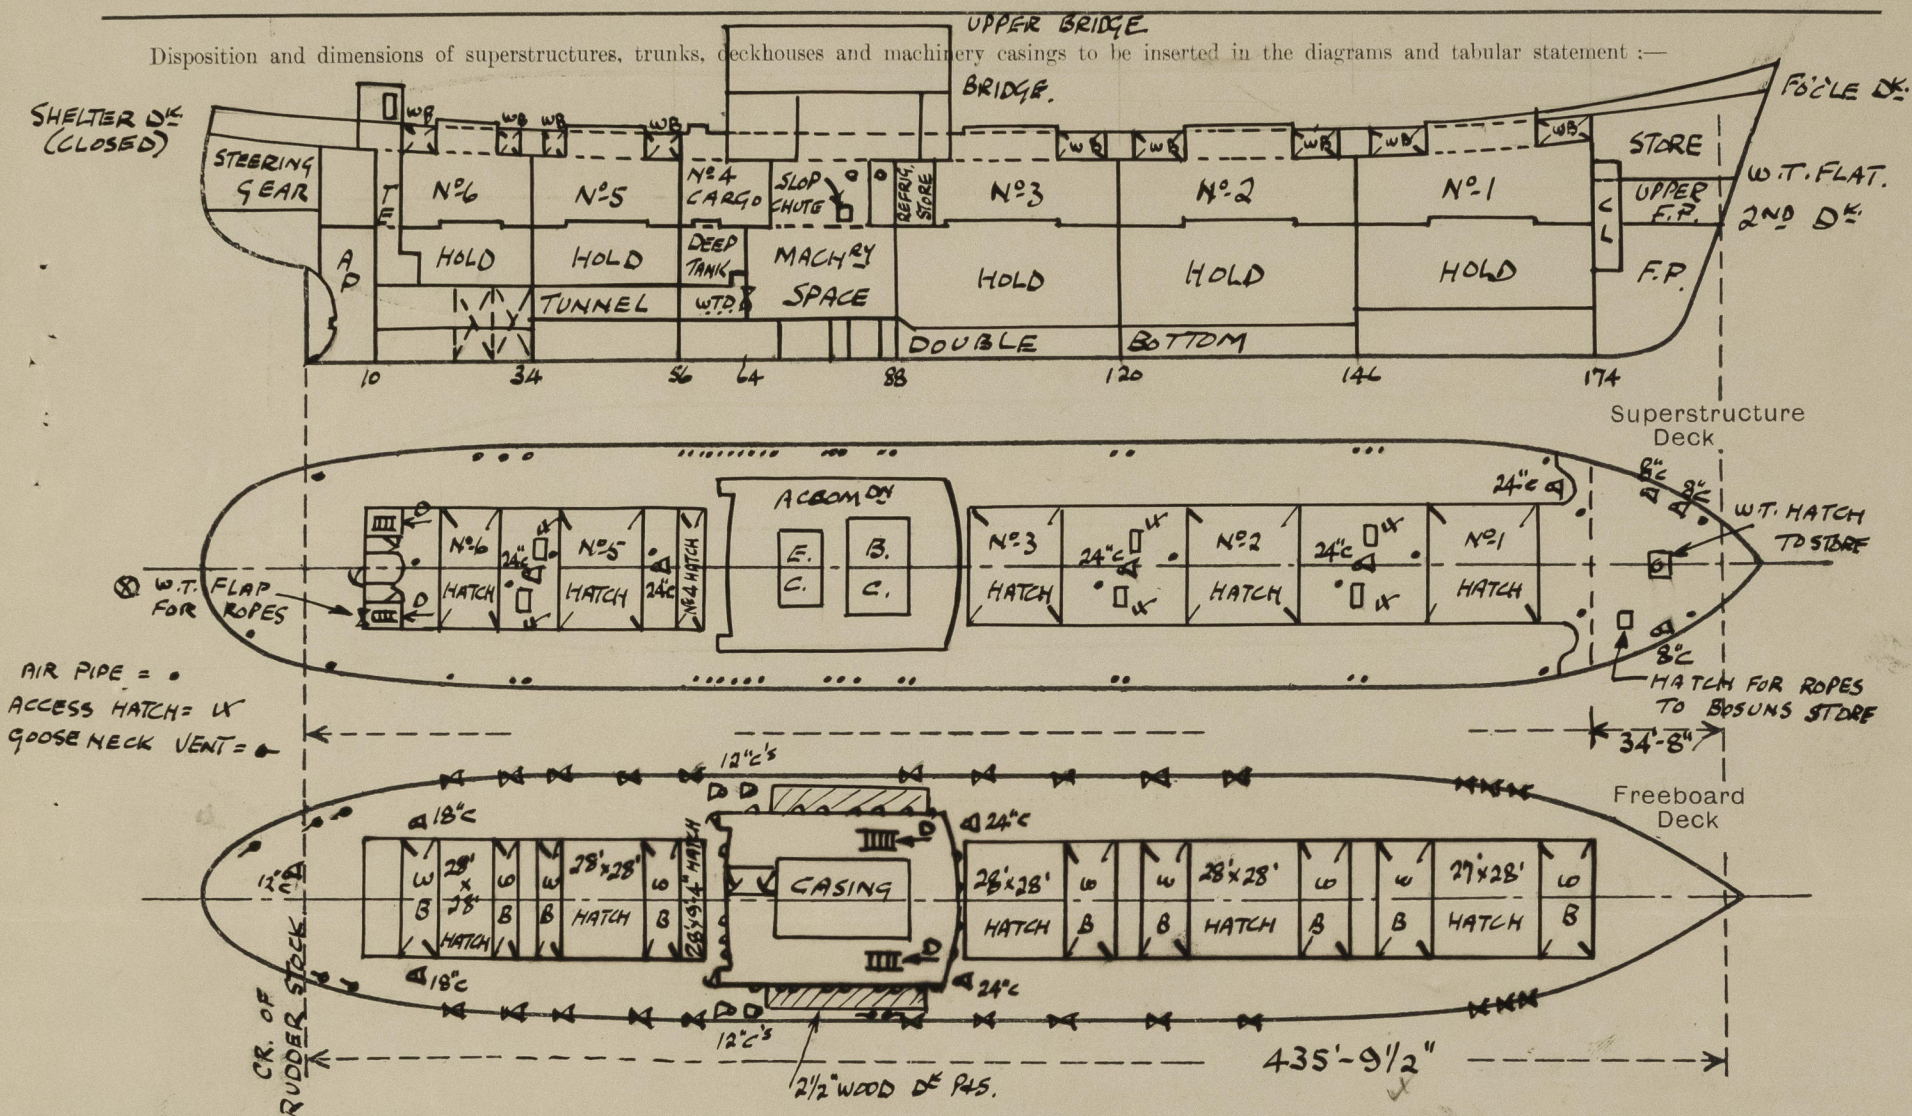

Particulars of Superstructures, Trunks, Casings, Deckhouses.


	Coaming	Plating	Stiffeners	Spacing	End Attachments of Stiffeners	Size of Openings	Height of Sills	Height of Casings
Poop Bulkhead ...								
Raised Quarter Deck Bulkhead ...								
Bridge, After Bulkhead ...								
Bridge, Forward Bulkhead ...								
Forecastle Bulkhead...	30"	30"	3" x 2 1/2" x 30' O.A.	24"	Welded T & B	None	✓	See sketch.
Trunk, Aft ...								
Trunk, Forward ...								
Exposed Machinery Casings on Freeboard or Raised Quarter Deck...	27"	27"	✓	-	✓	5'0" x 3'0"	24" ✓	8'0"
Exposed Machinery Casings on Superstructure Decks ...								
Machinery Casings within Superstructure not fitted with Class I Closing Appliances ...	25"	25"	3" x 2 1/2" x 24' O.A.	28"	alt. stiffen	6'0" x 3'0"	18" ✓	8'0"
MIDSHIP Deckhouse on Flush Deck Ships	29"	29"	5" x 3" x 30' O.A.	28"	alt. at top	None	✓	8'0"
FORE END	32"	32"	7" x 3" x 38' O.A.	30"	alt. at bottom, lug at top	None	✓	8'0"
AFT END	27"	27"	4" x 3" x 33' O.A.	32" MAX	lugged T & B	2'0" 5'6" x 2'0"	18" ✓	8'0"

Particulars of Closing Appliances (state if capable of being manipulated from both sides).


Poop Bulkhead ...	
Raised Quarter Deck Bulkhead ...	
Bridge, After Bulkhead ...	
Bridge, Forward Bulkhead ...	
Forecastle Bulkhead...	No openings ✓
Exposed Machinery Casings on Freeboard or Raised Quarter Deck...	Angled w.t. steel door open & close both sides. ✓
Exposed Machinery Casings on Superstructure Decks ...	
Machinery Casings within Superstructure not fitted with Class I Closing Appliances ...	Angled steel door open & close both sides. ✓
MIDSHIP Deckhouse on Flush Deck Ships ...	Angled w.t. steel door open & close both sides. ✓

PARTICULARS OF PROTECTION TO OPENINGS, ETC.

The following diagrams should be used to indicate the positions of cargo and coaling hatchways, gangway, cargo and coaling ports, ventilators, companionways, etc., which would affect the seaworthiness of the ship :—

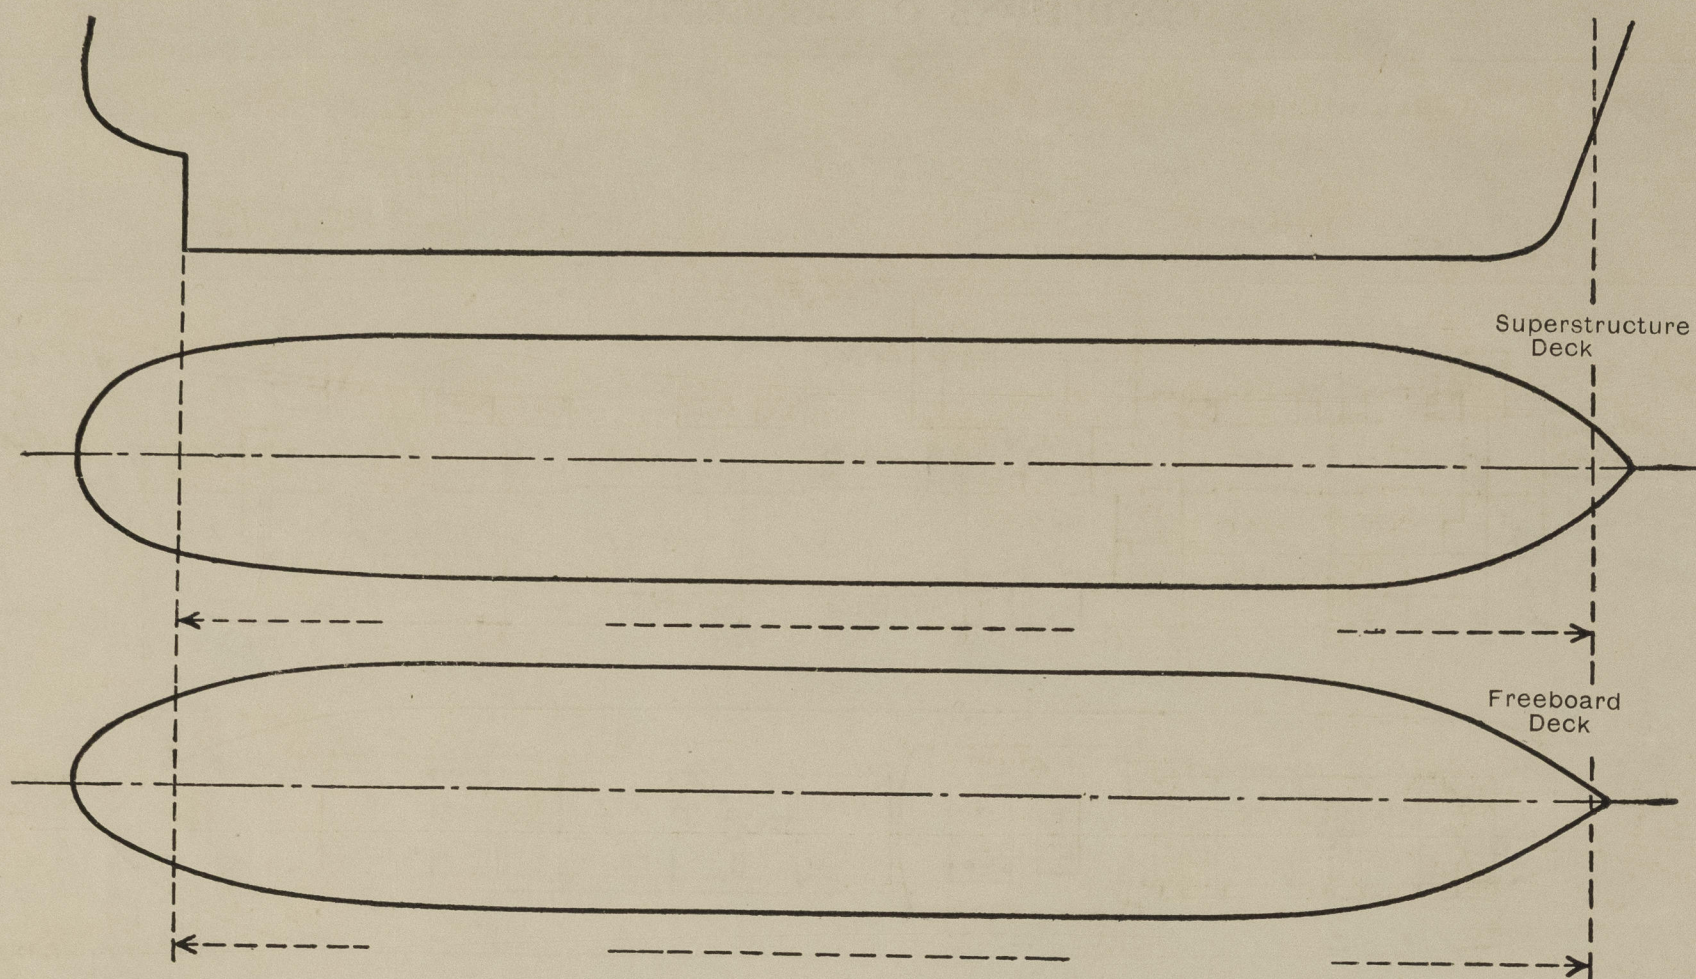

Particulars of fiddle, funnel and ventilator coamings, engine room skylight and other openings in machinery casing tops and their means of closing :—

 

Particulars of Flush Bunker Scuttles :—

Particulars of Companionways :—

Particulars of Ventilators in exposed positions on freeboard and superstructure decks :—

Particulars of Air Pipes in exposed positions on freeboard, raised quarter, or superstructure decks :—

5



© 2021

Lloyd's Register
Foundation