
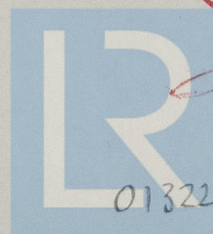


FOR APPROVAL

Kobe Rpt. No	8 - 6428
Port of Survey.	HIROSHIMA
Name of Ship.	"OCEANIA MARU"
Title of Plan	ALTERATION NO. 1

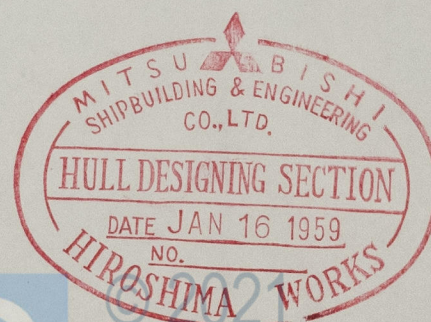

M. Misawa
Lloyd's Register
Foundation