
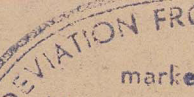


20-11-51.

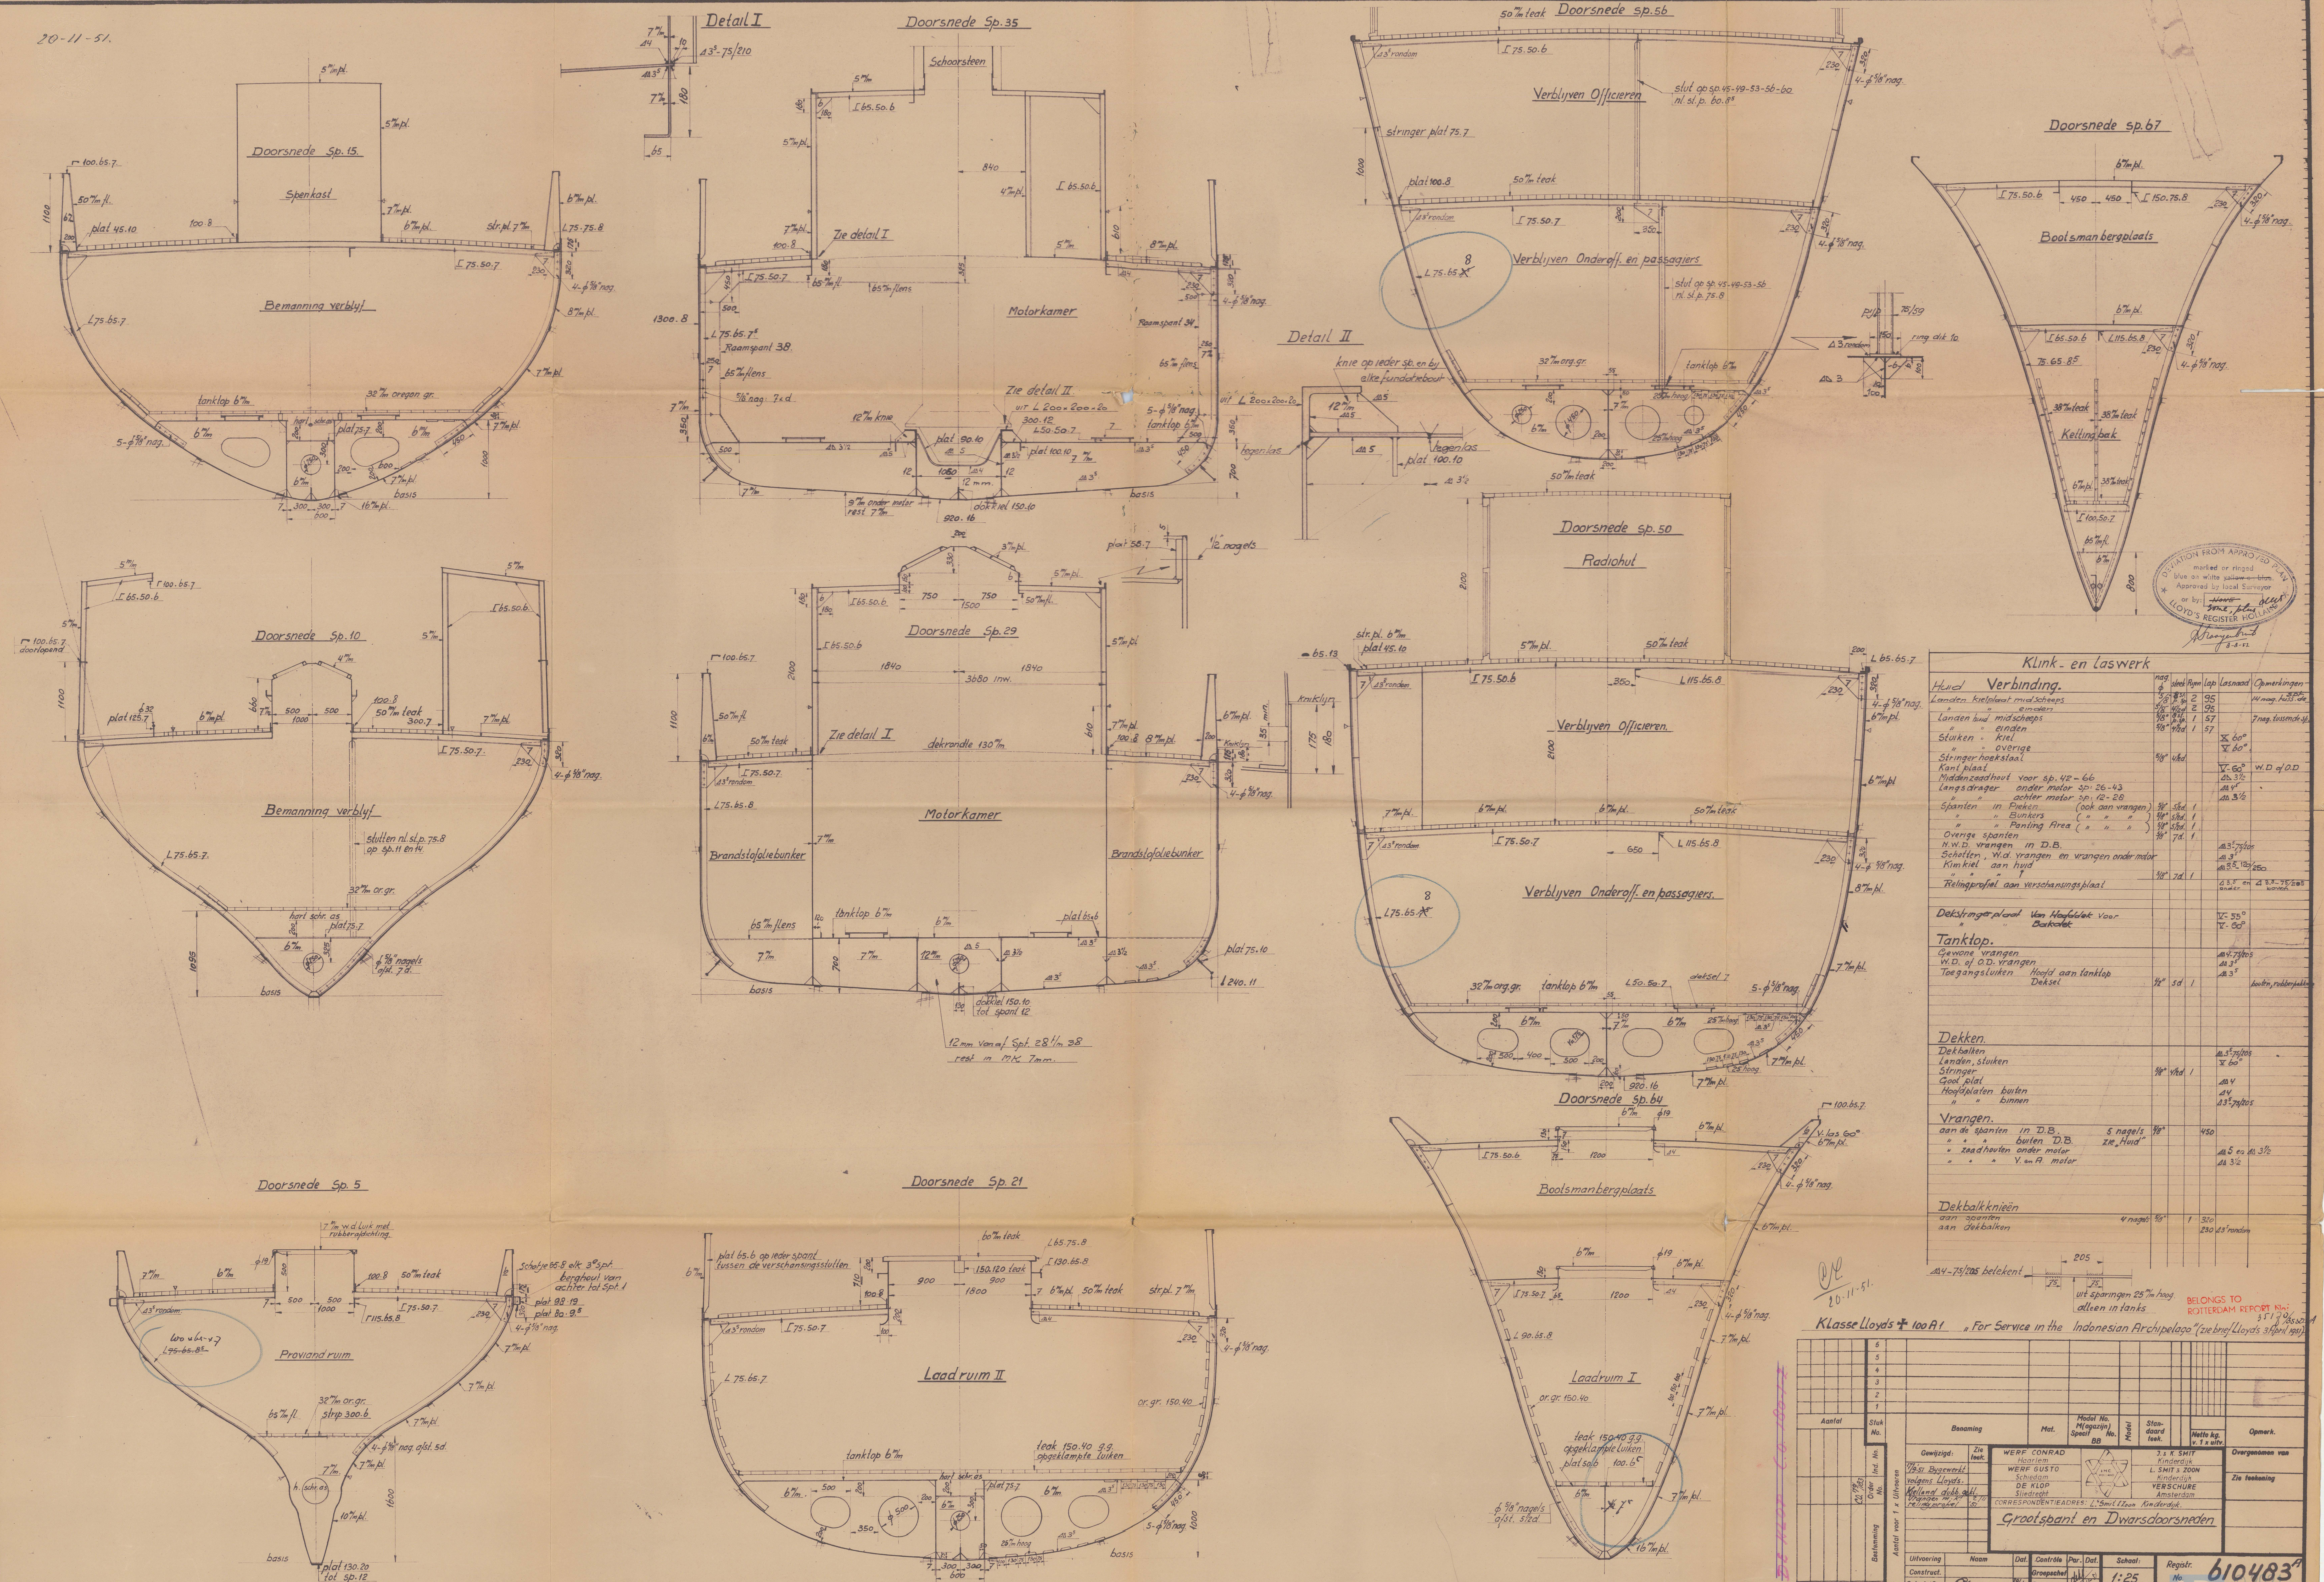

DENIATION FROM APPROVED PLAN
marked or ringed
blue on white yellow or blue
Approved by local Surveyor
or by: None clear
some, blue
LLOYD'S REGISTER HOLLAND
Grayson

[illegible]


20.11.51. 75 75 75
 uit spargen 25 "m hoog.
 alleen in tanks BELONGS TO ROTTERDAM REPORT No: 35120
 Klasse Lloyds * 100A1 „For Service in the Indonesian Archipelago“ (zie brief Lloyds 3 April 1951) 35120 35520 A

[illegible]

Registr. No. 610483^A

RECORDS DEPT.
LONDON

BABUT ★★
Midship Section

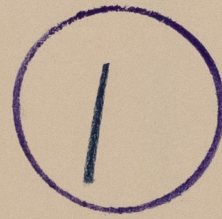

© 2021

Lloyd's Register
Foundation

013322-013328-0294