




London.  
22-4-41

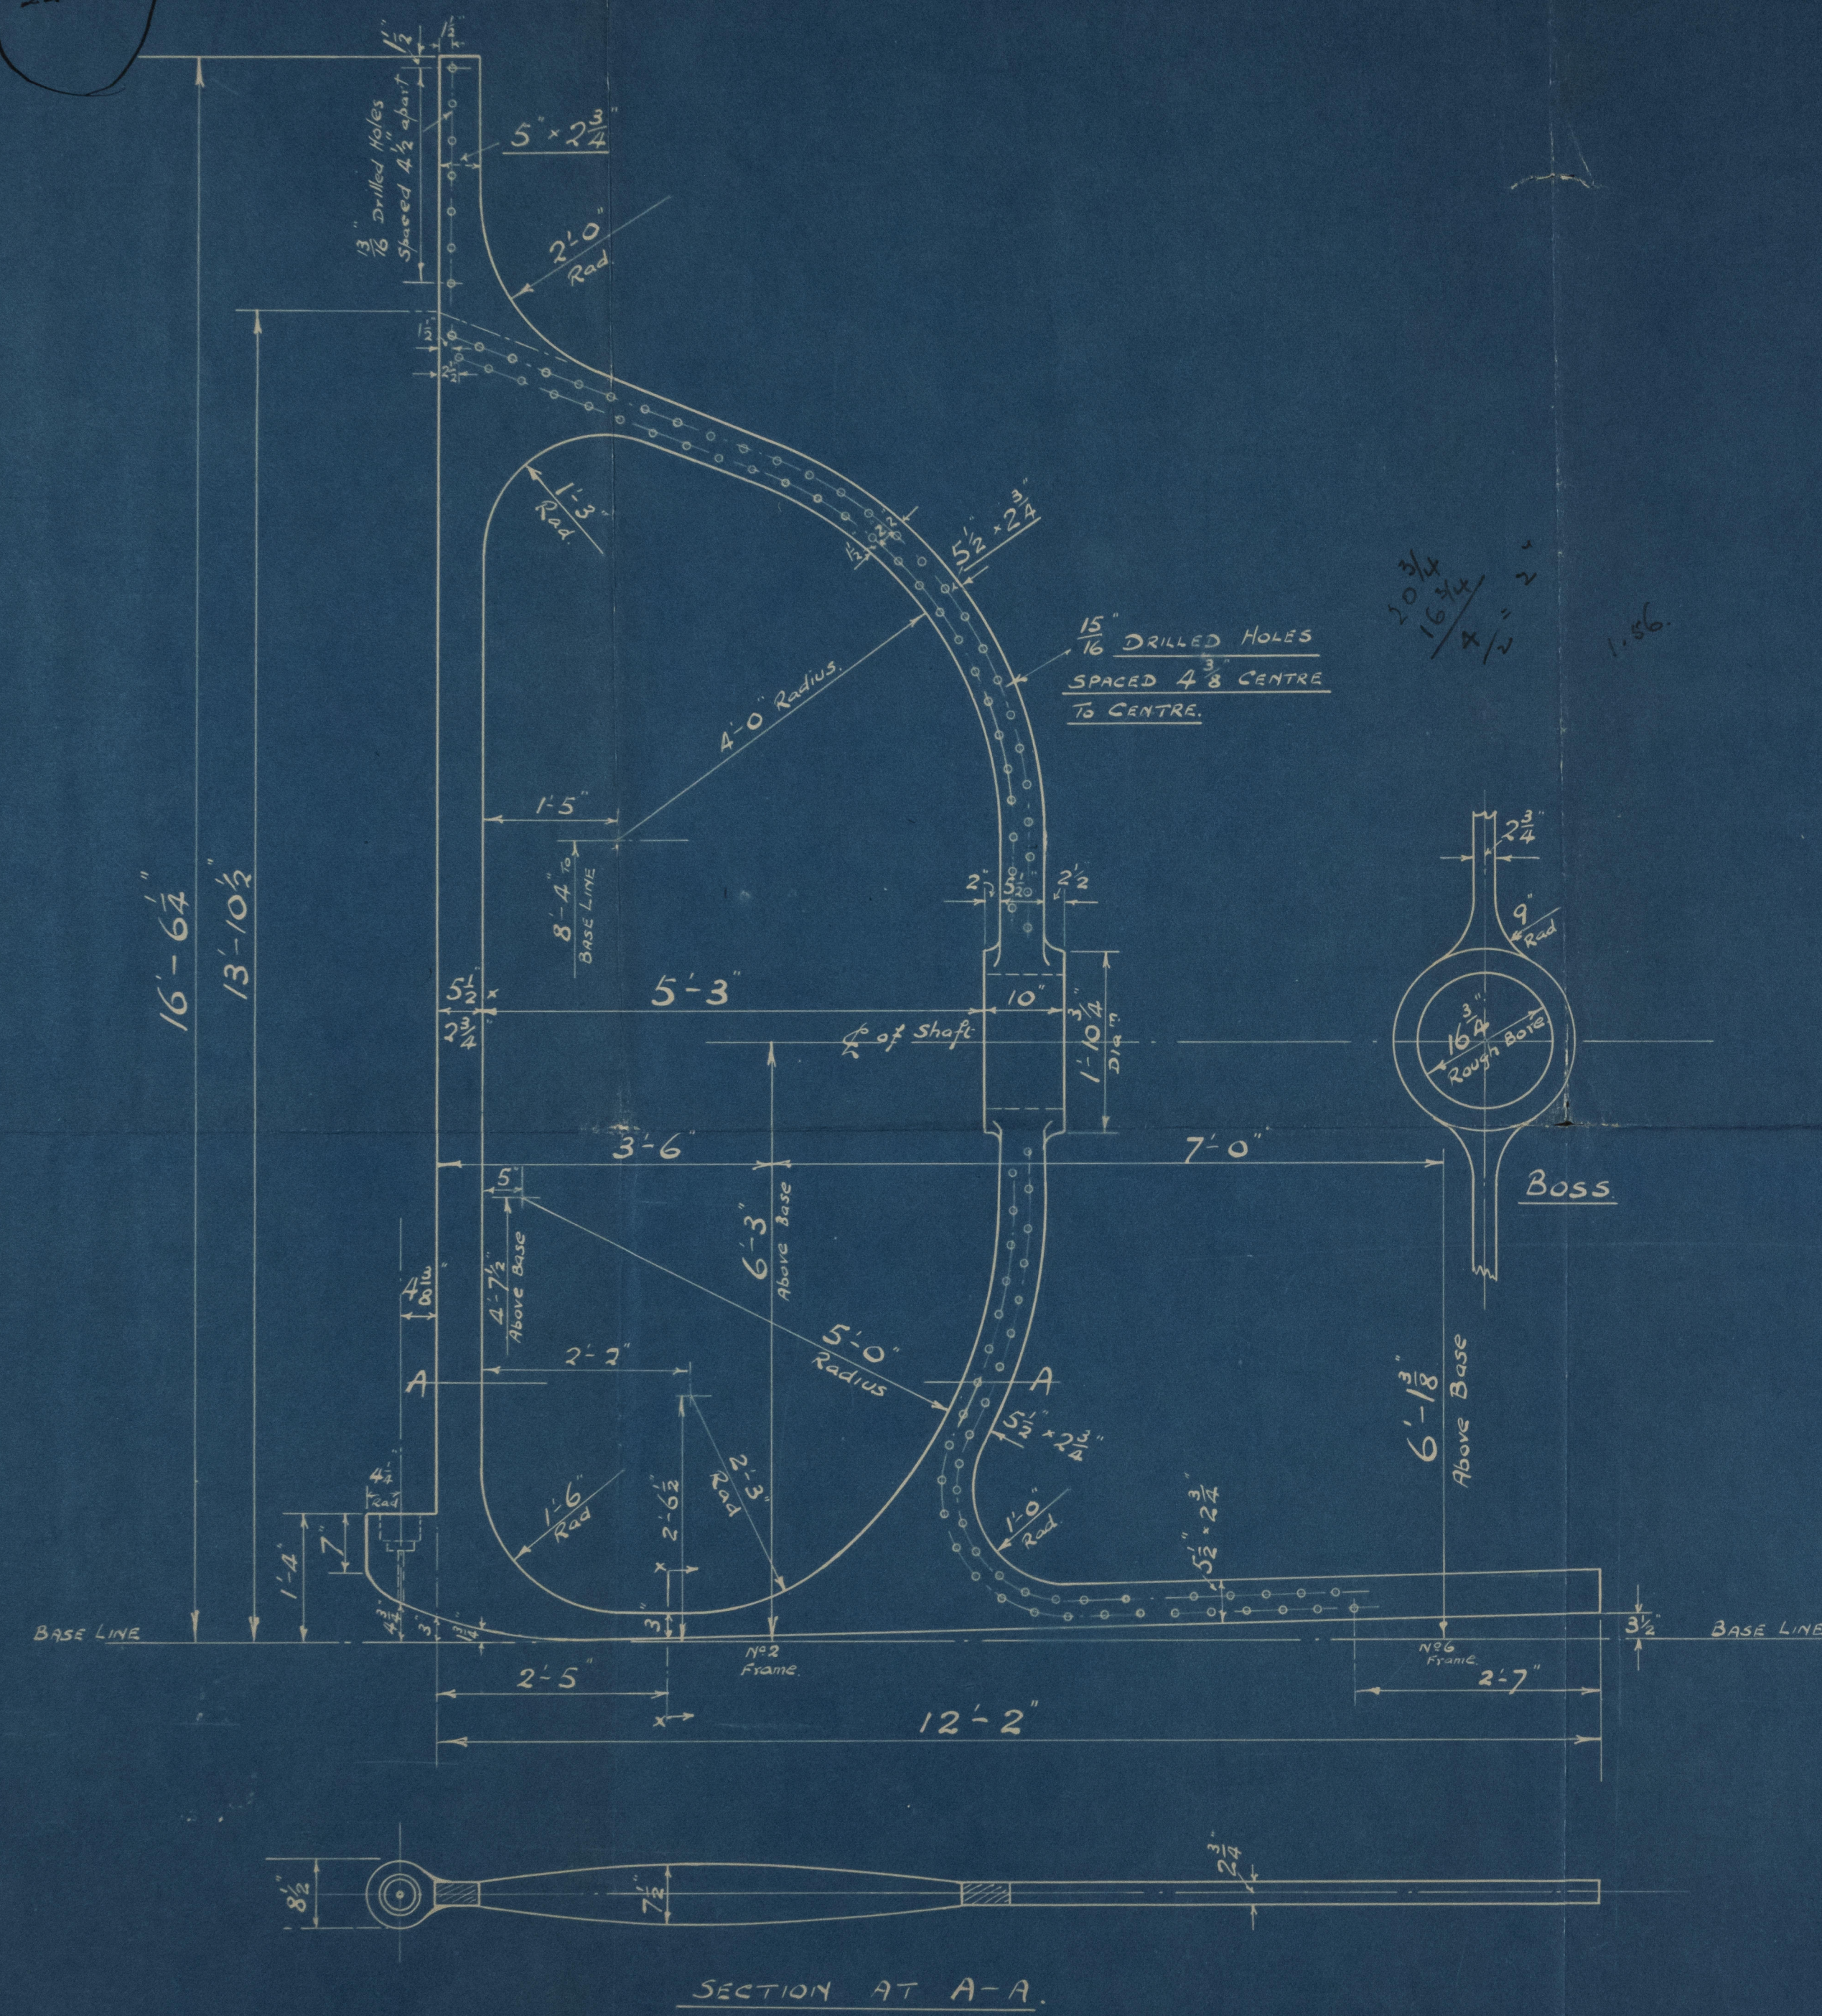

$\frac{20\frac{3}{4}}{16\frac{3}{4}} = \frac{4}{2} = 2$   
1.56

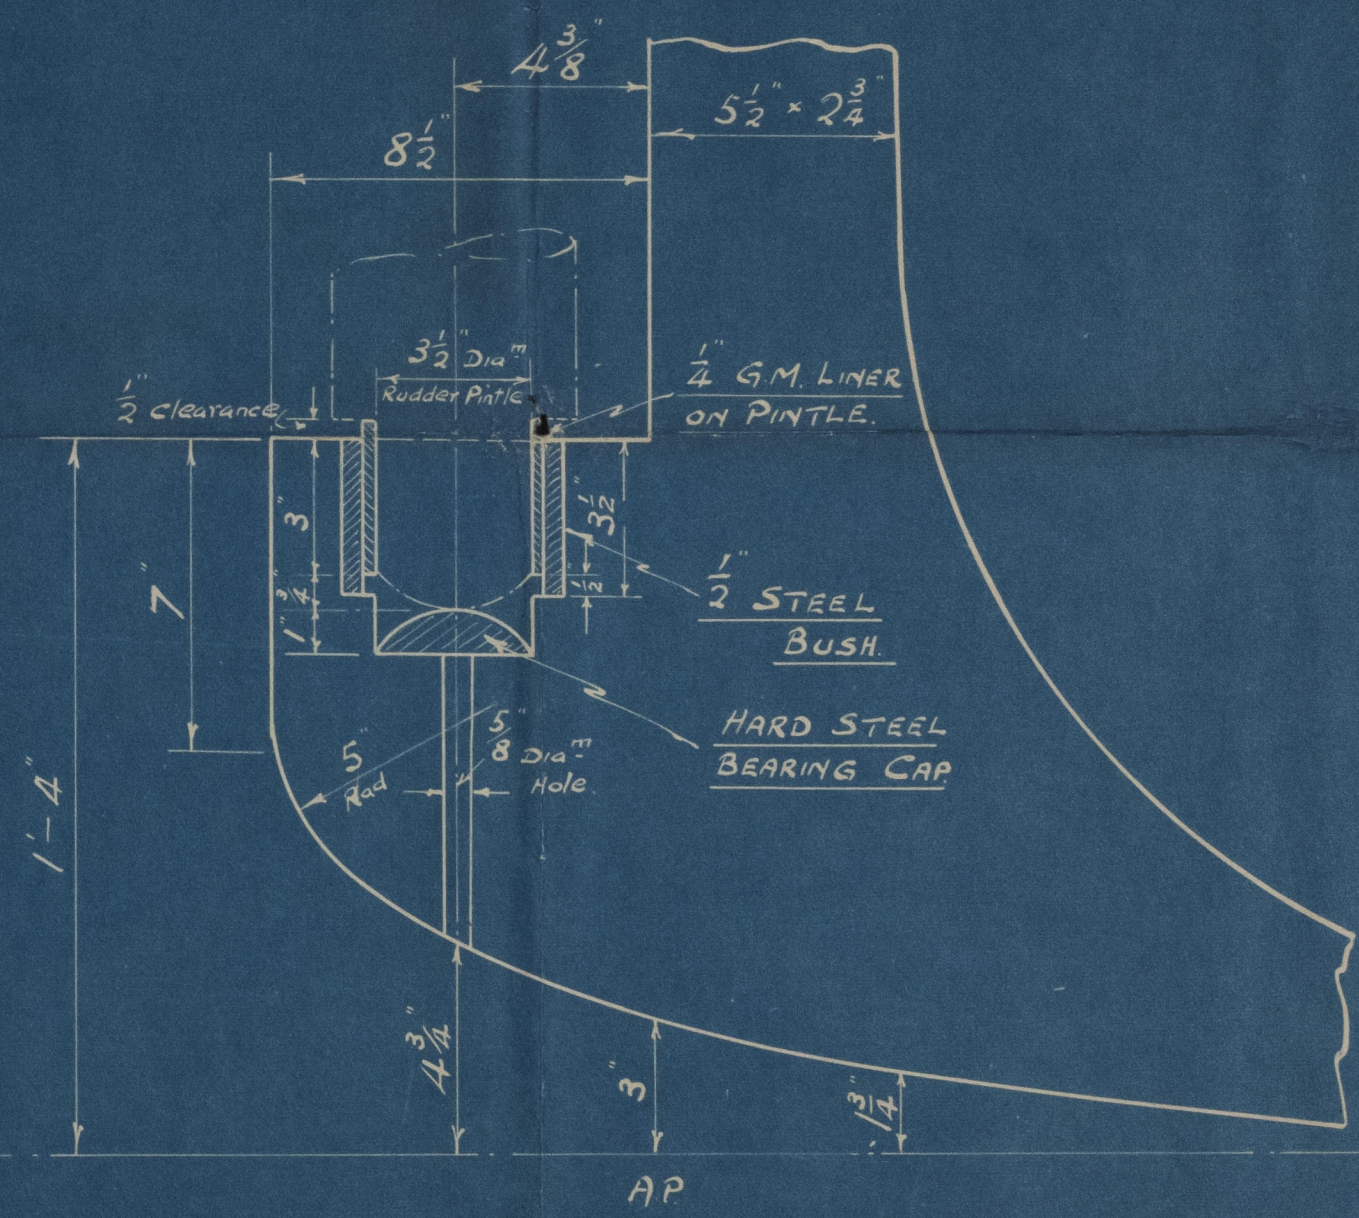

DETAIL OF BOTTOM GUDGEON  
SCALE 3" = ONE FOOT.

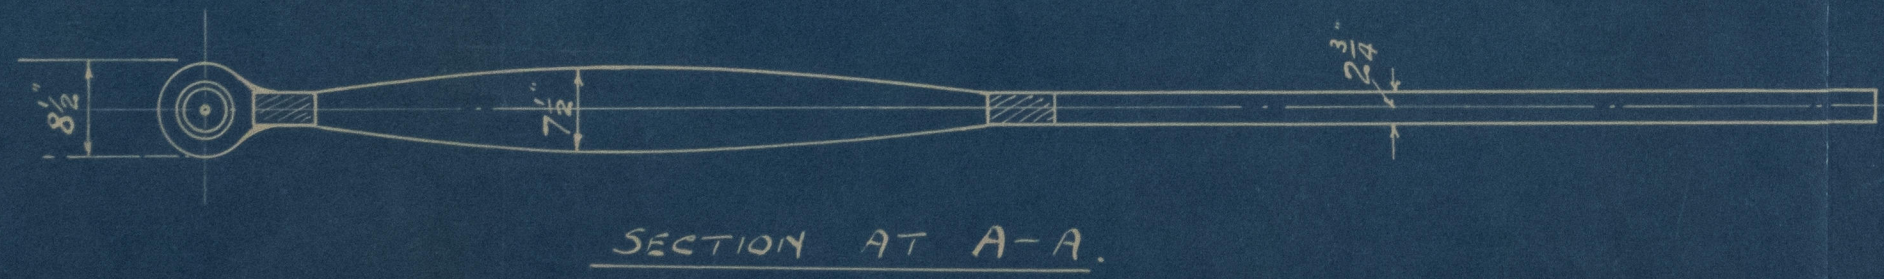


# STERNFRAME FORGING.

TO BE PASSED BY LLOYDS.

1528.

FOR 105 FT TUG.

SCALE  $\frac{3}{4}$  & 3" = ONE FOOT.

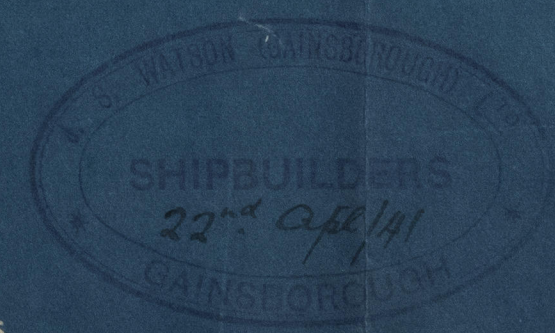

J.S. WATSON (Gainsborough) LTD  
SHIPBUILDERS  
GAINSBOROUGH.  
APRIL 1941



