

ELEVATION (STARBOARD SIDE)

ALEXANDRA I

Kobe RPT. No. 3525
DATED.

YOKOBE
LONDON

50


NOTED
REGISTERED
KOB

SNO 3752		LIBRARY TRANSMISSION INFORMATION D.W. 33,000 TANKER	
ARRANGEMENT OF MACHINERIES			
IN ENGINE &		BOILER ROOM	
SCALE		1/40	
HITACHI		DRAWN BY H. Kawanishi	
SHIP BUILDING & ENGINEERING CO., LTD.		CHECKED BY M. Kawanishi	
MANUF.		5	
CODE NO 201001		DRAWING NO Y497-2	

013365-003752-0004

5441 Register

TURN

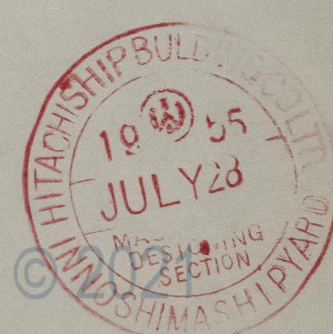

Lloyd's Register
Foundation

013365-013375-0004