

S.Nº 3752 DW. 33,000 LT.  
OIL TANKER

## CONSTRUCTION PROFILE & DECKS

HITACHI SHIPBUILDING & ENGINEERING CO., LTD.  
— OSAKA — JAPAN —

SHIP DESIGN SECTION	CHIEF OF SECT.	<i>[Signature]</i>
---------------------	----------------	--------------------

DATE	JUN 10 1955	REVIEWED BY	<i>M. Tazawa</i>
DRAWING NO.	H-02-2-1	CHECKED BY	<i>S. Yamamoto</i>


SHEET NO.	034873	DRAWN BY	H. Yamamoto
-----------	--------	----------	-------------



ALEXANDRA '1.★

M/M.13365

RECORDS DEPT.,  
LONDON.

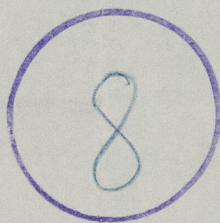

HITACHI

Alexandra 1

Yard No 3752

CONSTRUCTION PROFILE & DECKS.  
(ALTERATION -1)




© 2021

Lloyd's Register  
Foundation

013365-013375-0017



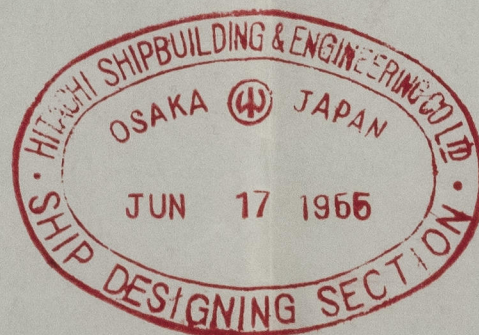

013365-013375-0017 JUN 20 1955



© 2021  
Lloyd's Register  
Foundation