

# Lloyd's Register of Shipping.


## SURVEYS FOR FREEBOARD.

(CONDITIONS OF ASSIGNMENT.)

3-FEB 1956

Ship's Name ALEXANDRA I Port of Survey Innoshima, Japan  
 Official Number 718. Surveyor's Signature Wm G. McCulloch  
 Nationality and Port of Registry Liberian, Monrovia Date of Survey Whilst building.

Disposition and dimensions of superstructures, trunks, deckhouses and machinery casings to be inserted in the diagrams and tabular statement:—

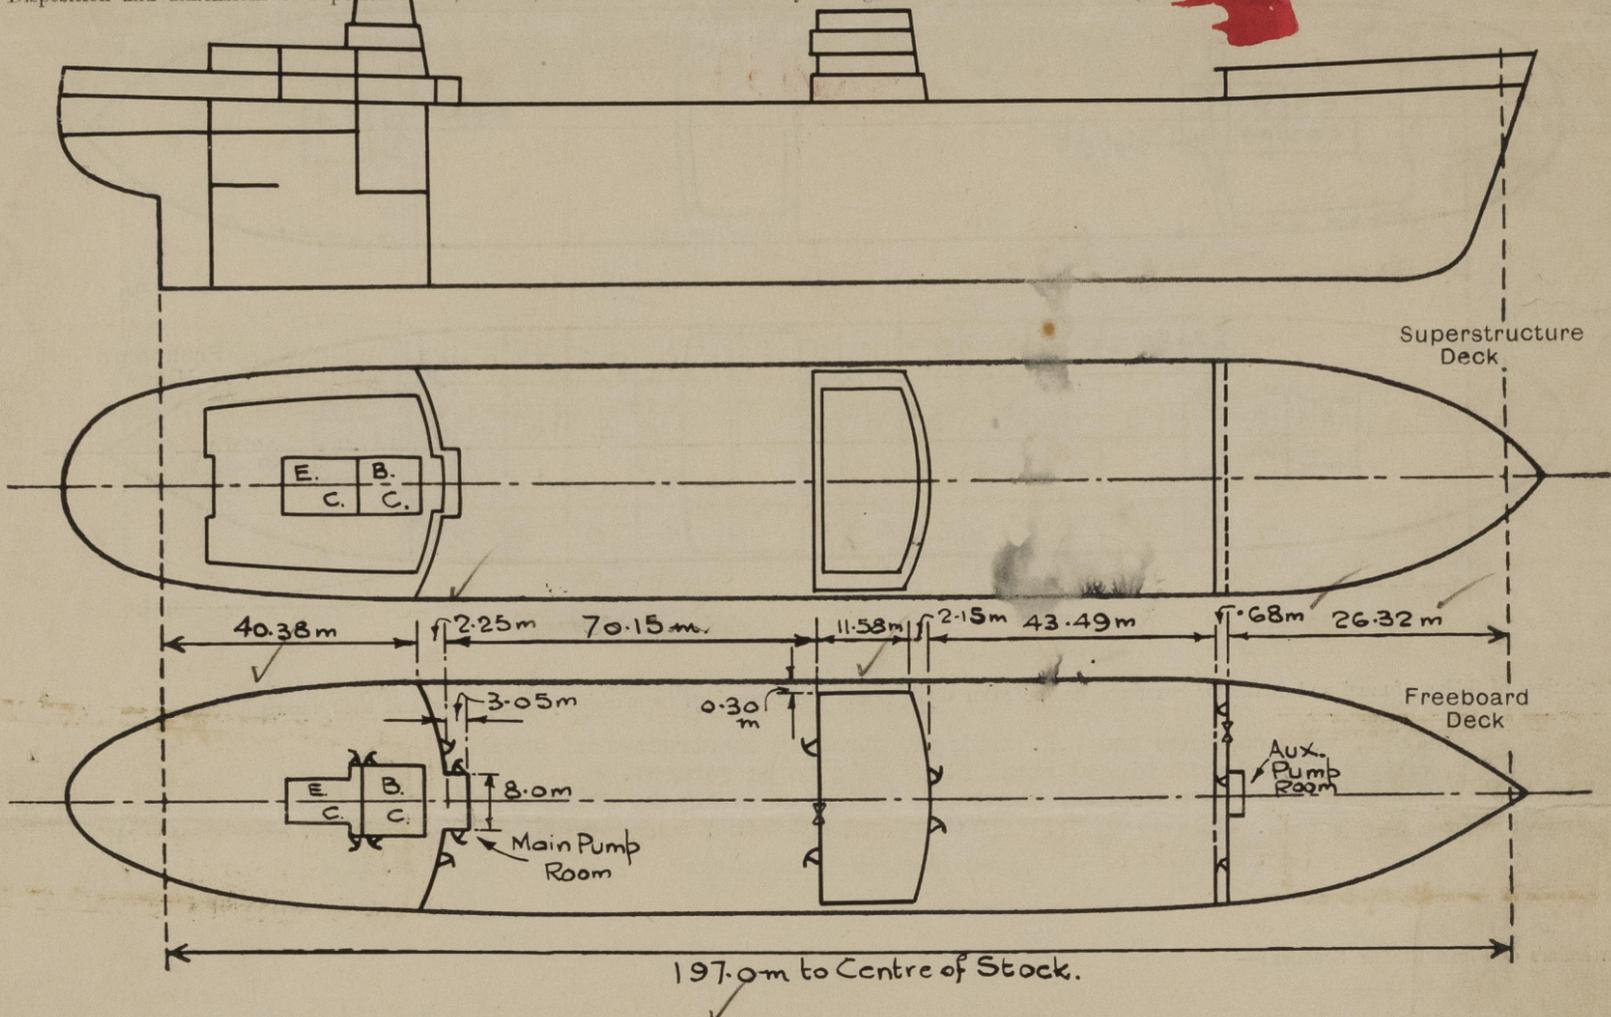

Particulars of Superstructures, Trunks, Casings, Deckhouses.


	Coaming m/m	Plating m/m	Stiffeners m/m	Spacing m/m	End Attachments of Stiffeners	Size of Openings m/m	Height of Sills m/m	Height of Casings m/m
Poop Bulkhead ...	11.5 ✓	11.5 ✓	300x90x12/16 ✓	800 ✓	Welded ✓	4@ 1600x700	2@ 457 ✓ 2@ 610 ✓	2600
Raised Quarter Deck Bulkhead ...				-		2@ 1600x700 2@ 1710x1300	300 ✓	2600
Bridge, After Bulkhead ...	8 ✓	8 ✓	100x75x10 ✓	800 ✓	Welded ✓	2@ 1600x700 2@ 1710x1300	380 ✓ 292 ✓	2600
Bridge, Forward Bulkhead ...	11.5 ✓	11.5 ✓	300x90x10/155 ✓	800 ✓	Welded ✓	2@ 1600x700 2@ 1600x700 1@ 1600x700 1@ 1710x1300	610 ✓ 300 ✓	2600
Forecastle Bulkhead ...	8 ✓	8 ✓	125x10 FB ✓	577 - 800 ✓	Free ✓			
Trunk, Aft ...				-				
Trunk, Forward ...				-				
Exposed Machinery Casings on Freeboard or Raised Quarter Decks ...				-				
Exposed Machinery Casings on Superstructure Decks ...				-				
Machinery Casings within Superstructures fitted with Class I Closing Appliances ...	8	6	90 x 8 FB	800	Welded	4@ 1710x700	270 ✓	2600
Deckhouses on Flush Deck Ships ...				-				

Particulars of Closing Appliances (state if capable of being manipulated from both sides).

Poop Bulkhead ...	Hinged Steel W.T. doors capable of being manipulated from both sides. ✓
Raised Quarter Deck Bulkhead ...	Hinged Steel W.T. doors capable of being manipulated from both sides. ✓
Bridge, After Bulkhead ...	Portable steel plates secured by hook bolts. ✓
Bridge, Forward Bulkhead ...	Hinged steel W.T. doors capable of being manipulated from both sides. ✓
Forecastle Bulkhead ...	Hinged steel W.T. doors capable of being manipulated from both sides. ✓
Exposed Machinery Casings on Freeboard or Raised Quarter Decks ...	-
Exposed Machinery Casings on Superstructure Decks ...	-
Machinery Casings within Superstructures fitted with Class I Closing Appliances ...	Hinged Steel doors capable of being manipulated from both sides. ✓
Deckhouses on Flush Deck Ships ...	-



PARTICULARS OF PROTECTION TO OPENINGS, ETC.

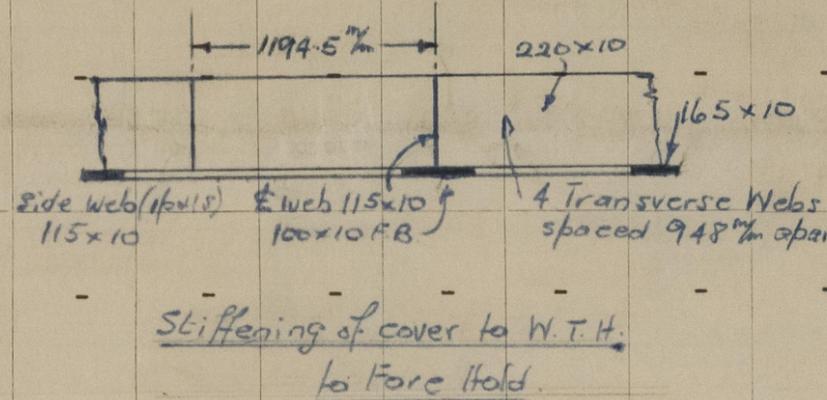HATCHWAYS ON FREEBOARD AND SUPERSTRUCTURE DECKS.												
			Freeboard deck			Focsle deck		Bridge Dk.	Poop Deck		Freeboard Deck.	
Description of Hatchway	...	...	2 W.T.H. to C/dam	2 O.T.H. to F.O.T.	33 O.T.H. to C.O.Tk.	W.T.H. to Store	W.T.H. to dry hold	W.T.H. to pump room	W.T.H. to store	W.T.H. to store	2 W.T.H. Chn.Lkr & Store	2 O.T.H. for F.O.S. T.
Dimensions of Hatchway	...	...	510x610 elliptical	510x610 elliptical	1219 dia	780x780	4760x4800	570x570	1830x1570	720x520 elliptical	760x660	510x610 Elliptical
COAMINGS	Height above Deck	...	260 ✓	610 ✓	762 ✓	762 ✓	610 ✓	457 ✓	762 ✓	457 ✓	230 ✓	610 ✓
	Thickness { Sides	...	13 ✓	13 ✓	13 ✓	11 ✓	11 ✓	11 ✓	11 ✓	11 ✓	11 ✓	13 ✓
	Thickness { Ends	...										
	Stiffeners ...	...	-	-	-	-	-	-	-	-	-	-
Brackets, Stays	...	-	-	-	-	-	180x9 5BP 300x11 Plate 65 flange	-	-	-	-	-
HATCH BEAMS	Number ...	...	-	-	-	-	-	-	-	-	-	-
	Spacing ...	...	-	-	-	-	-	-	-	-	-	-
	Scantling and Sketch	...										
Bearing Surface	...	-	-	-	-	-	-	-	-	-	-	-
FORE AND AFTERS	Number ...	...	-	-	-	-	-	-	-	-	-	-
	Spacing ...	...	-	-	-	-	-	-	-	-	-	-
	Unsupported Lengths	...	-	-	-	-	-	-	-	-	-	-
	Scantling* and Sketch	...	-	-	-	-	-	-	-	-	-	-
Bearing Surface	...	-	-	-	-	-	-	-	-	-	-	
HATCH COVERS	Material	...	Steel	Steel	Steel	Steel	Steel	Steel	Steel	Steel	Steel	Steel
	Thickness	...	13 ✓	13 ✓	13 ✓	9 ✓	10 ✓	9 ✓	9 ✓	9 ✓	9 ✓	13 ✓
	How fitted	...	Hinged	Hinged	Hinged	Hinged	Hinged	Hinged	Hinged	Hinged	Hinged	Hinged
	Bearing Surface	...	13 ✓	13 ✓	13 ✓	11 ✓	17 ✓	9 ✓	9 ✓	9 ✓	9 ✓	13 ✓
Spacing of Cleats	...	Secured by 6 nuts	Secured by 6 nuts	Secured by 6 nuts	Secured by 6 Wing Nuts	Secured by 36 nuts	Secured by 4 Wing nuts	Secured by 10 Wing nuts	Secured by 4 Butter-fly nuts	Secured by 6 nuts	Secured by 6 nuts	
Number of Tarpaulins	...	6	6	6	6	6	6	6	6	6	6	

- \*Are wood fore and afters steel shod at all bearing surfaces?
- Are battens and wedges efficient and in good condition?
- Are tarpaulins in good condition and in accordance with rule requirements?
- Are lashings provided in accordance with rule requirements?

Particulars of any special features:—

Detail of Butterworth openings in Upper Deck:

