





DETAIL OF RUDDER COUPLING

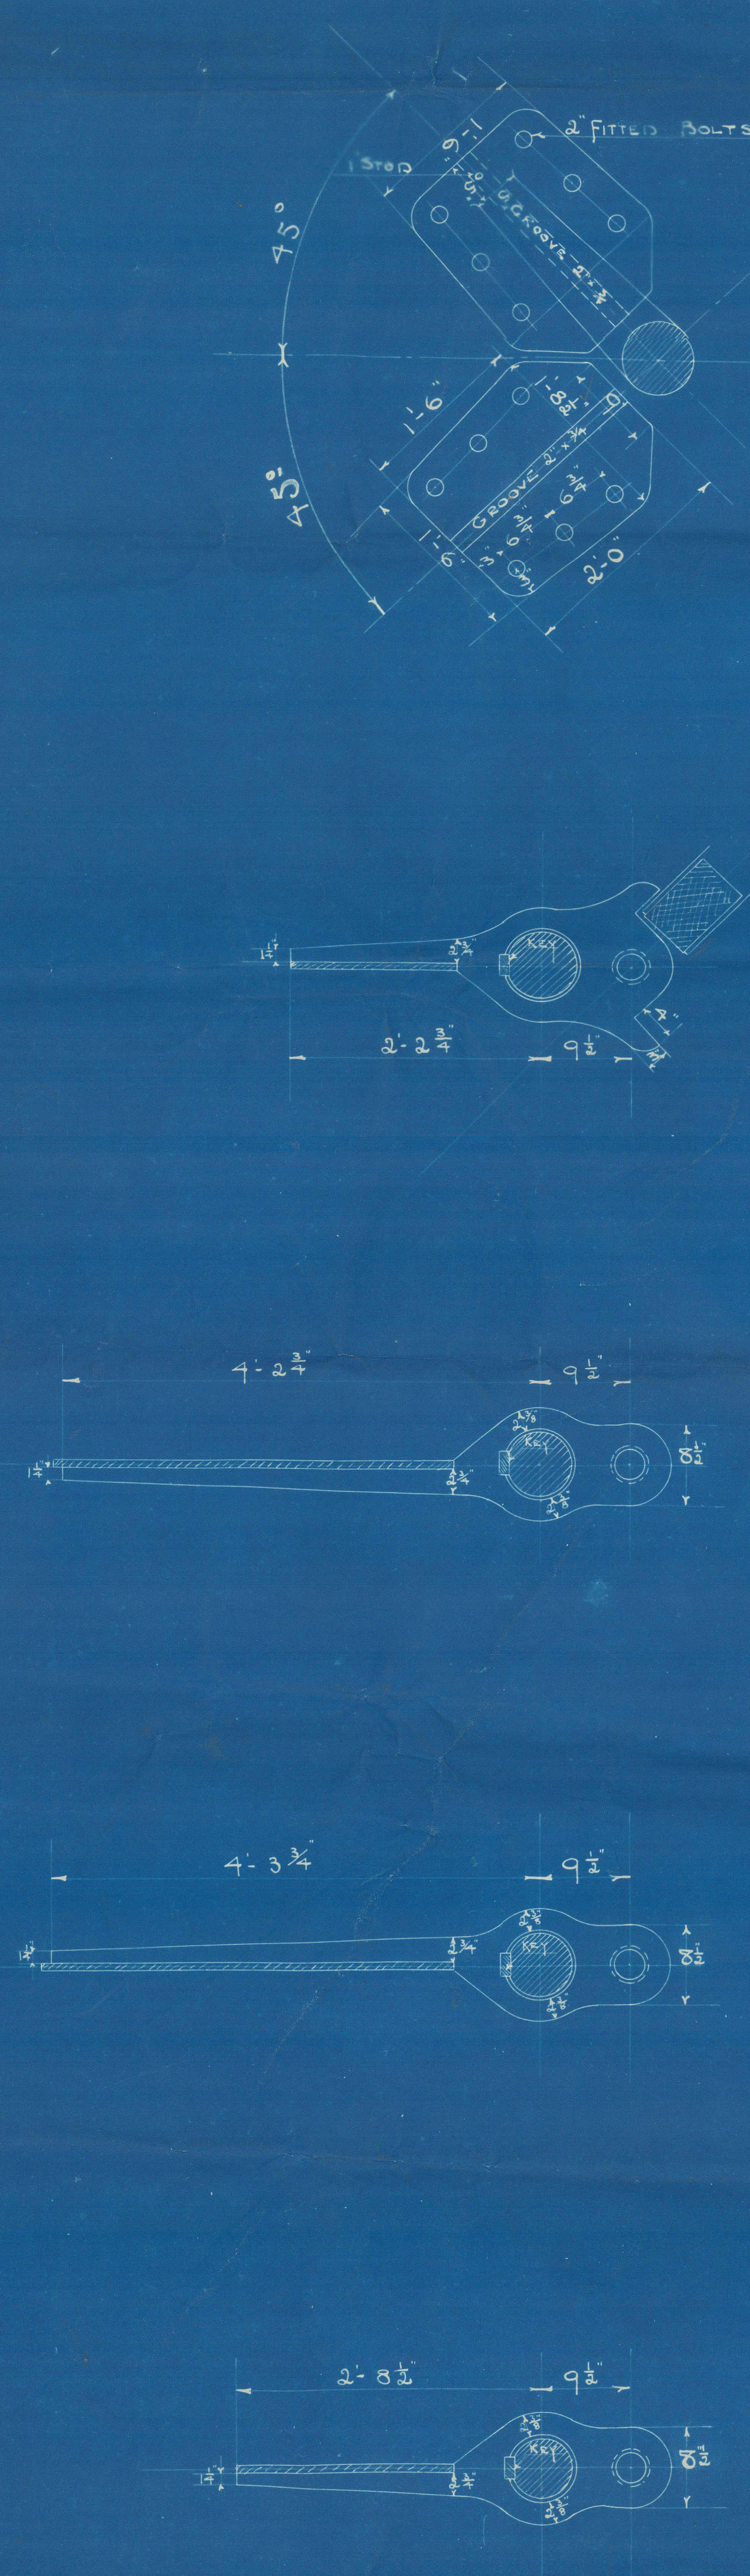

HEIGHT OF RUDDER 15'-11"

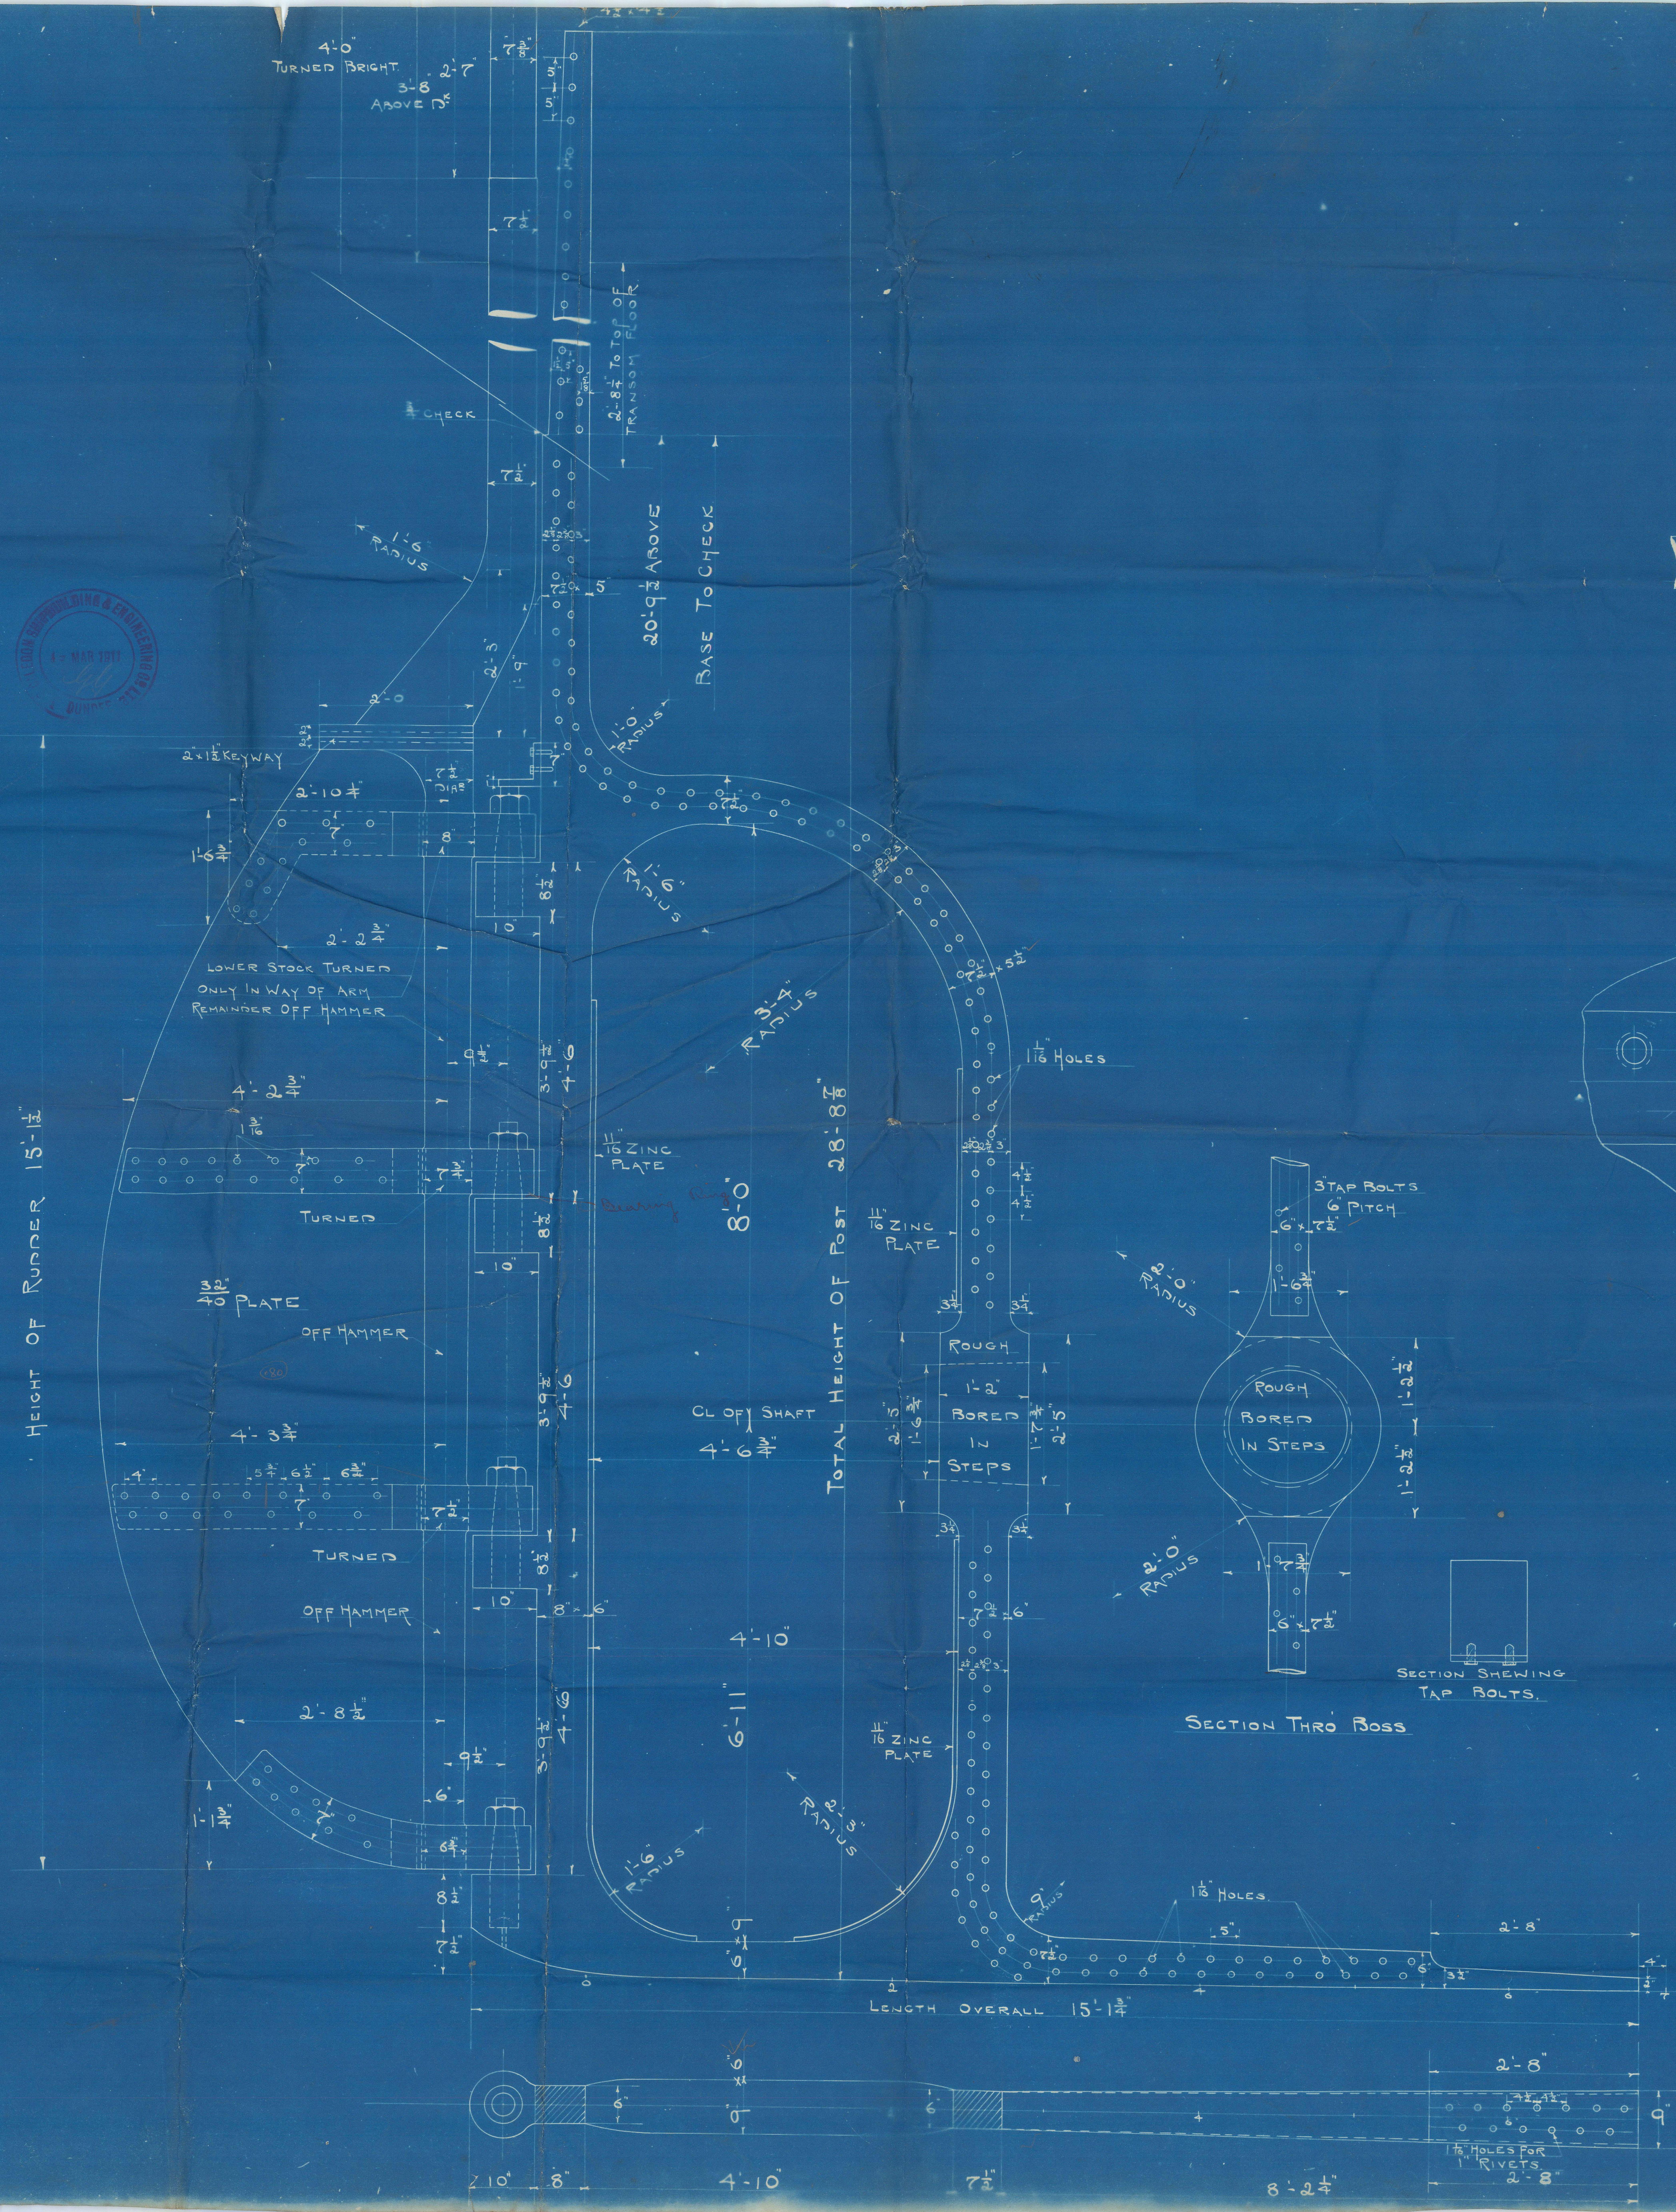


SECTION THRO RUDDER STOCK IN WAY OF ARM  
SCALE 3"=1 FOOT

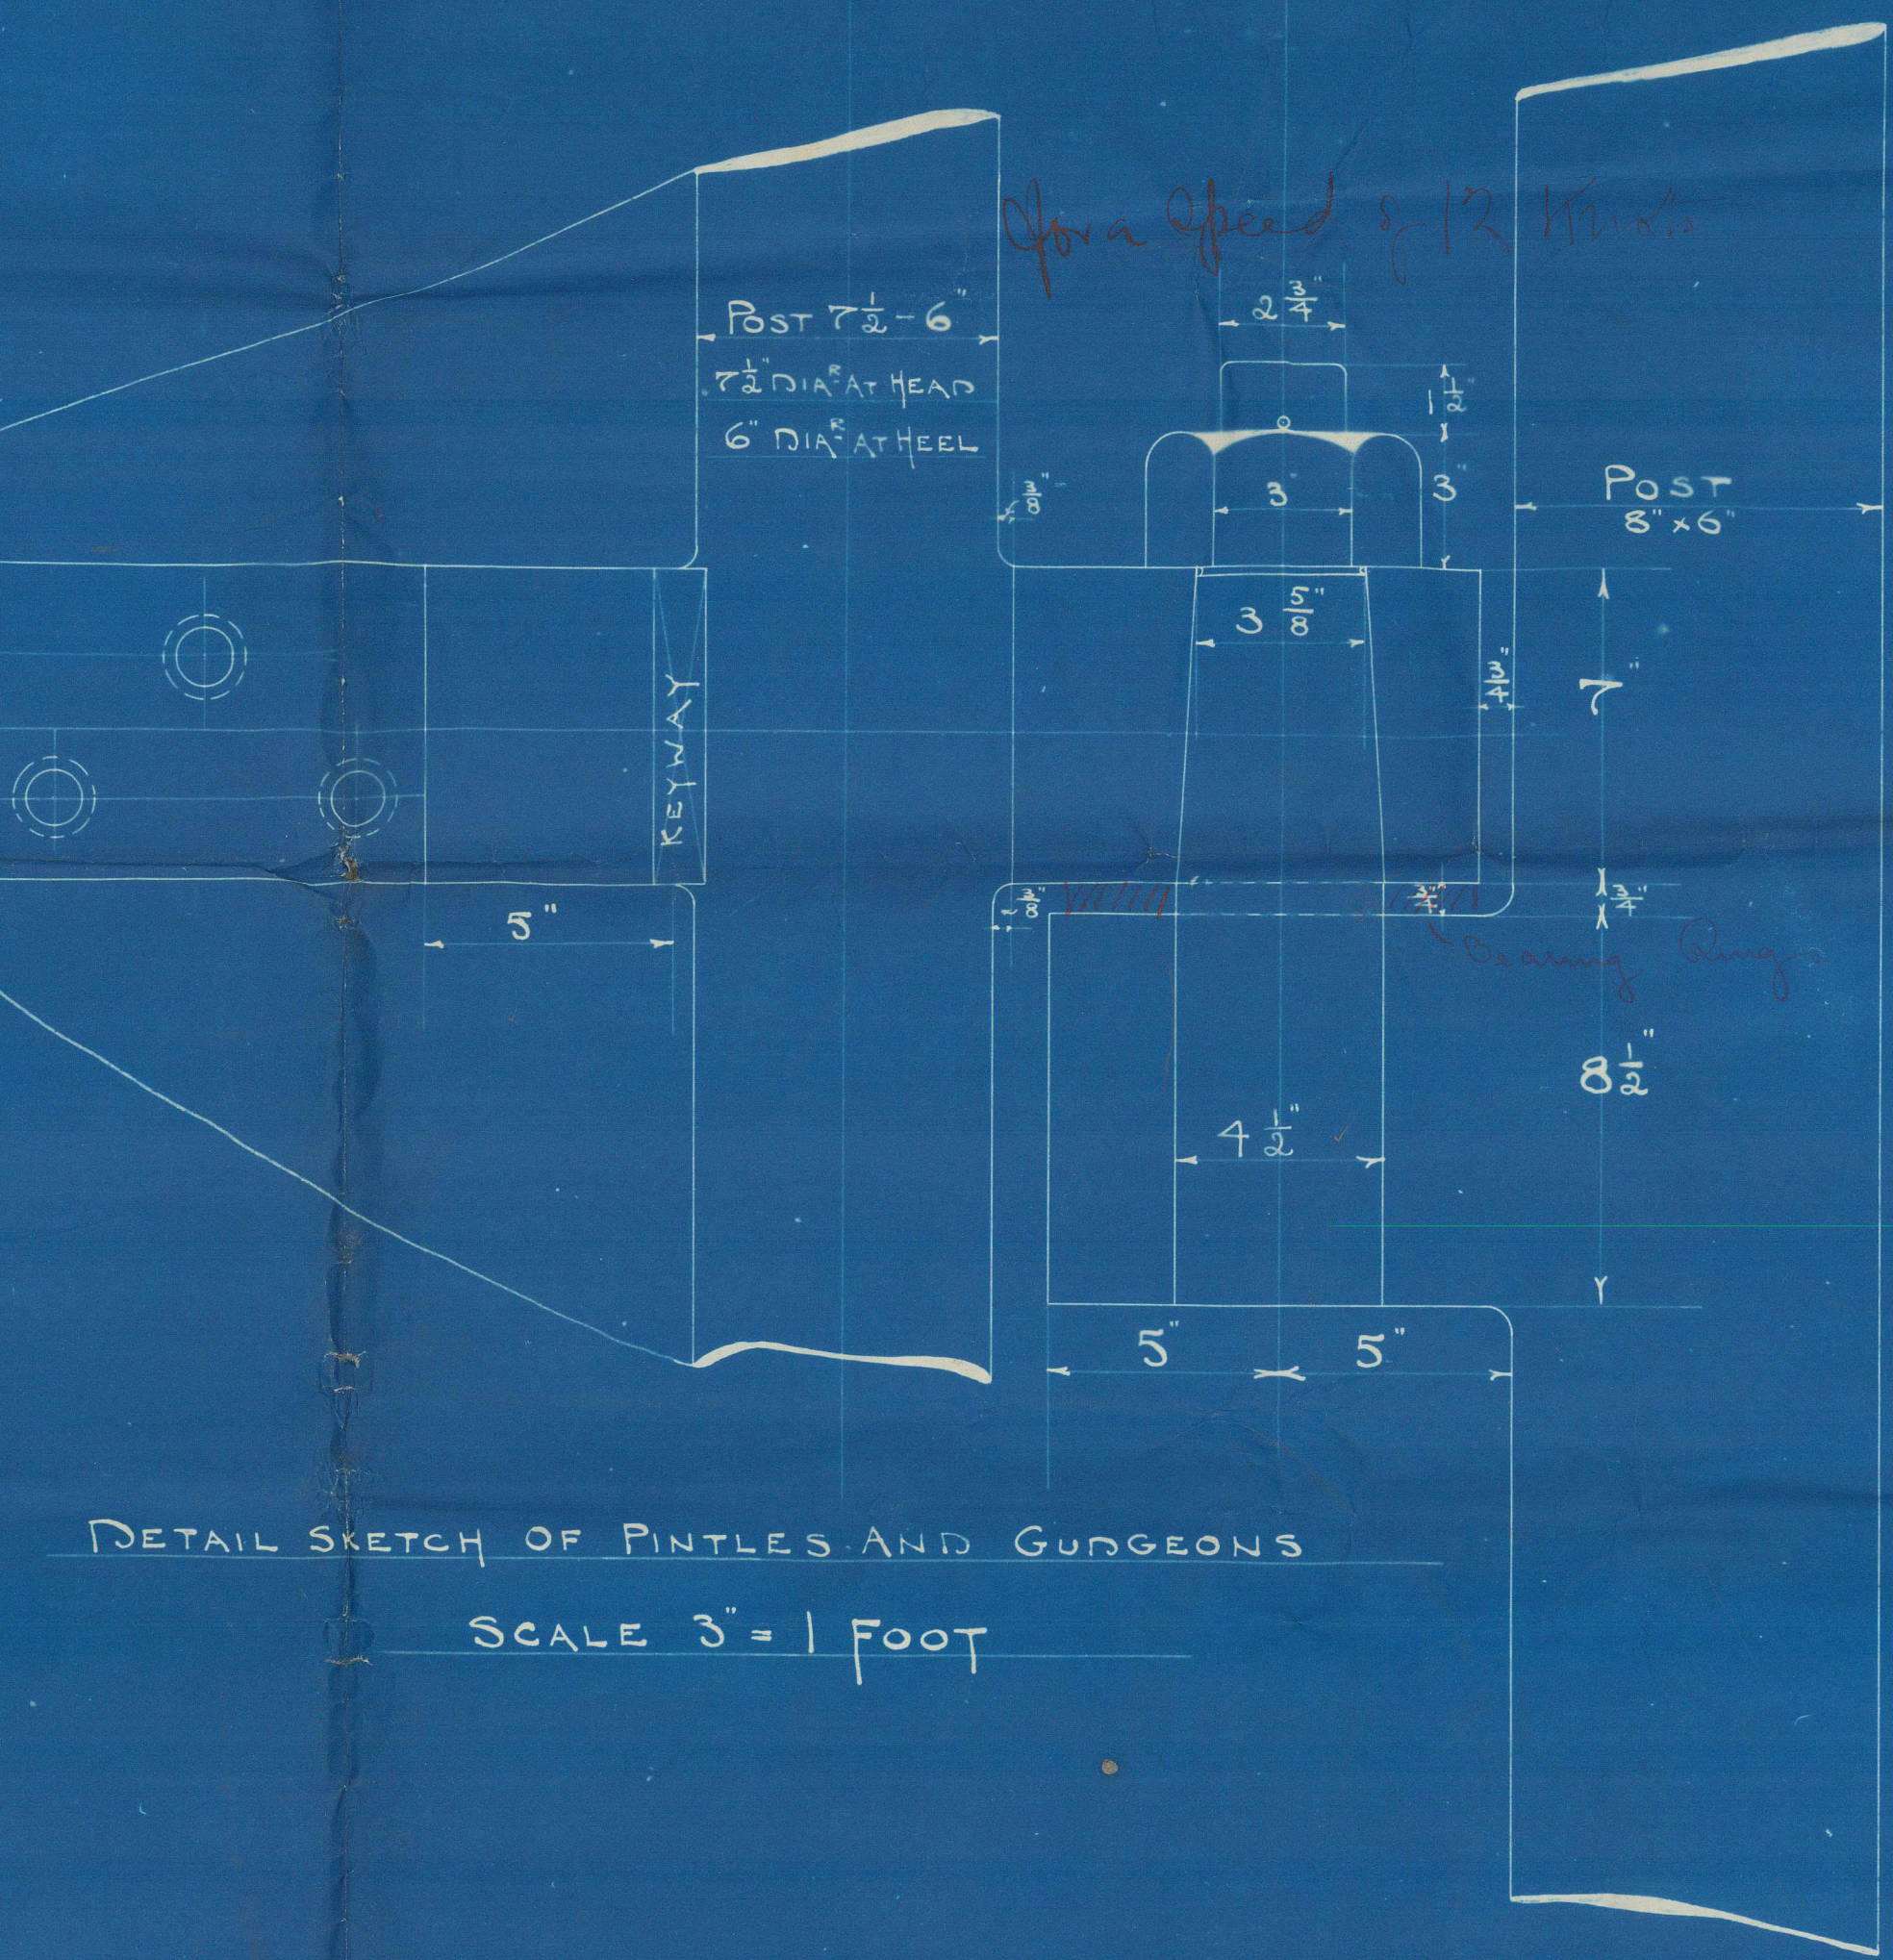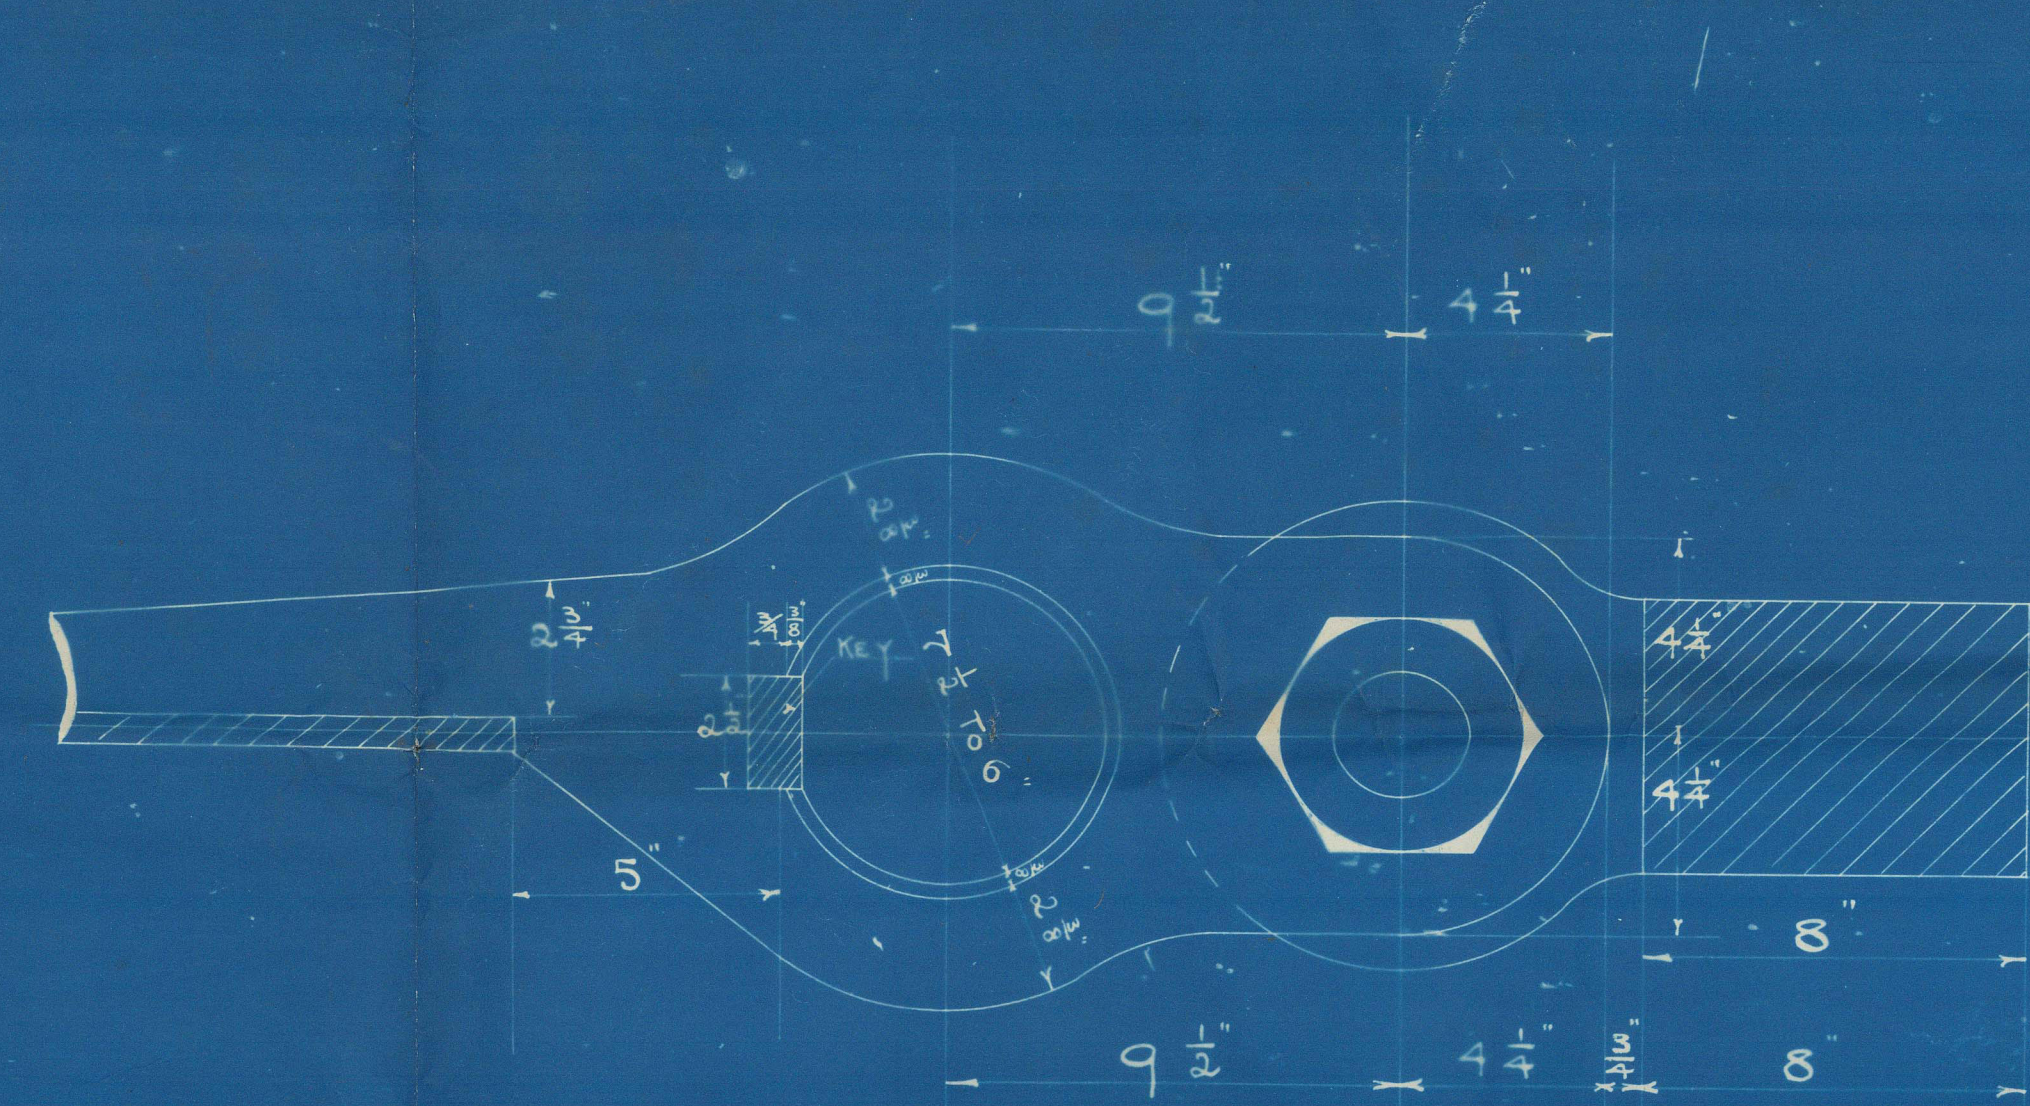

DETAIL SKETCH OF PINTLES AND GUDGEONS  
SCALE 3"=1 FOOT

STERNPOST AND RUDDER  
SHIP NO. 222  
SCALE 1" & 3"=1 FOOT

DETAIL OF HEEL PINTLE  
SCALE 3"=1 FOOT

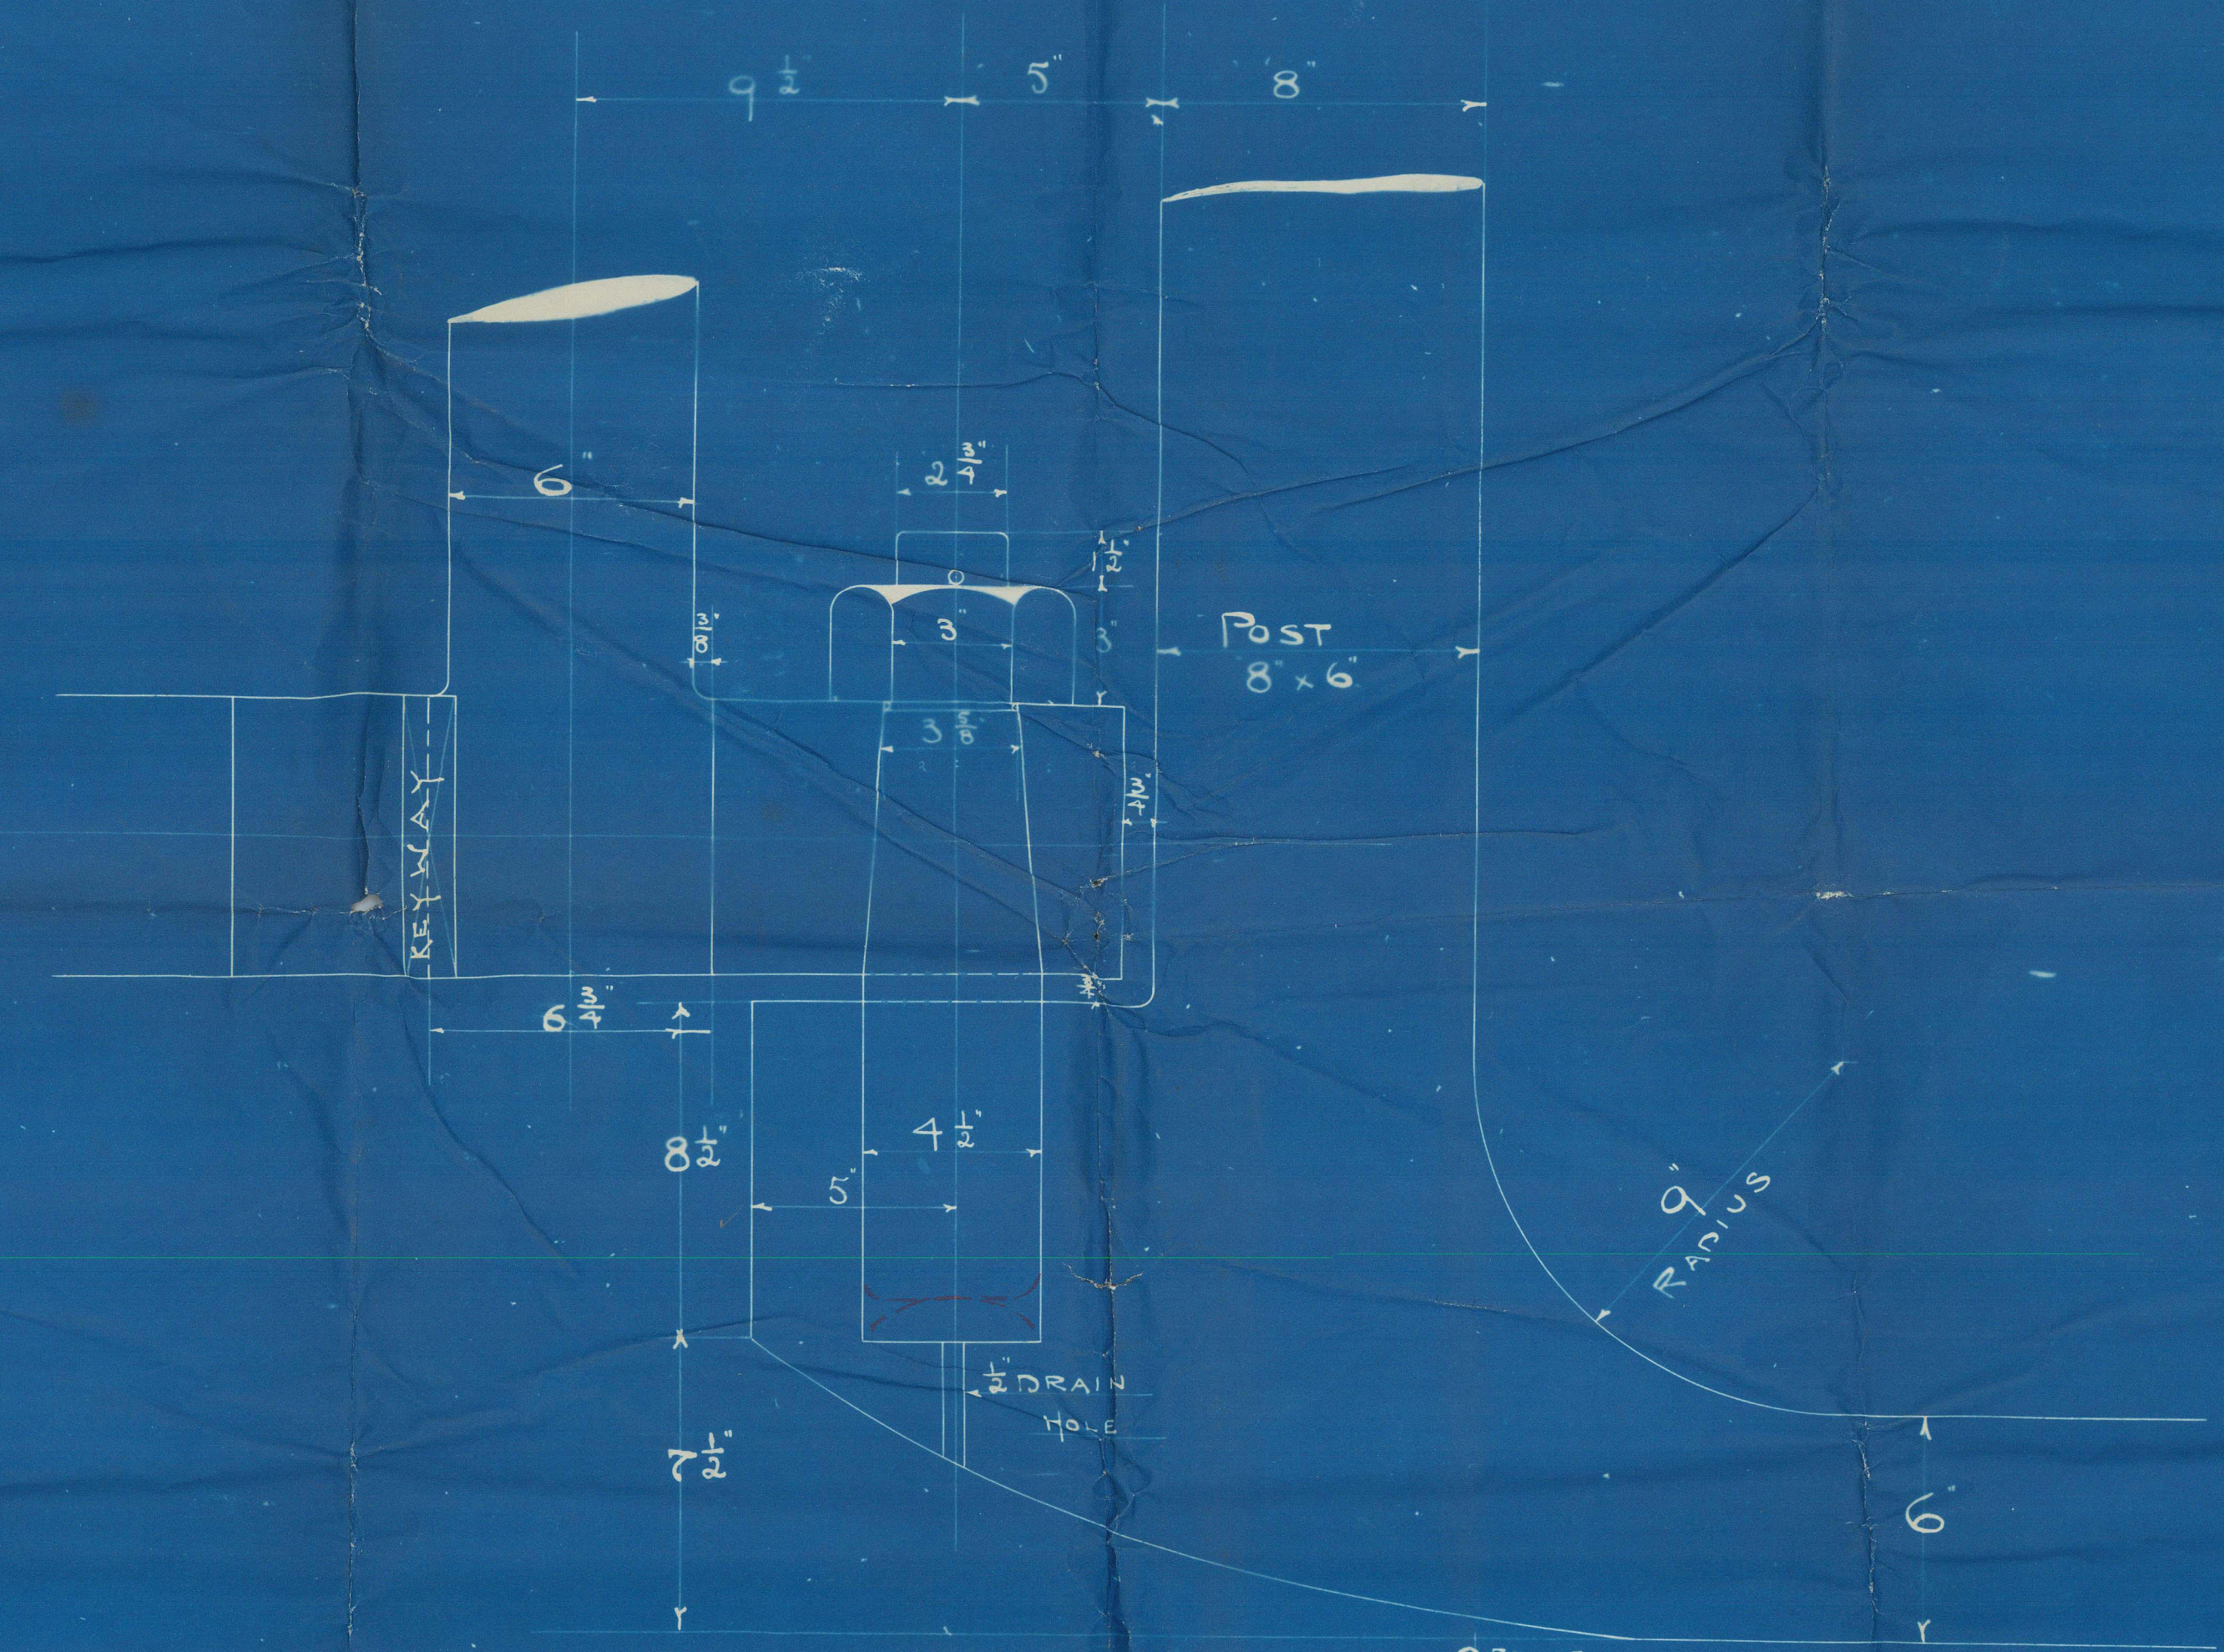

APPROVED  
6 MAR 1910

613376-013382-0105



Galedons 222

Rudder & Stern frame

S.S. Sanda.

NOW

MACOR.

now Yeh Hu


Enclon.

B.C.

222

Rudder

Stern frame

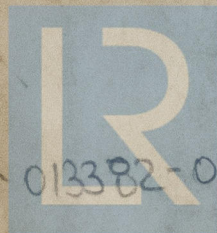

© 2021

Lloyd's Register  
Foundation

013 76 013382-0105