



1 FEB 1936

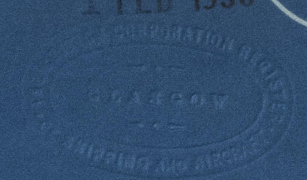

initials C 1/10



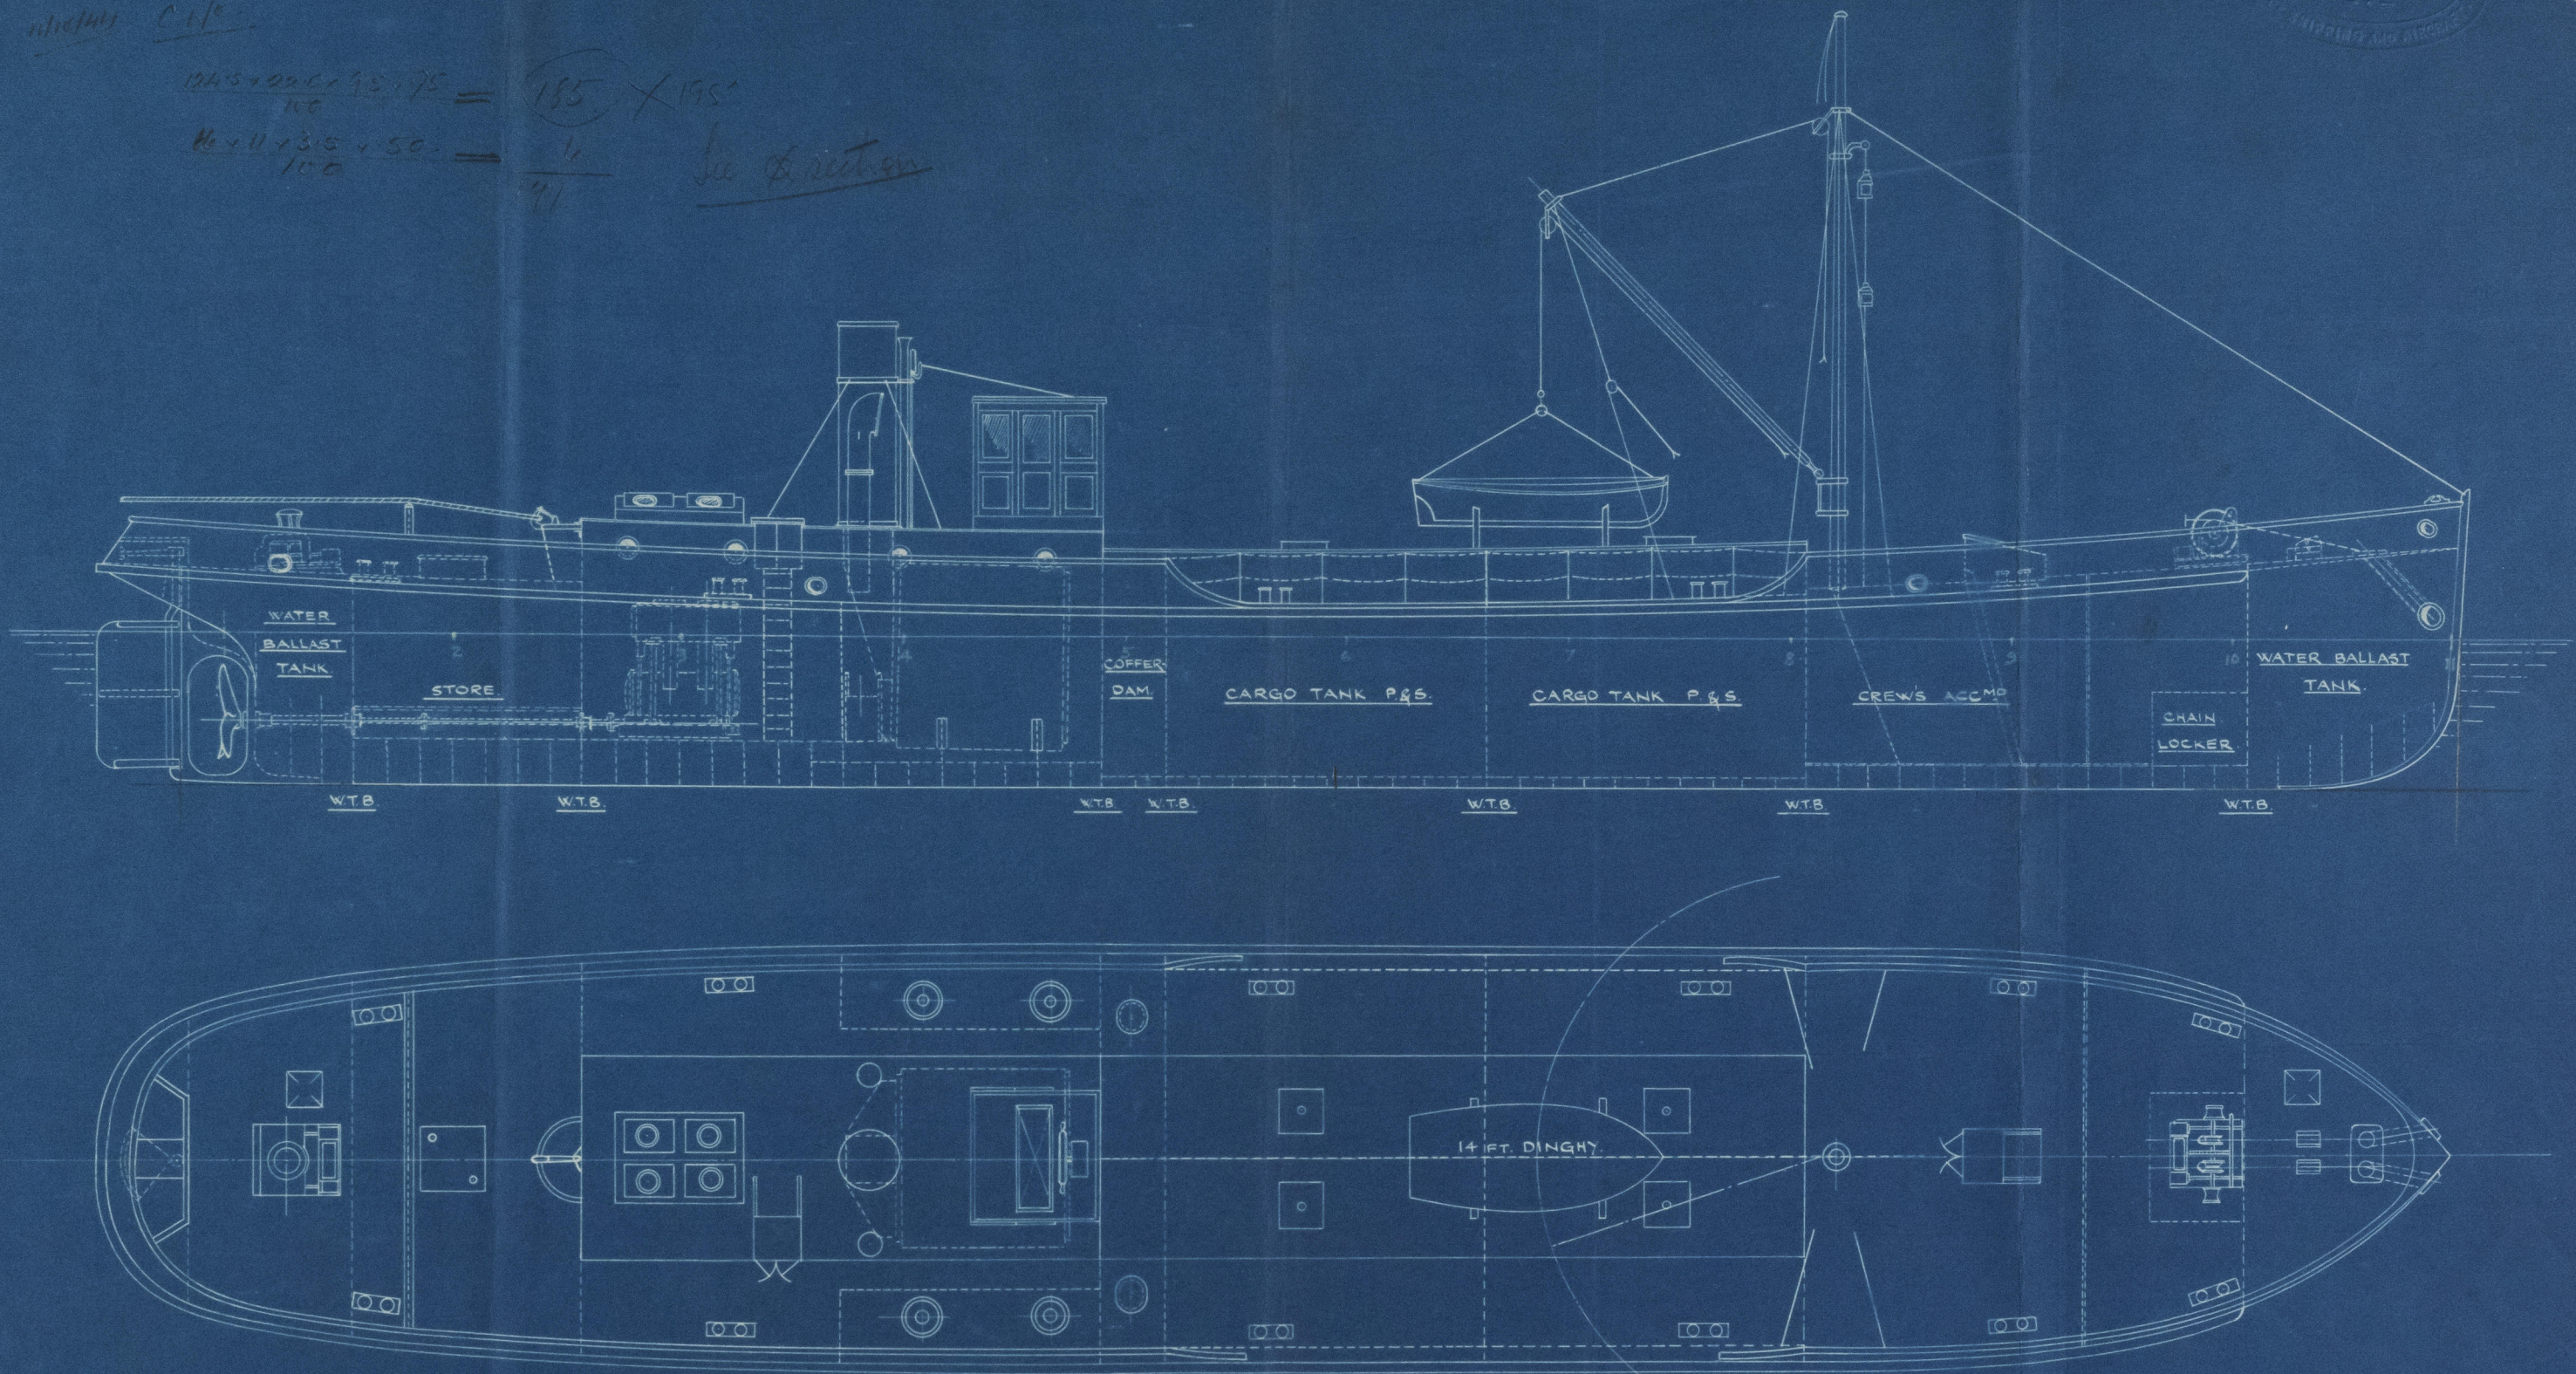

STEEL SINGLE SCREW STEAM DRIVEN TANK TAR BARGE.

DIMENSIONS:- 129'-6" OA x 124'-6" B.P. x 22'-0" MLD. x 9'-6" MLD

SCALE:- 1/8" = 1 FT.

TO CARRY 260 TONS DW. ON 8'-0" DRAFT.



TRACING No 2591A
DRAWER No 5
20-1-36. EST. 2320.


32

General Airt.


Howhedge Ironworks Co.

Nº 226.

Reference

TARGET.

Gen. Airt.
Howhedge 226.

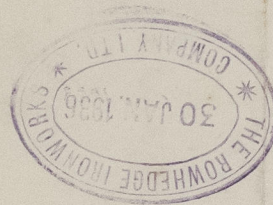

013376-013382-0278



© 2021

Lloyd's Register
Foundation