
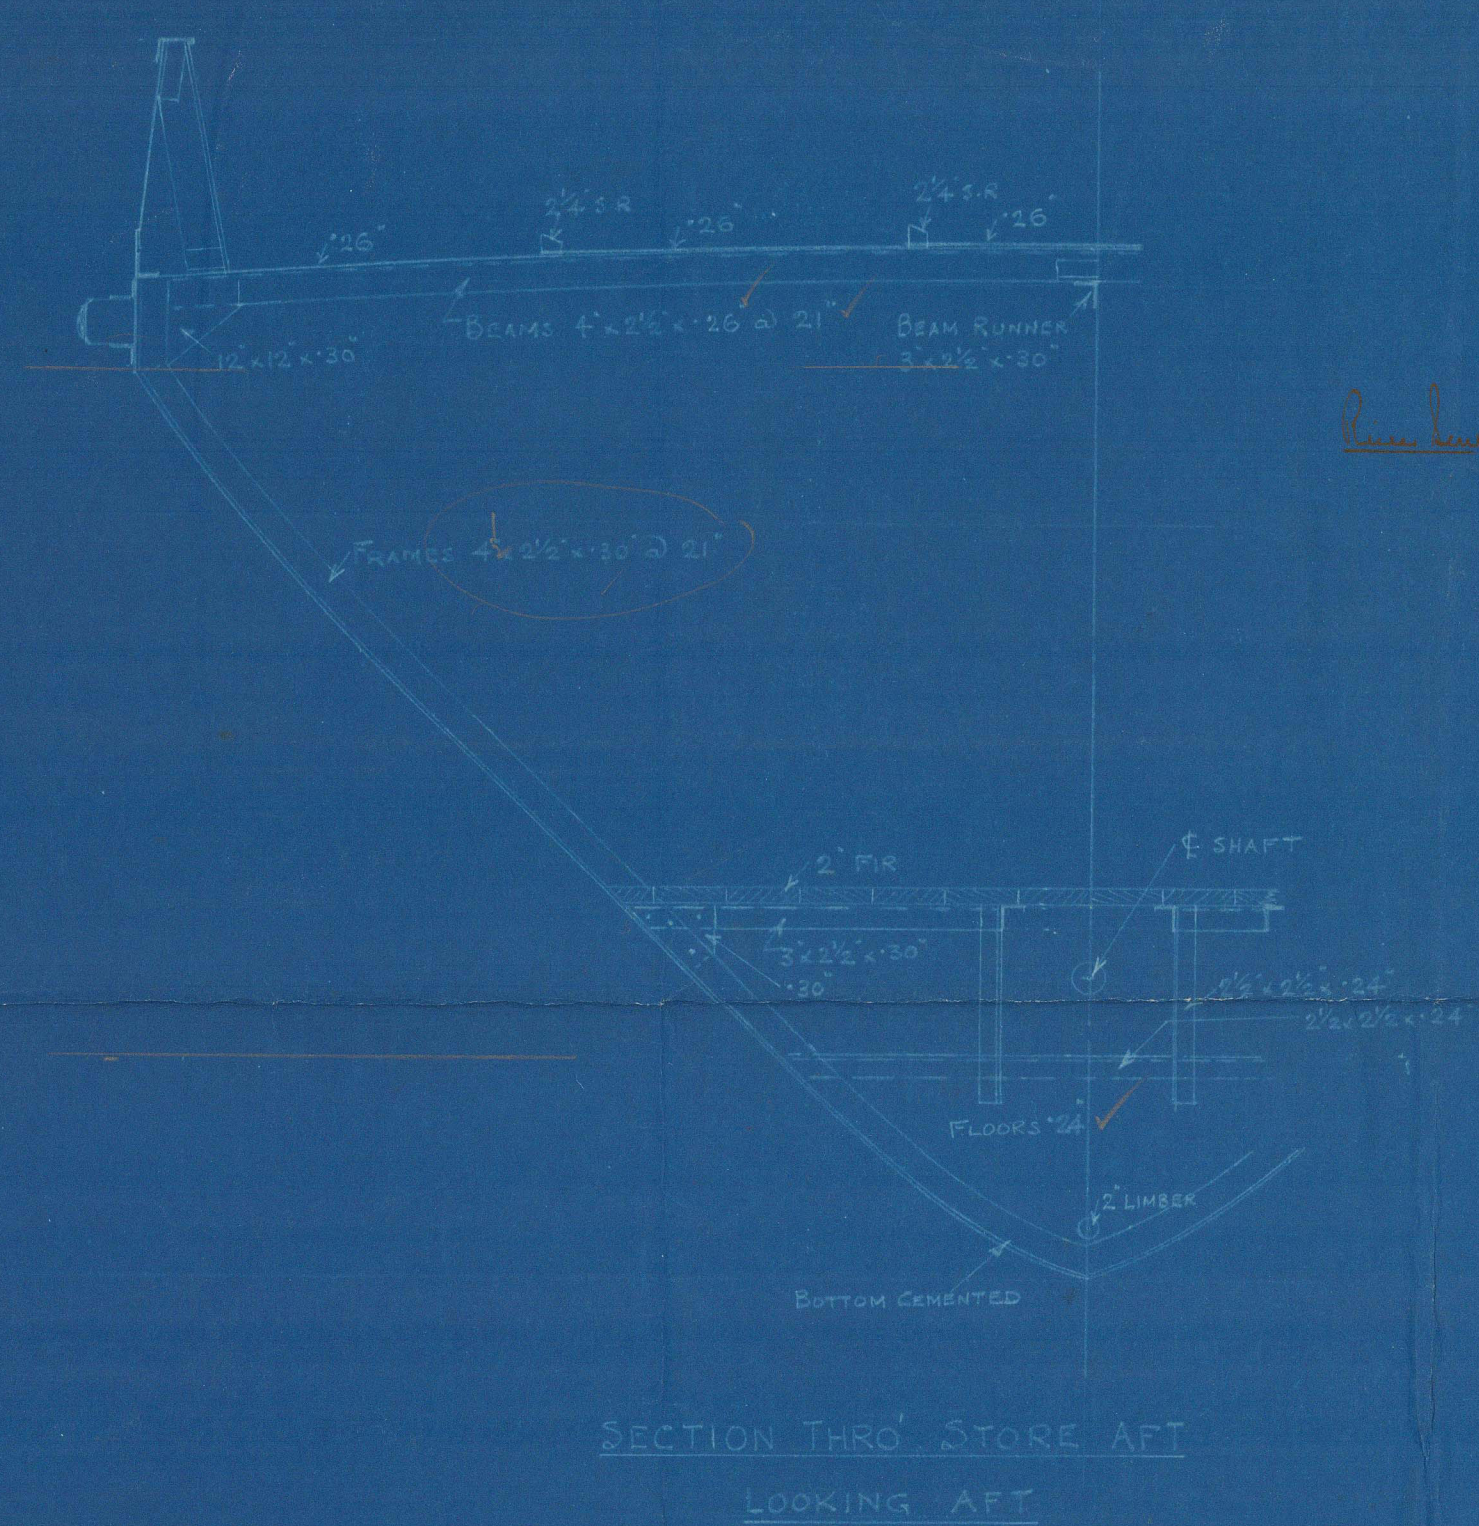
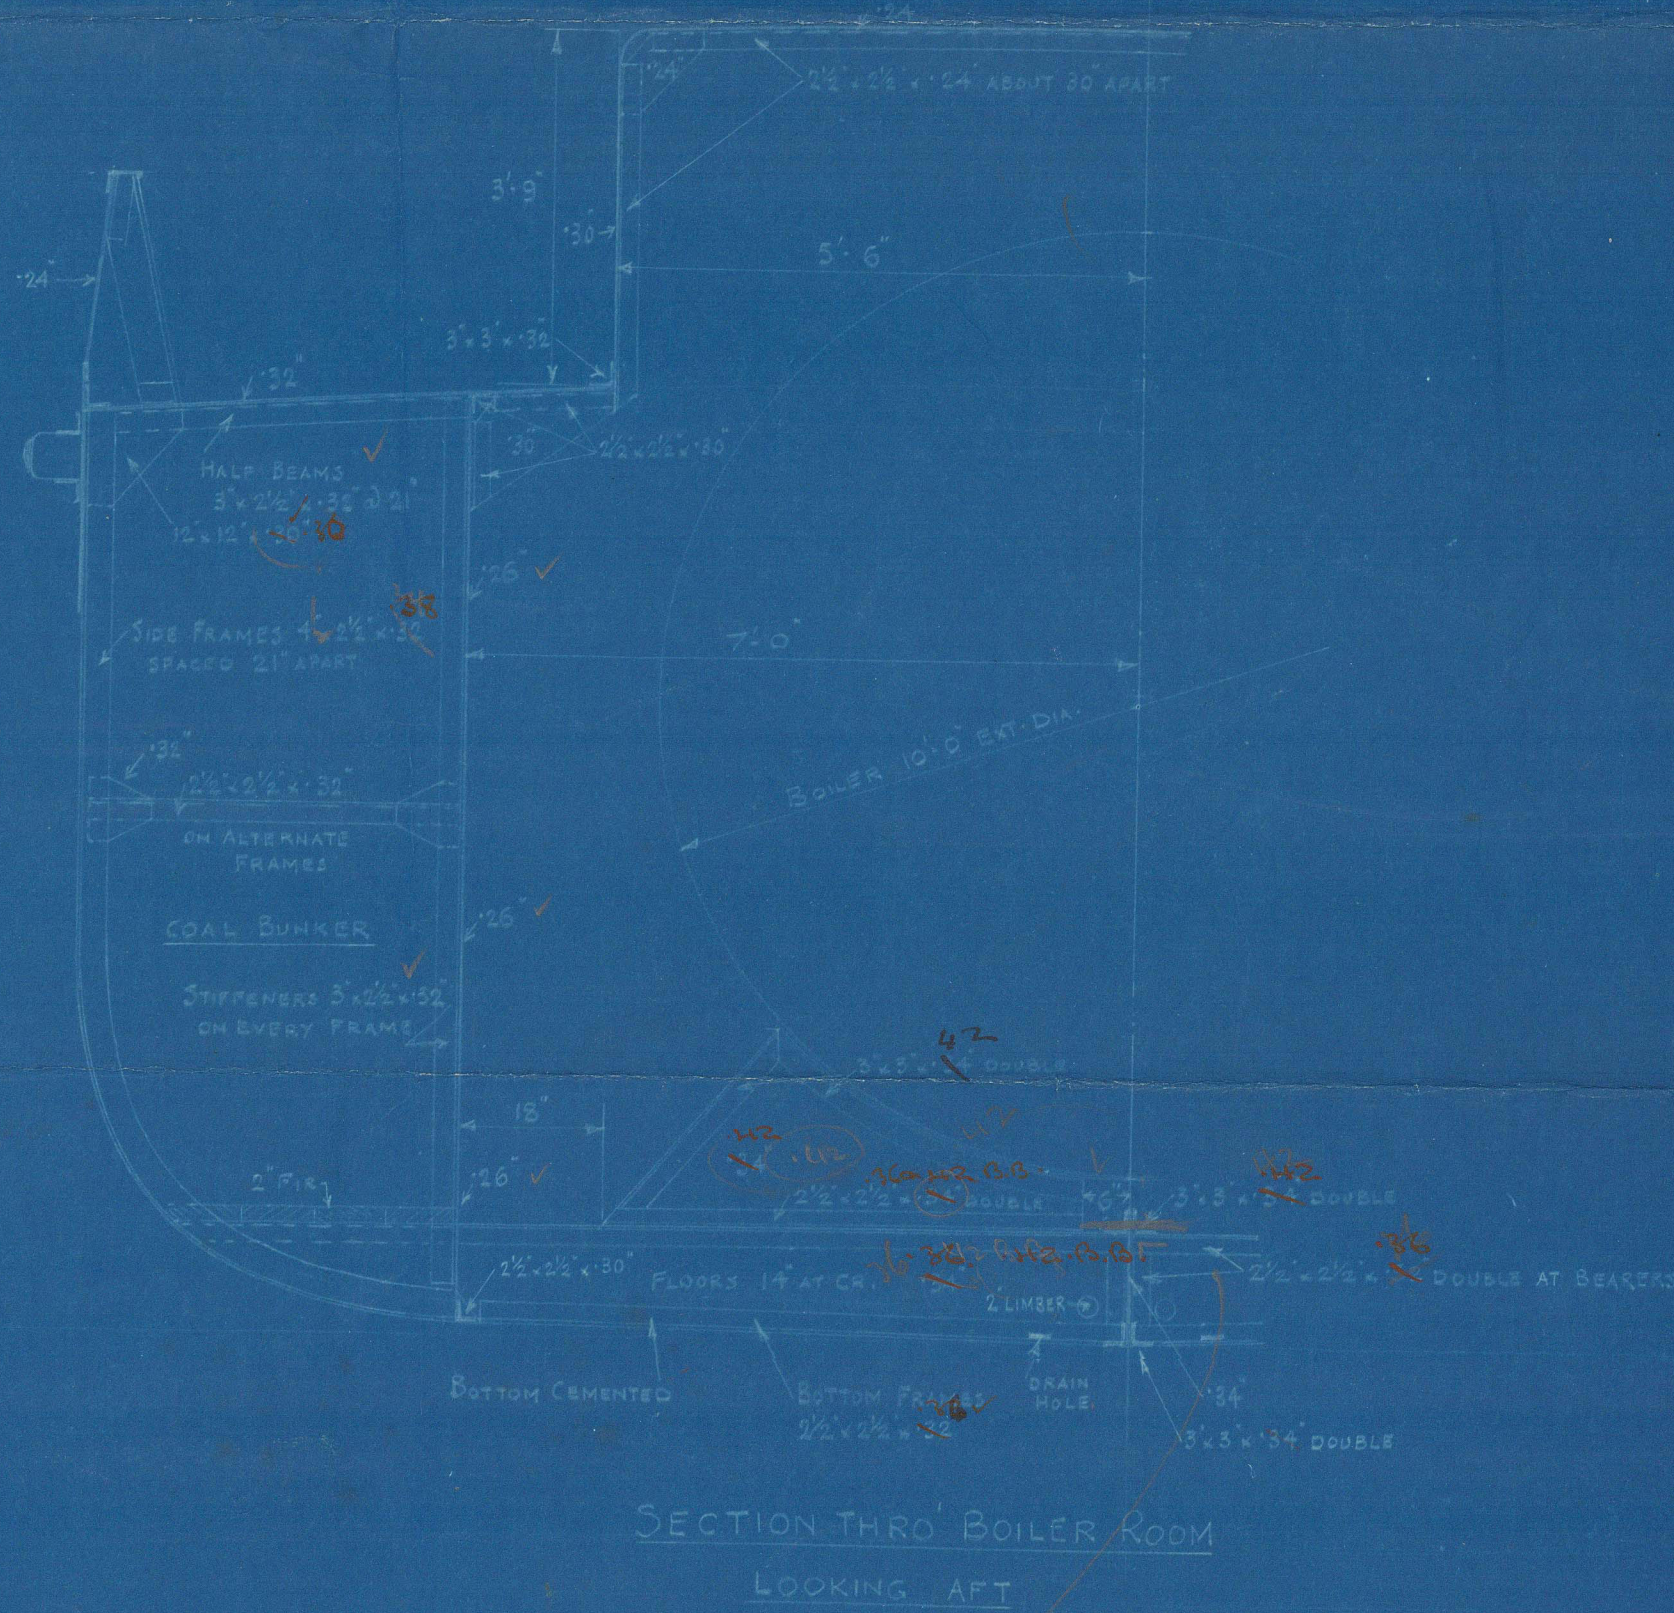
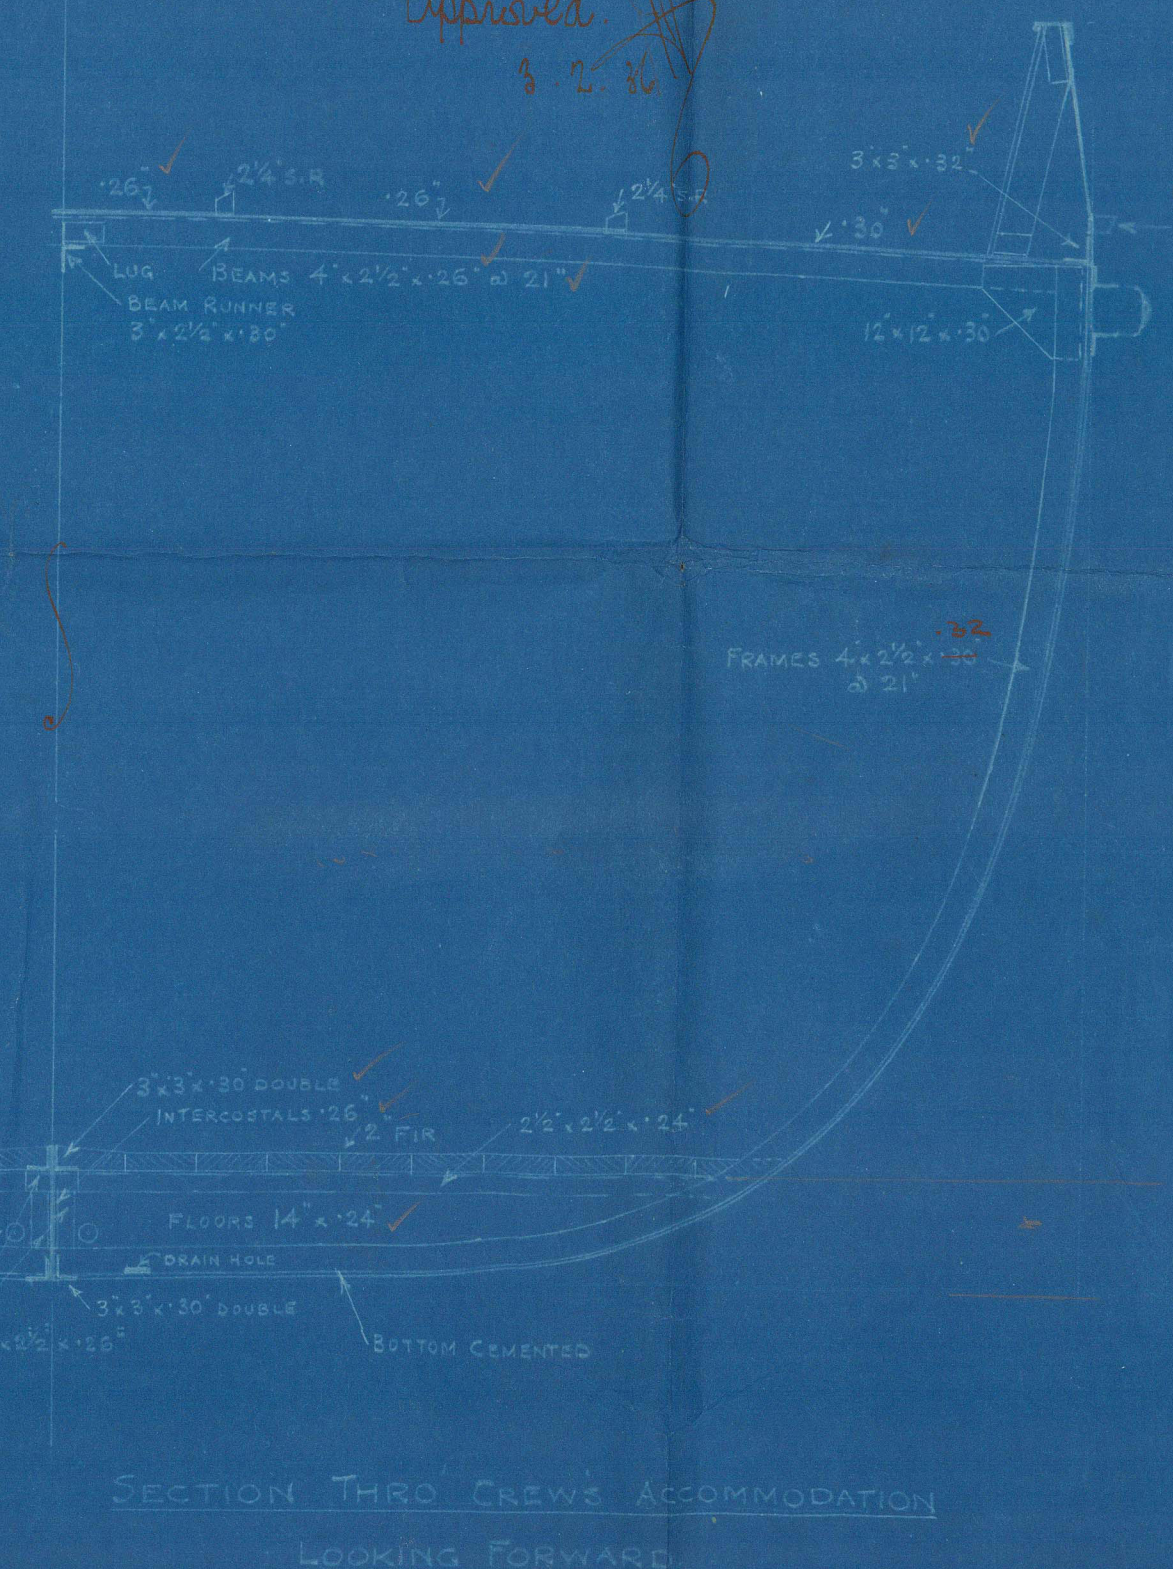
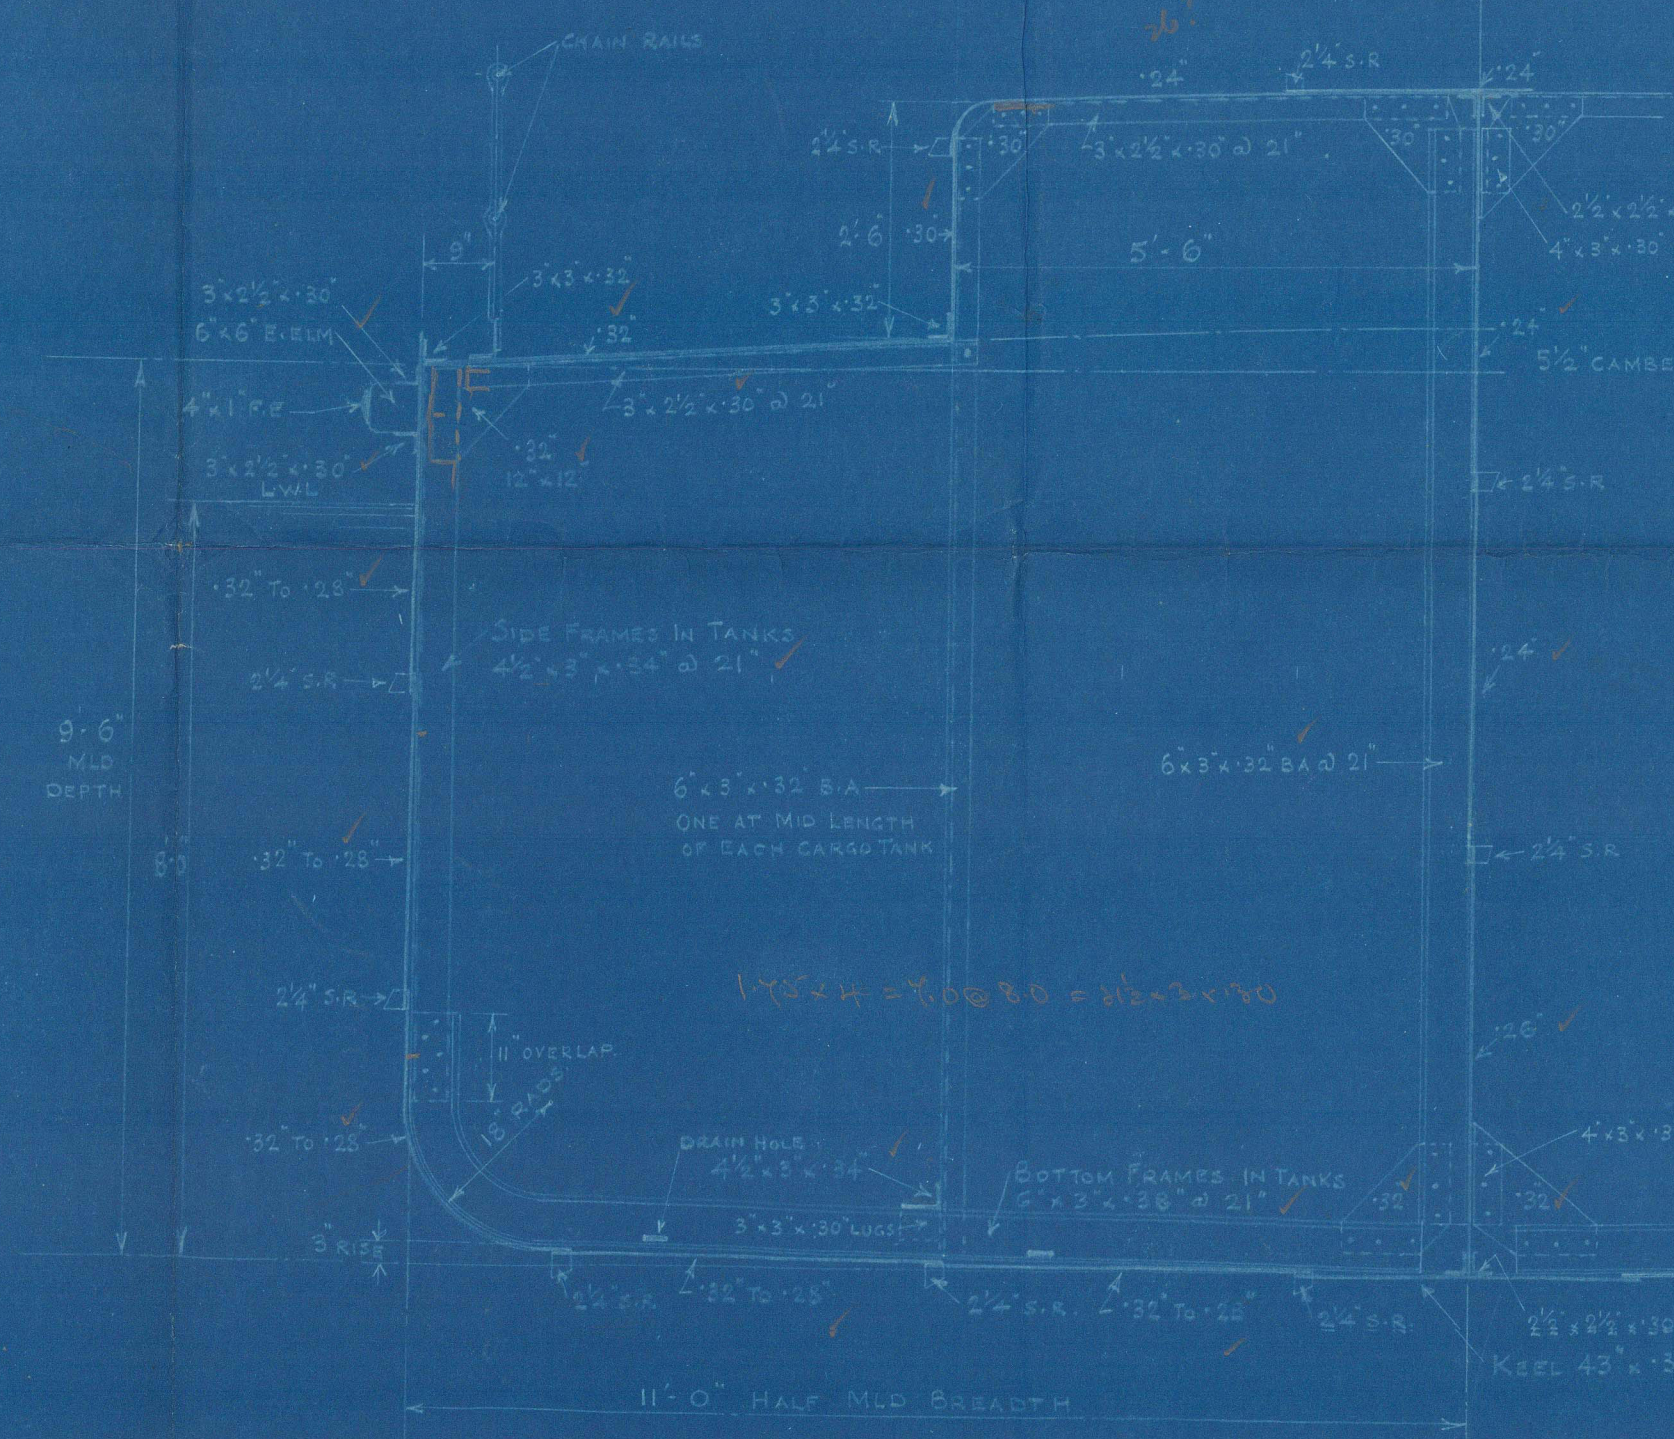


124.5  $\times$  22  $\times$  9.5  $\times$  7.5 = 195  
 66  $\times$  11  $\times$  3.5 = 257  
 100

1 FEB 1936

Approved  
 3.2.36

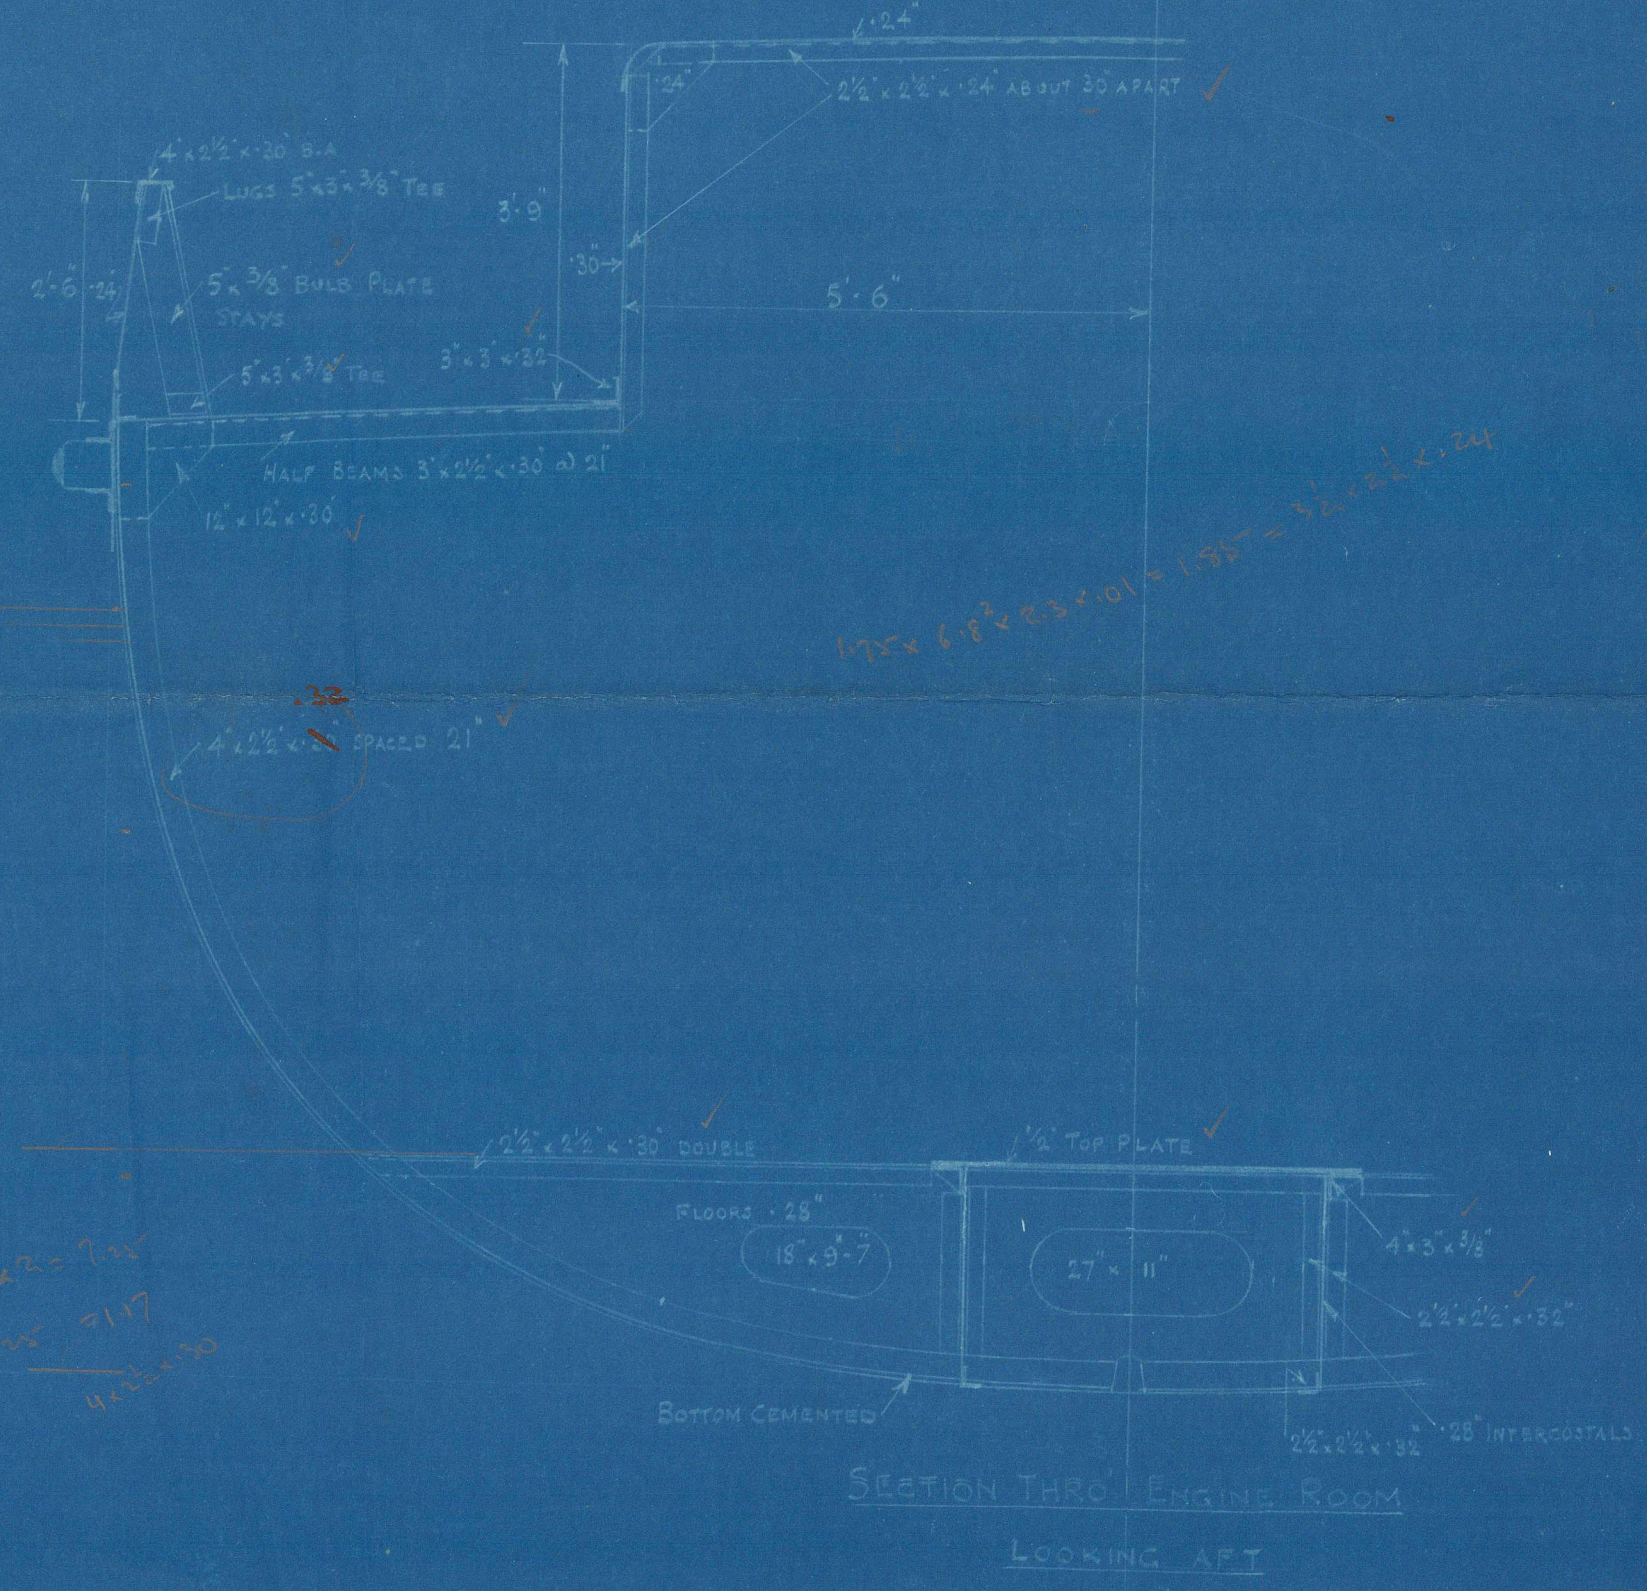


- EQUIPMENT**
- 8 POWER ANCHORS EACH 6 CWT'S TOTAL WEIGHT STOCKLESS
  - 1 STREAM ANCHOR 3 1/4 CWT'S EX STOCK
  - 20 FMS 1 1/2" DIA STUD LINK CHAIN CABLE
  - 60 FMS 5 1/2" HEMP HAWSE
  - 60 FMS 3 1/2" HEMP WARP

TO CLASS BS \* RIVER SERVICE

5526  
 TRANSVERSE SECTIONS  
 SCALE 1/2" = 1'-0"

TRACING No 6471  
 DRAWER No 9

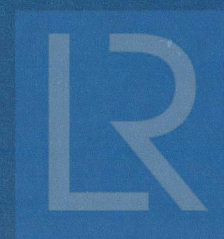

Lloyd's Register Foundation




Sections.  
Howhedge 526.

~~MOB. RPT. No. 19195.~~

T.C. 11. 3. 36.

TARGET

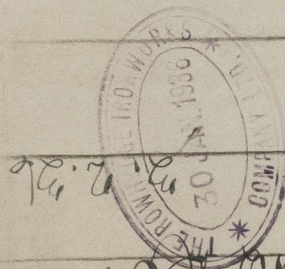

No. 526.

Howhedge & Sonwick 100.

Howhedge & Sonwick 100.

© 2021



Lloyd's Register  
Foundation

013376-013382-0279