


2 MAR 1936
 Approved
 12th March, 1936
 H.S. for S.F.K.

LIST OF PIPES.

Ref.	Bores	Material	Description
1	2 1/2"	C.P.	MAIN STEAM PIPE.
2	2 1/2"	AC	AUX. " " " "
3	3"	"	DECK " " " "
4	"	AF	WASTE " " " "
5	1 1/2"	"	WHISTLE " " " "
6	1 1/2"	AC	STEAM TO STEERING ENGINE.
7	1 1/2"	"	" " " " " "
8	1 1/2"	"	" " " " " "
9	1 1/2"	"	" " " " " "
10	3/4"	"	" " " " " "
11	"	"	" " " " " "
12	"	"	" " " " " "
13	1 1/2"	AF	SCUM TO SHIP'S SIDE TEE PIECE.
14	"	"	" " " " " "
15	1"	AC	DONKEY PUMP EXHAUST.
16	"	"	" " " " " "
17	1 1/2"	"	HEATING COILS " " " "
18	1 1/2"	"	SEPARATOR DRAIN TO TANK RES.
19	2"	AC	STEERING ENGINE EXHAUST.
20	1 1/2"	AF	STEAM TO PRESSURE GAUGE.
21	1 1/2"	AC	STEAM TO PRESSURE GAUGE.
22	1 1/2"	AC	STEAM TO PRESSURE GAUGE.
LIST OF FITTINGS.

Ref.	Bores	Material	Description
A	2 1/2"	AF	BOILER MAIN STOP VALVE.
B	"	"	" " " " " "
C	"	"	" " " " " "
D	2 1/2"	"	" " " " " "
E	1 1/2"	GM	WHISTLE VALVE.
F	"	"	" " " " " "
G	"	"	" " " " " "
H	1 1/2"	GM	MAIN FEED CHECK VALVE, WITH DOUBLE GLAND BY ANGLE CONE.
I	1 1/2"	"	" " " " " "
J	1 1/2"	"	" " " " " "
K	1 1/2"	"	" " " " " "
L	2 1/2"	GM	MAIN ENGINE STOP VALVE, (ON ENGINE).
M	VARIOUS	GM	AUX. STEAM DISTRIBUTION FITTING.
N	1 1/2"	GM	INTERCEPTOR STEAM SHUT OFF VALVE.
O	3/4"	"	" " " " " "
P	3/4"	"	" " " " " "
Q	1"	"	" " " " " "
R	1 1/2"	GM	" " " " " "
S	1 1/2"	GM	" " " " " "
T	1 1/2"	GM	" " " " " "
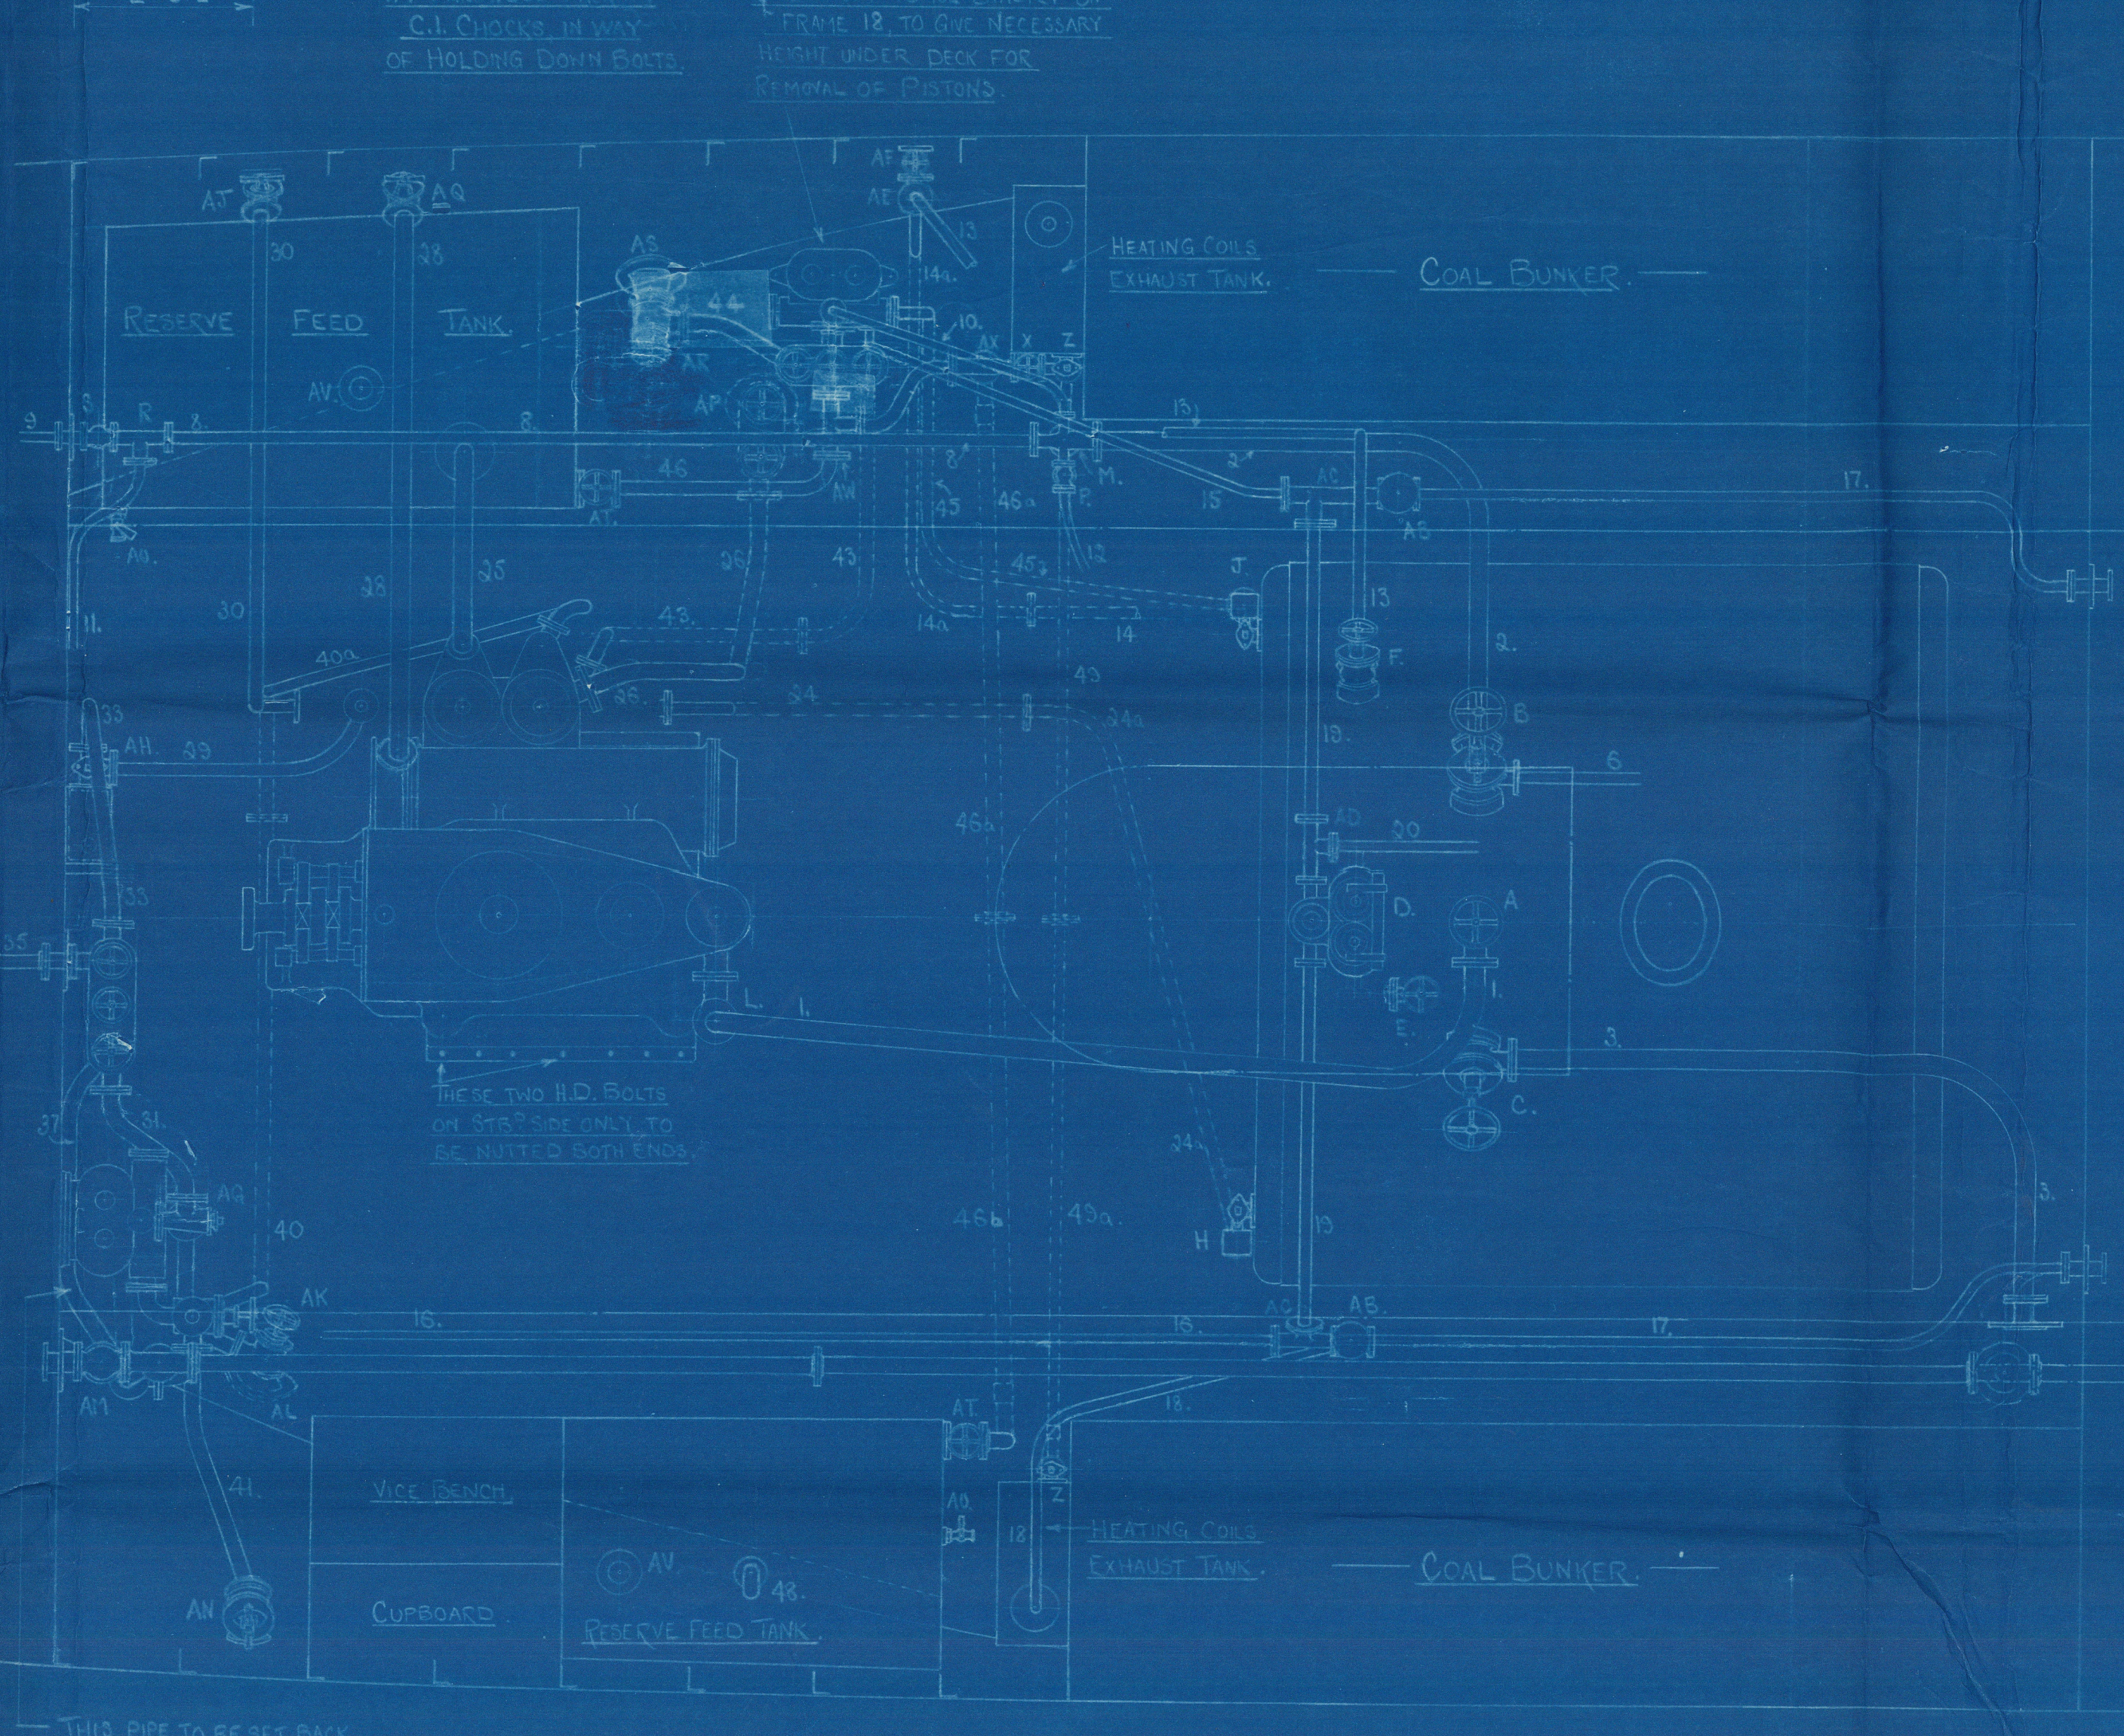

NOTE! DOUBLERS TO BE FITTED TO SHELL IN WAY OF ALL SUTTON SEATINGS.

SECTION AT FRAME 20, LOOKING FORWARD.

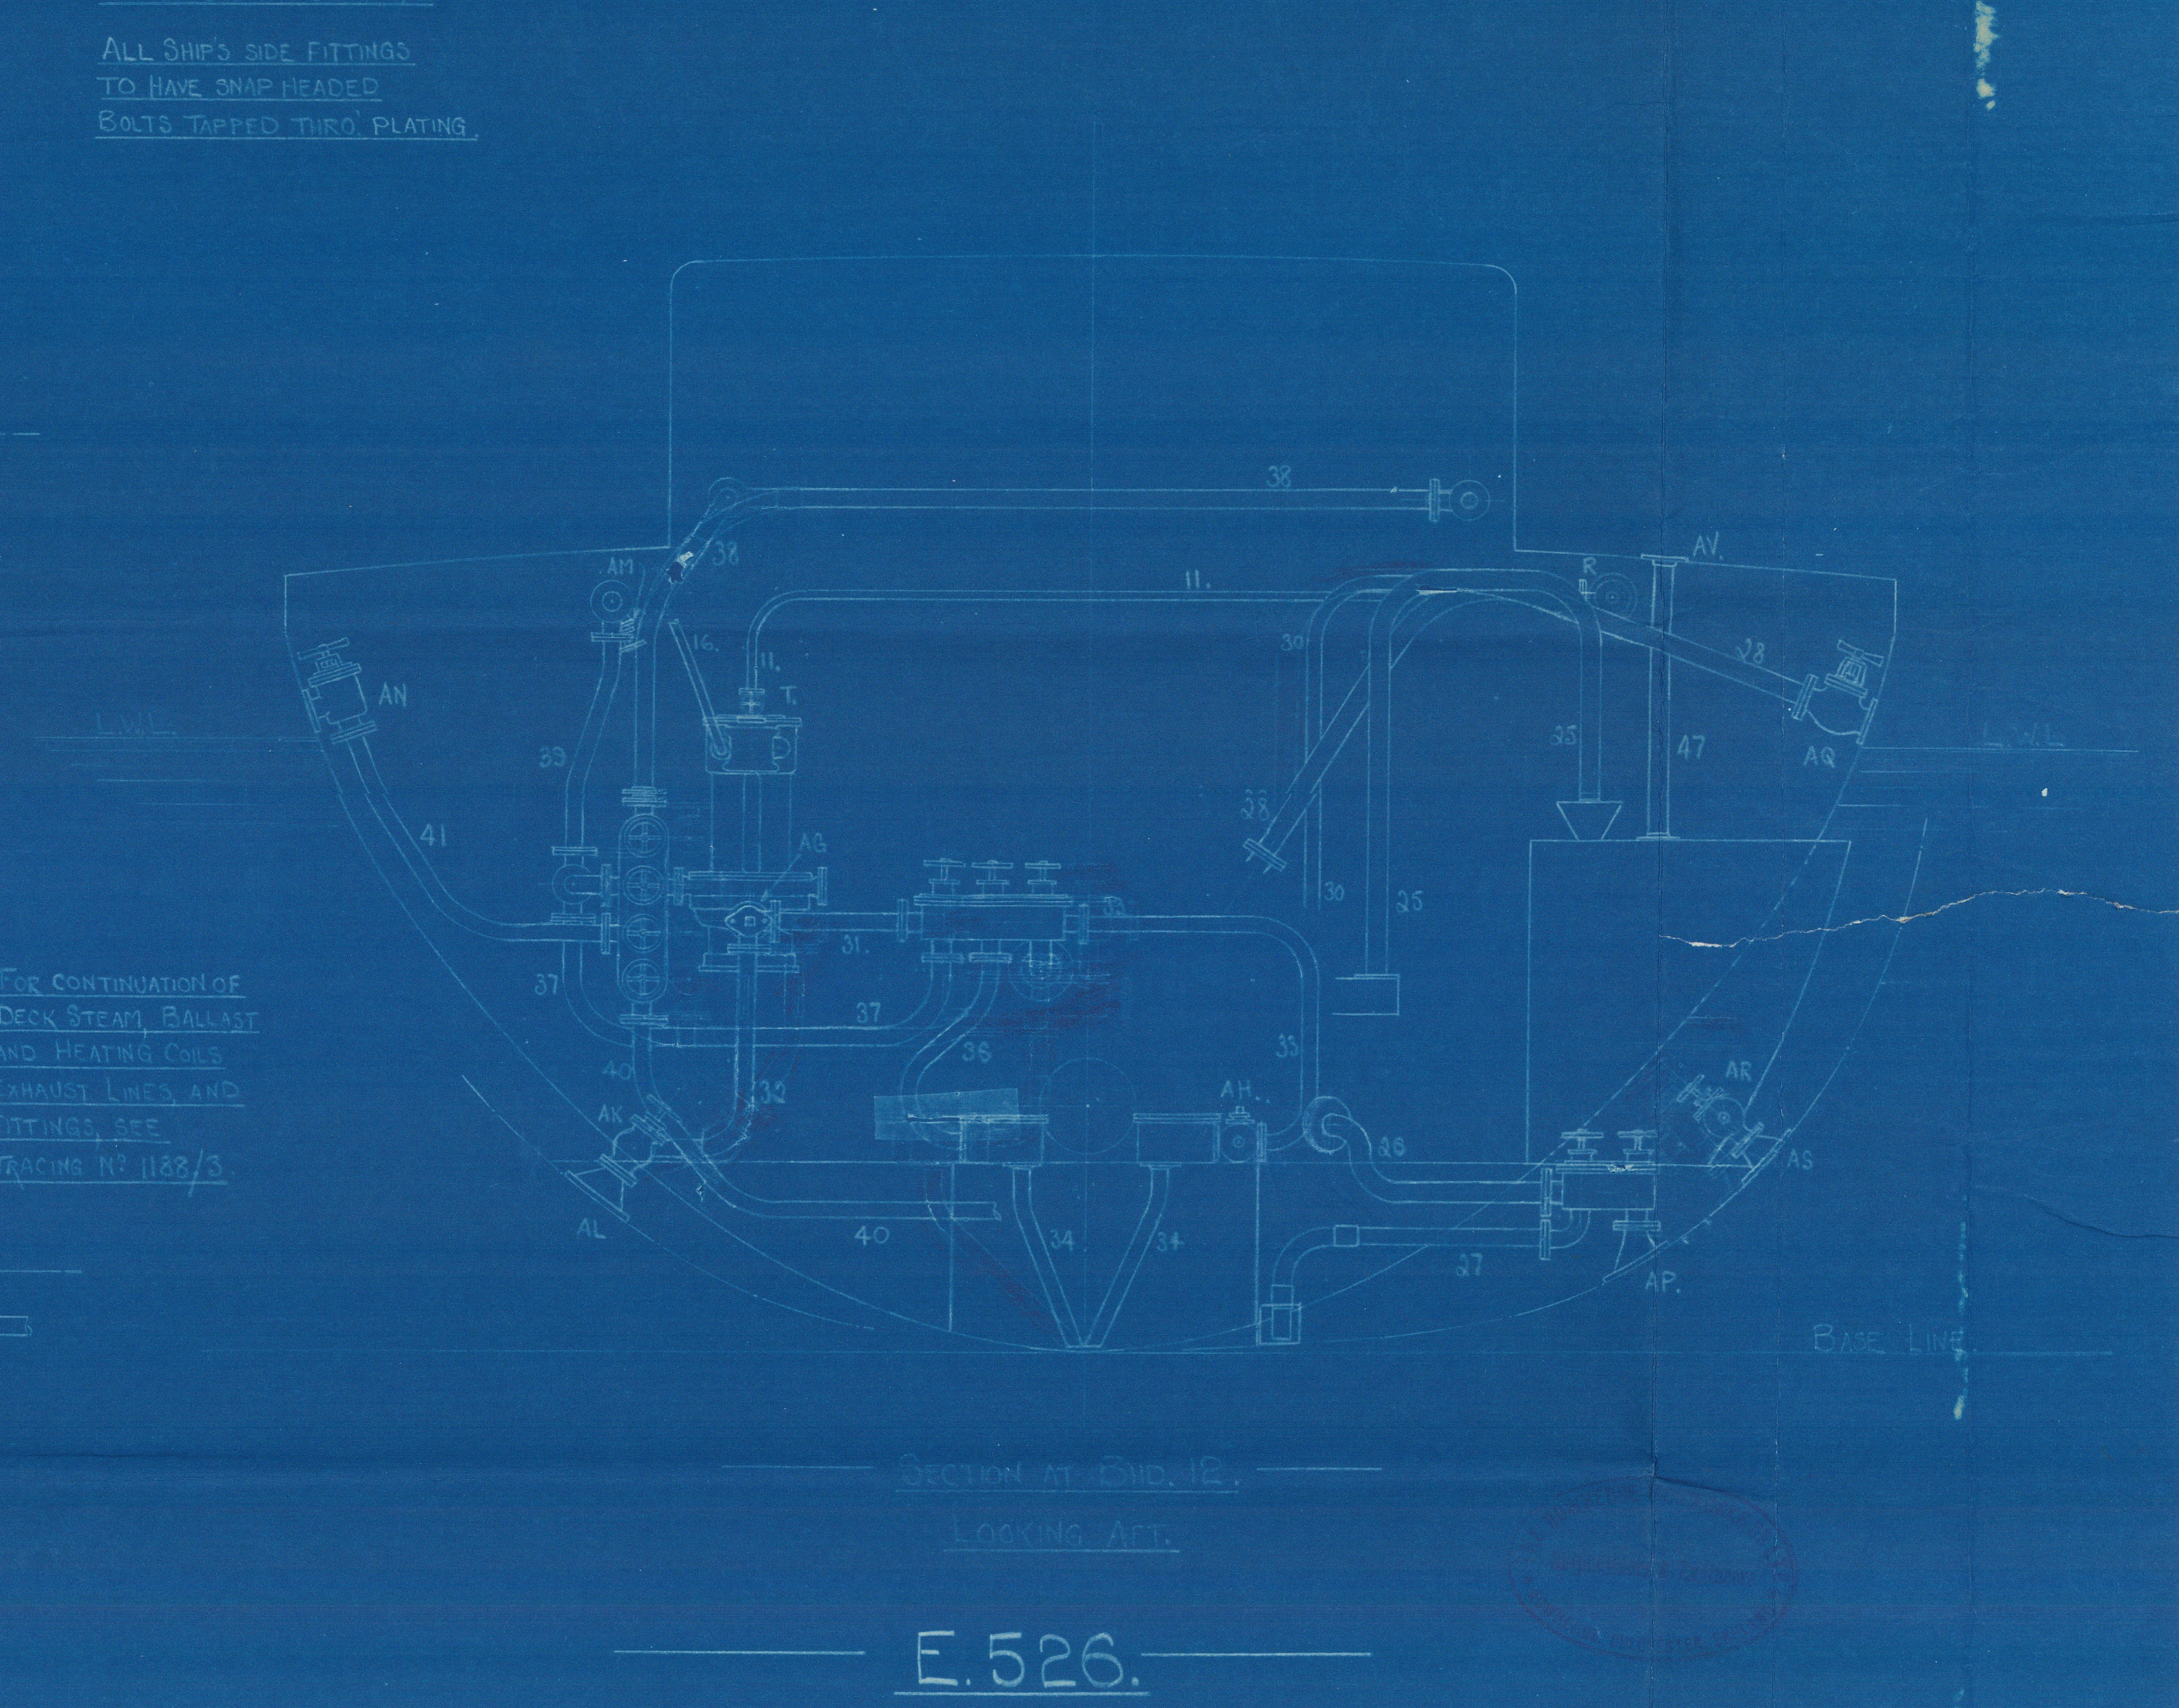


SECTION AT END 12, LOOKING AFT.

E.526.
 INSTALLATION PLAN.
 SCALE: 1/8" = 1 FOOT.

013376 - 013382 - 02 R1

Machy Installation
Howedge 526.

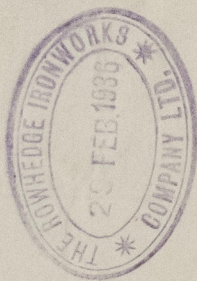

TARGET

12.2.26.

No 526.

Howedge Ironworks Co.

Machinery Installation

013376-013382-0281



© 2021

Lloyd's Register
Foundation