

Engine Room

Thermometers

Bulkhead

Shaft Alley

Thermometers

#4 Head



#5 Head

Plan of Shaft Alley



Weston Thermometer  
Model 2211  
50 to 500 °F Range  
Thread Pressure - 100 PSI

JOINT TO BE  
MADE W.T.

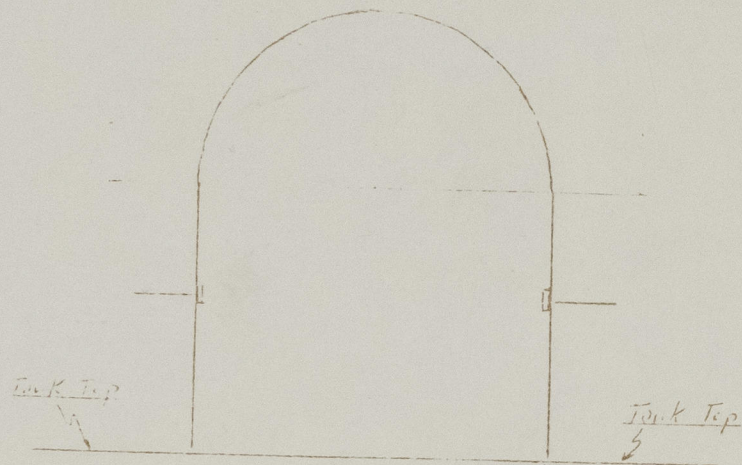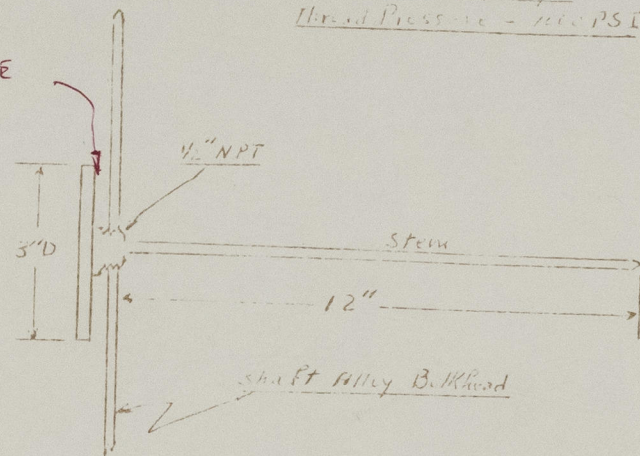

Cross Section  
of  
Shaft Alley

Details of Thermometer  
Connections

PROPOSED INSTALLATION  
FOR THERMOMETERS  
ON  
SS MOUNT LTHOME

Lloyd's Register  
Foundation

nyk. Rpt. 60967

013390-013396-0019