

PLAN NO. 2.

SHIP NOS. 344 & 5.

PROFILE AND DECKS.

SCALE: - 1/8" = ONE FOOT.

DIMENSIONS: - 370'-0" B.P. x 51'-0" B.M.D. x 26'-9" D.M.D. TO UPPER DECK.

CLASS: B.S.*

ENCLOSURE
No 267



22 JUN 1929

Approved
22 JUN 1929

OWNERS' REQUIREMENTS.
Bottom STRAKE OF STOWAGE BULKHEAD 1/4" OVER RULE.
FRAMES IN FORE AND AFTER FRAMES 1" OVER RULE.
WEATHER DECKS 1/2" OVER RULE.
STRINGER PLATES ONLY IN POOP, BRIDGE AND FORECASTLE
SPACES 1/4" OVER RULE.
TUNNEL TOP 3/4" THICK.
NOTE - RULE SCANTLING ARE SHOWN ON PLAN.
OWNERS' INCREASES ADDITIONAL TO THESE SCANTLING.

FORECASTLE DECK.
SHEATHED WITH 5/8" TEAK
5" TEAK UNDER WINDLASS

UPPER DECK.
SHEATHED WITH 5/8" TEAK
5" TEAK UNDER WINDLASS

31

Profile & Lecks.
Ardrossan Wkd. Ltd.

N^{os} 344-5.

28-6-29.

344. "Blairspey" *

345. Blairnevis

370'



© 2021

Lloyd's Register
Foundation

013390-013396-0041

31
Profile Deck

Addressed 3H413

Bag




© 2021

Lloyd's Register
Foundation

013390-013396-0041


MAIN FRAMES TO
 2" 3" 36" BA
 (RULE SCANTL
 24" FRAME

POOP DECK

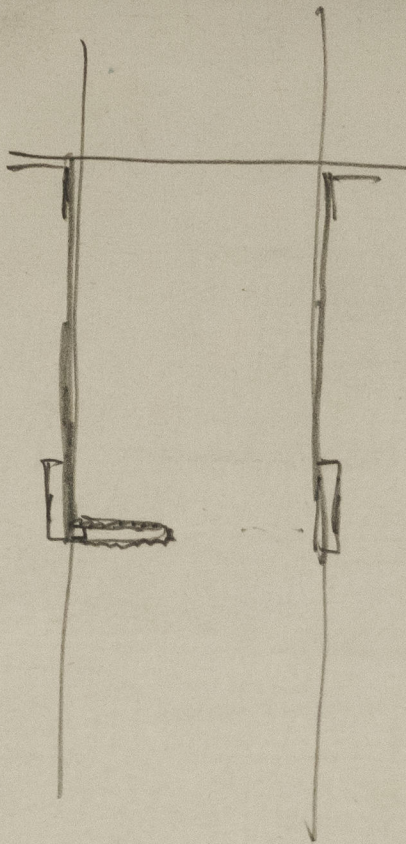

013390-013396-0045

RAISED QUARTER DECK

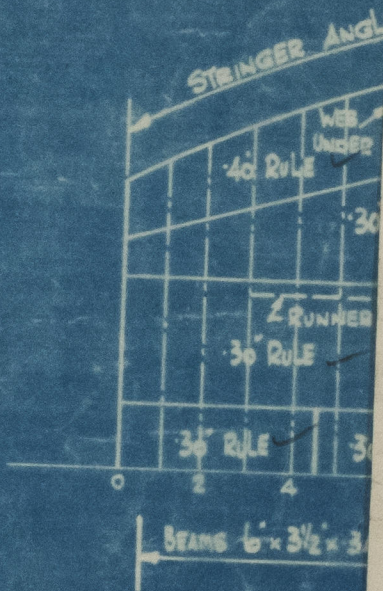

© 2021

Lloyd's Register
 Foundation