






OFFICE COPY

# S.S. BLAIRSPEY


## AMENDMENTS TO EXISTING COAL SIDE BUNKERS (P.S.)

FOR USE AS O.F. SETTLING TANKS


SCALE: 1/4" = 1 FT.

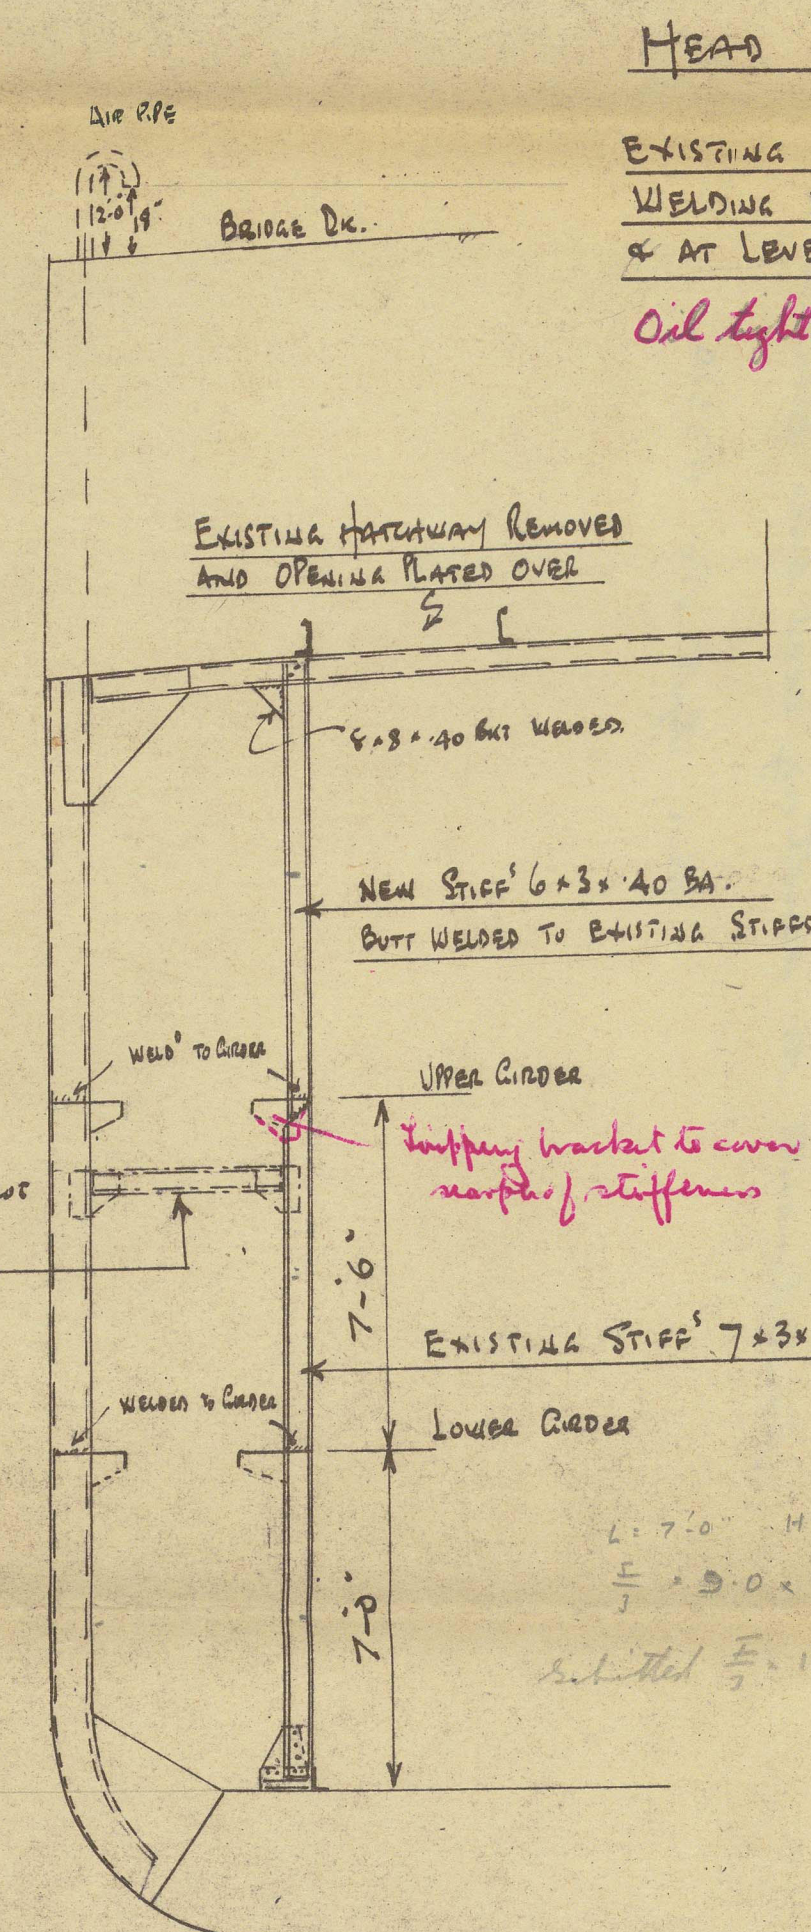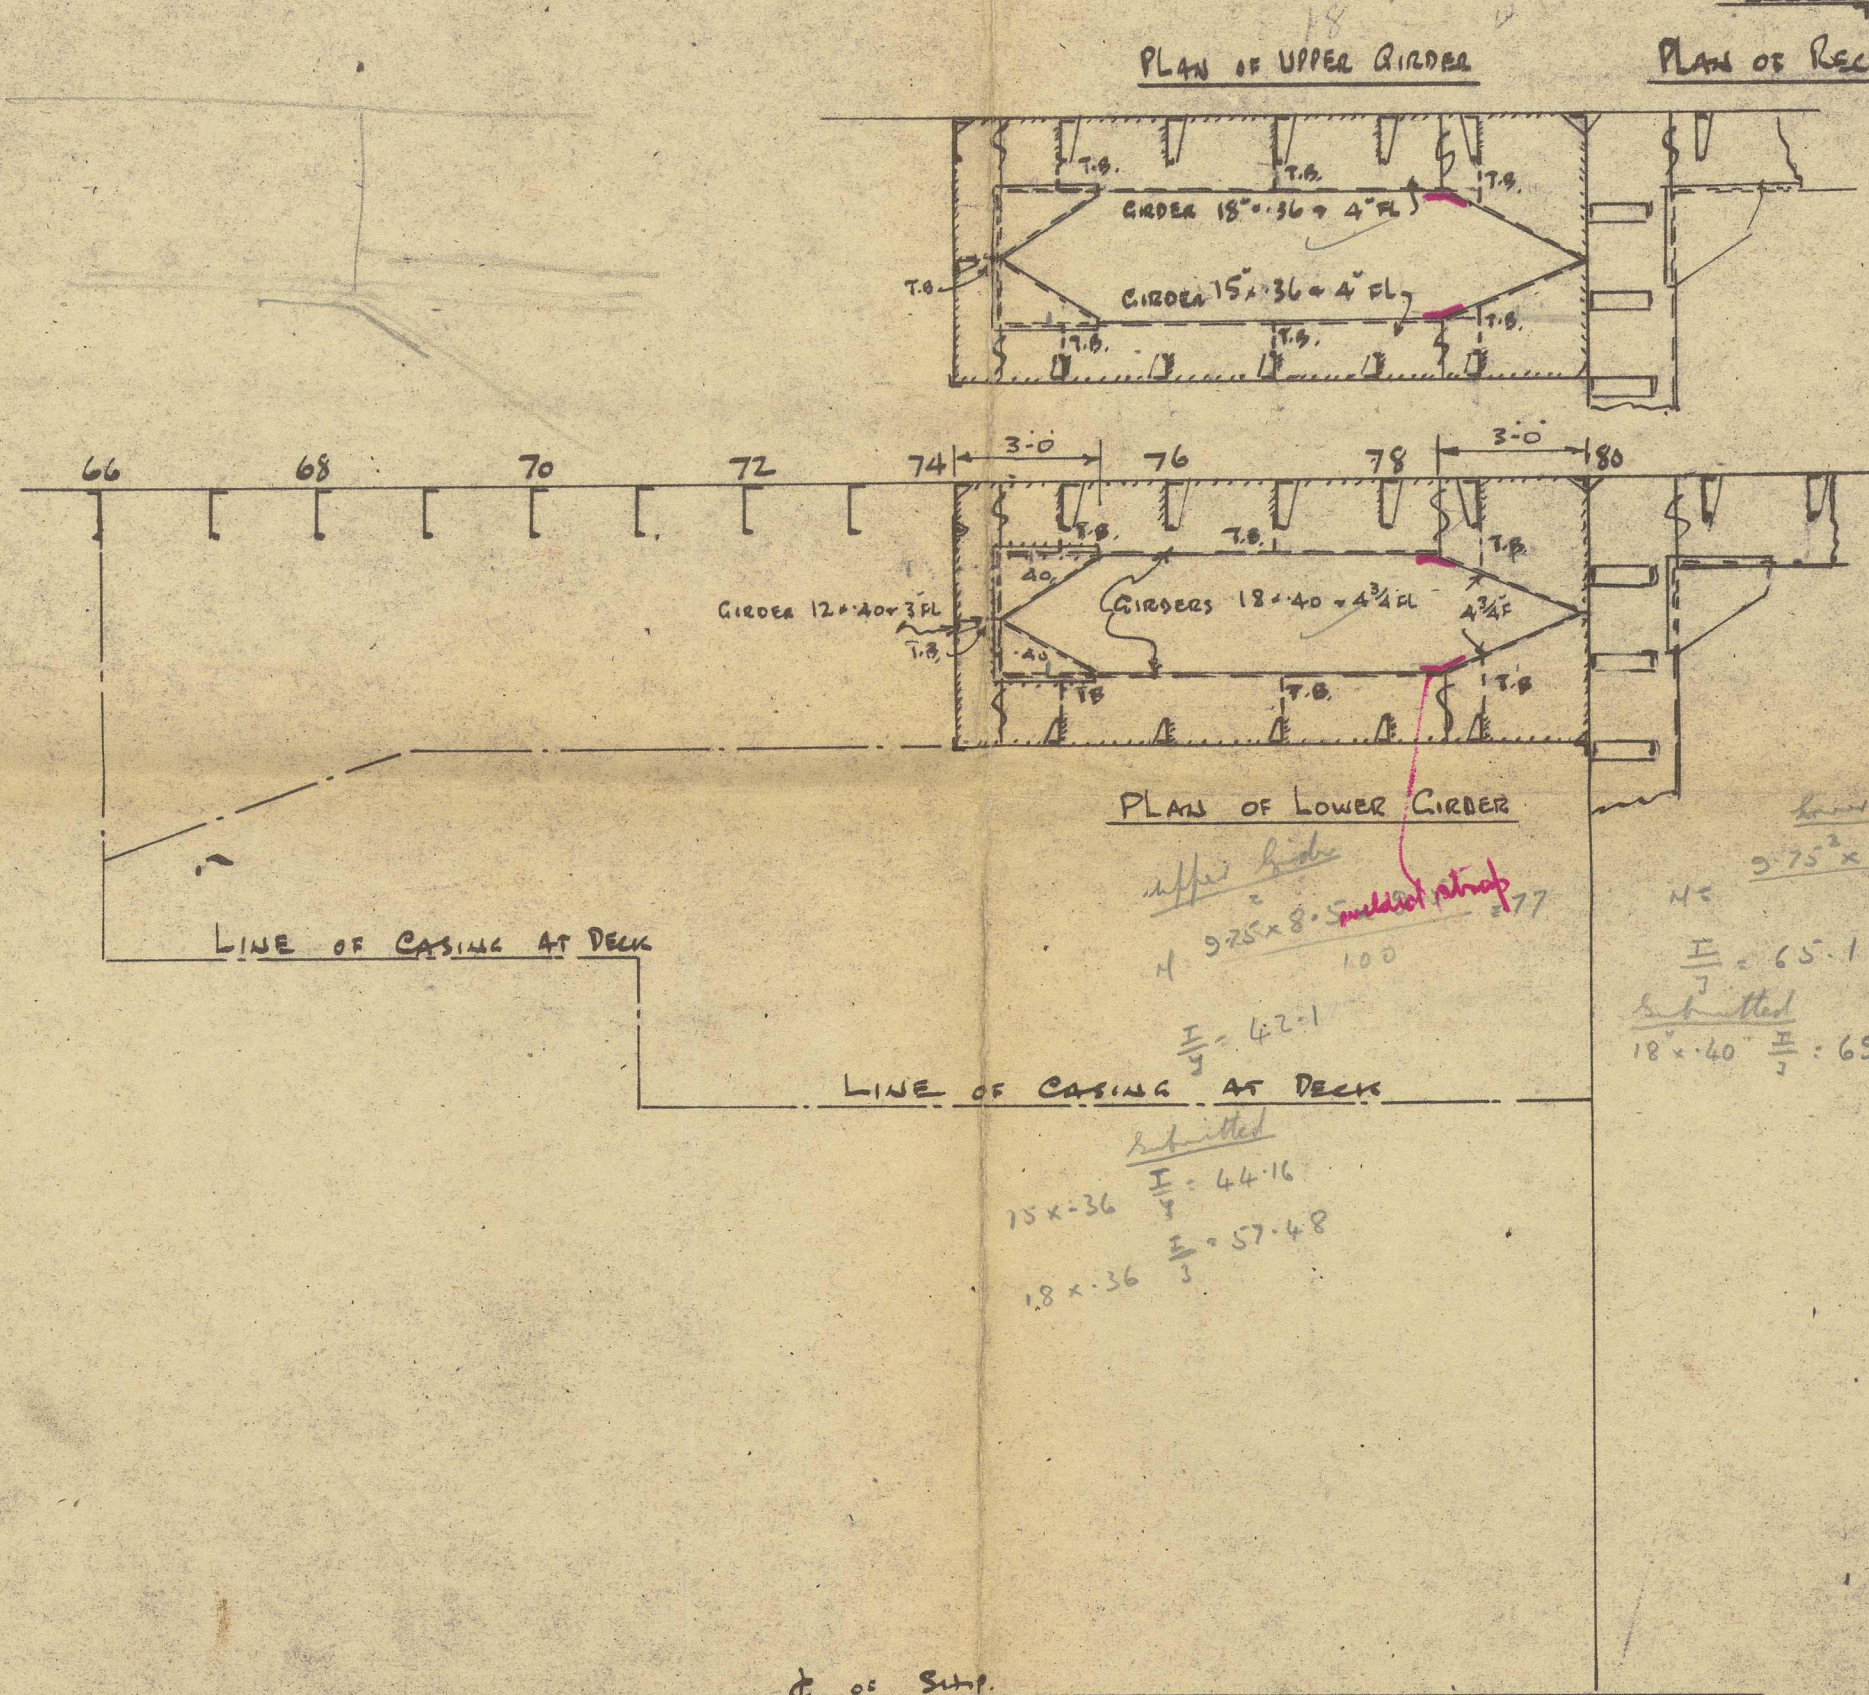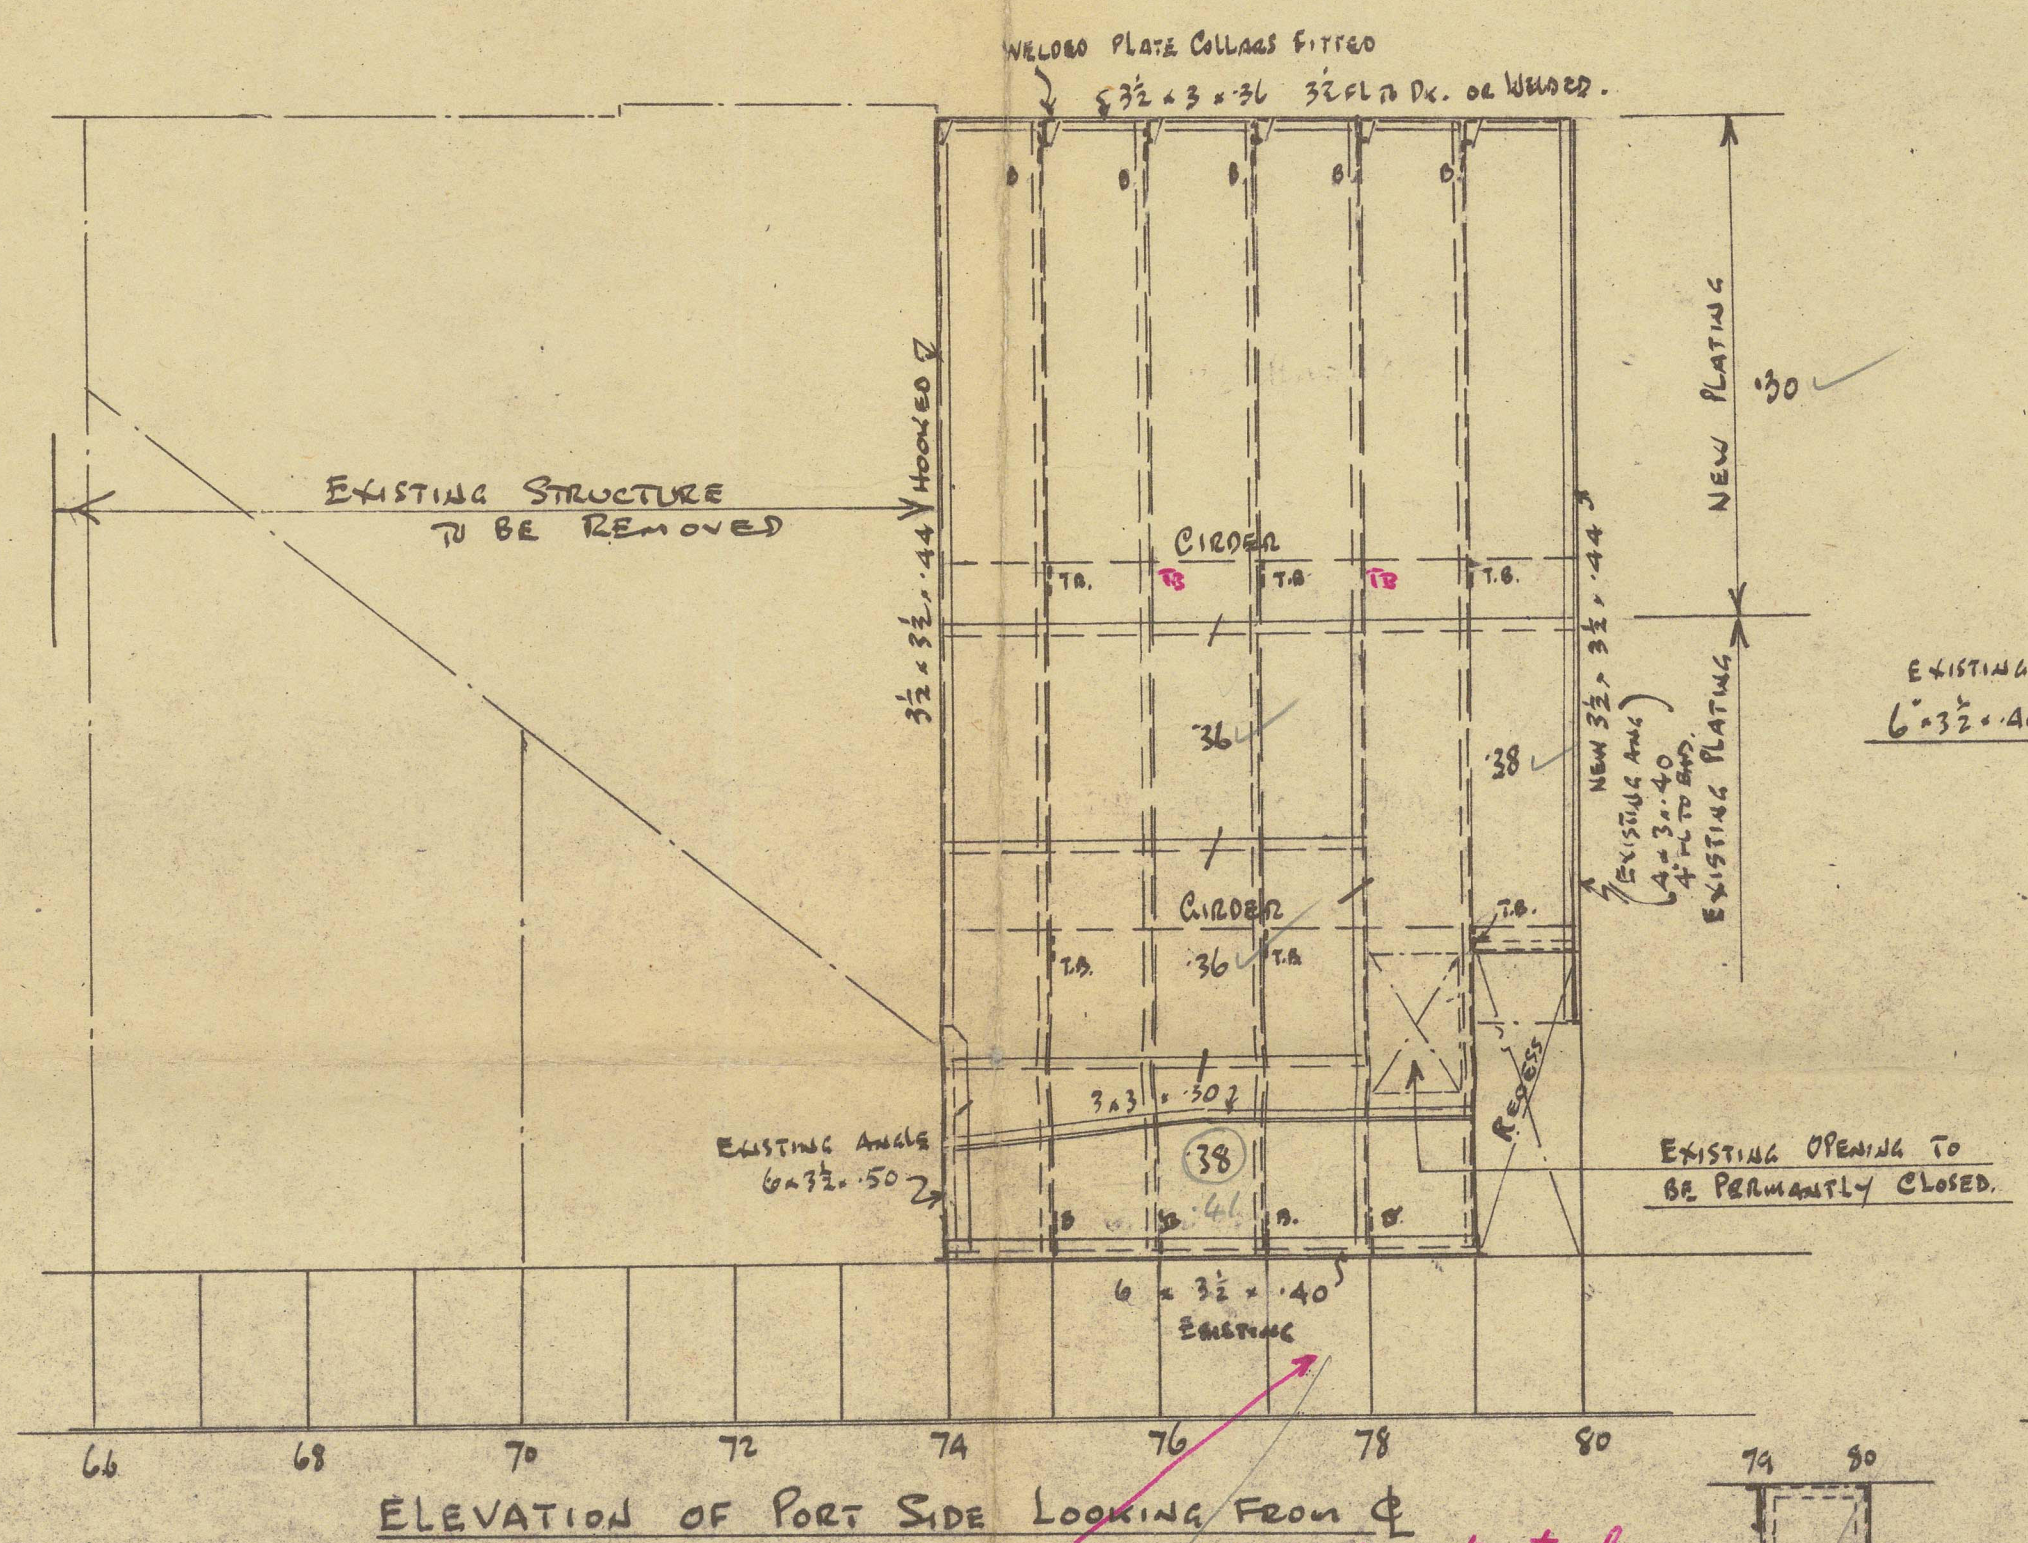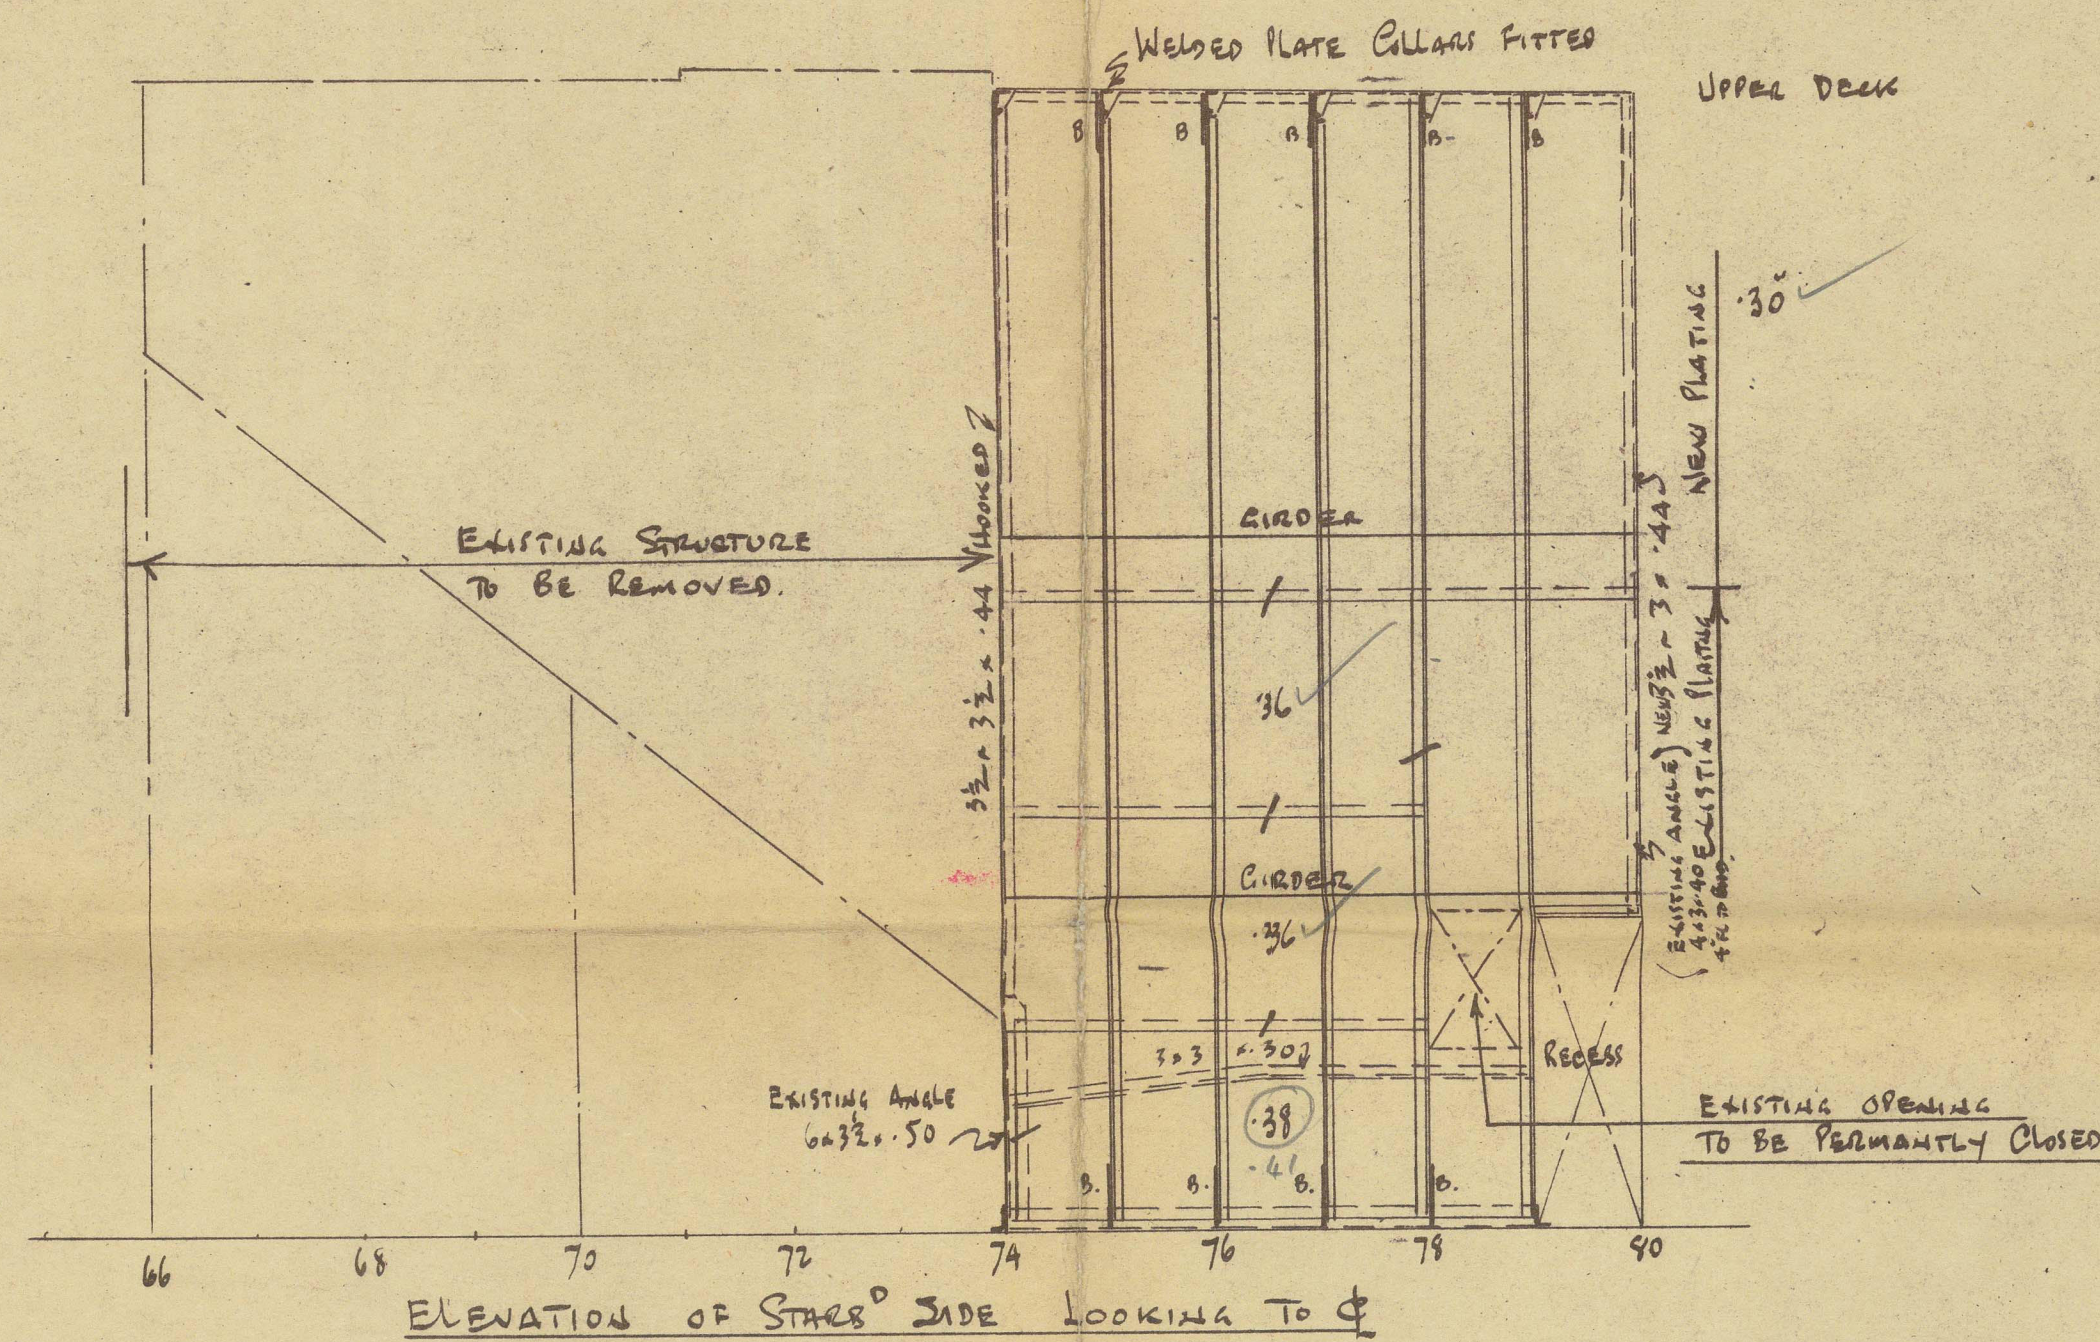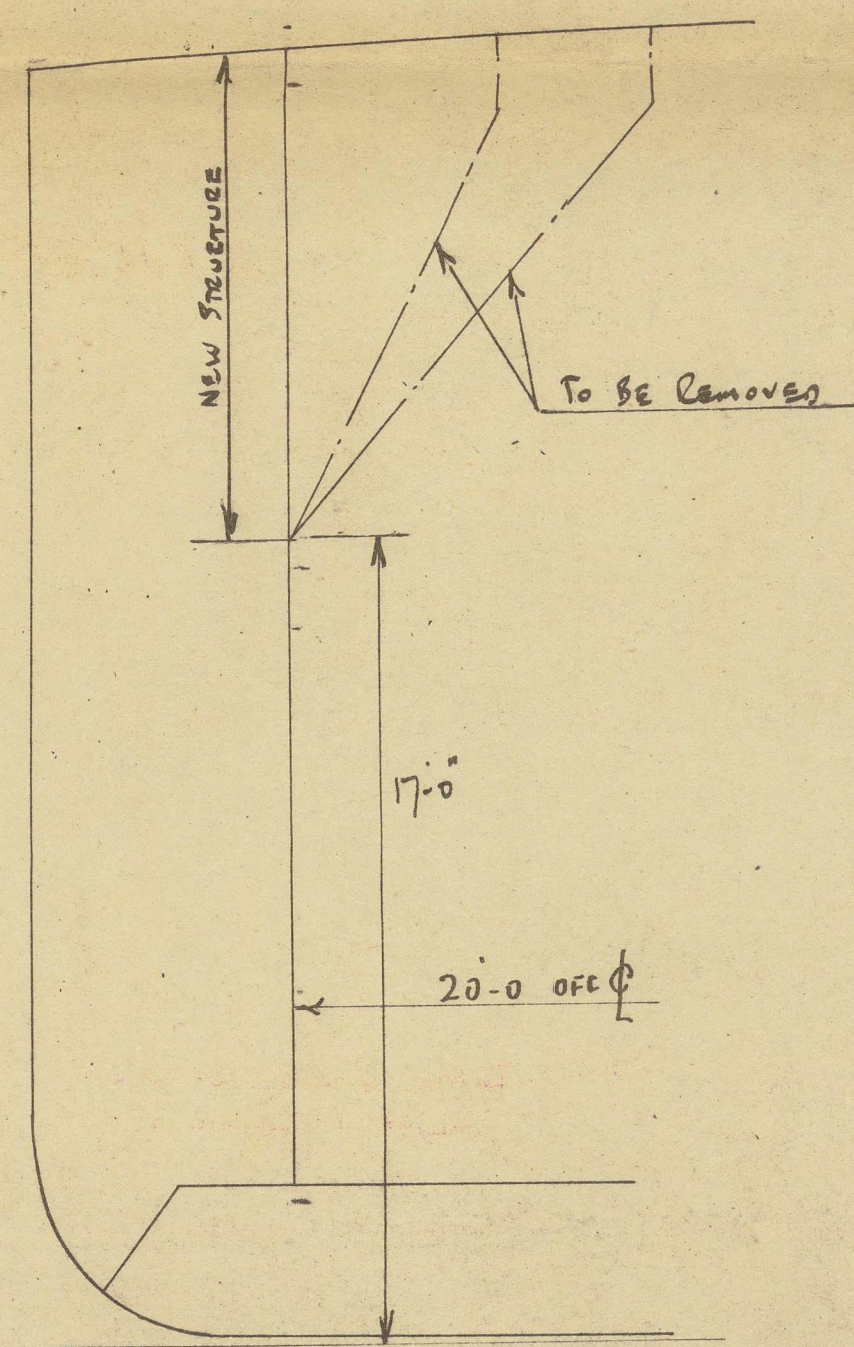


SECTION AT 76  
LOOKING FORWARD  
75, 77 + 78 SIMILAR  
STREETS AT 76 + 78 TO BE REMOVED

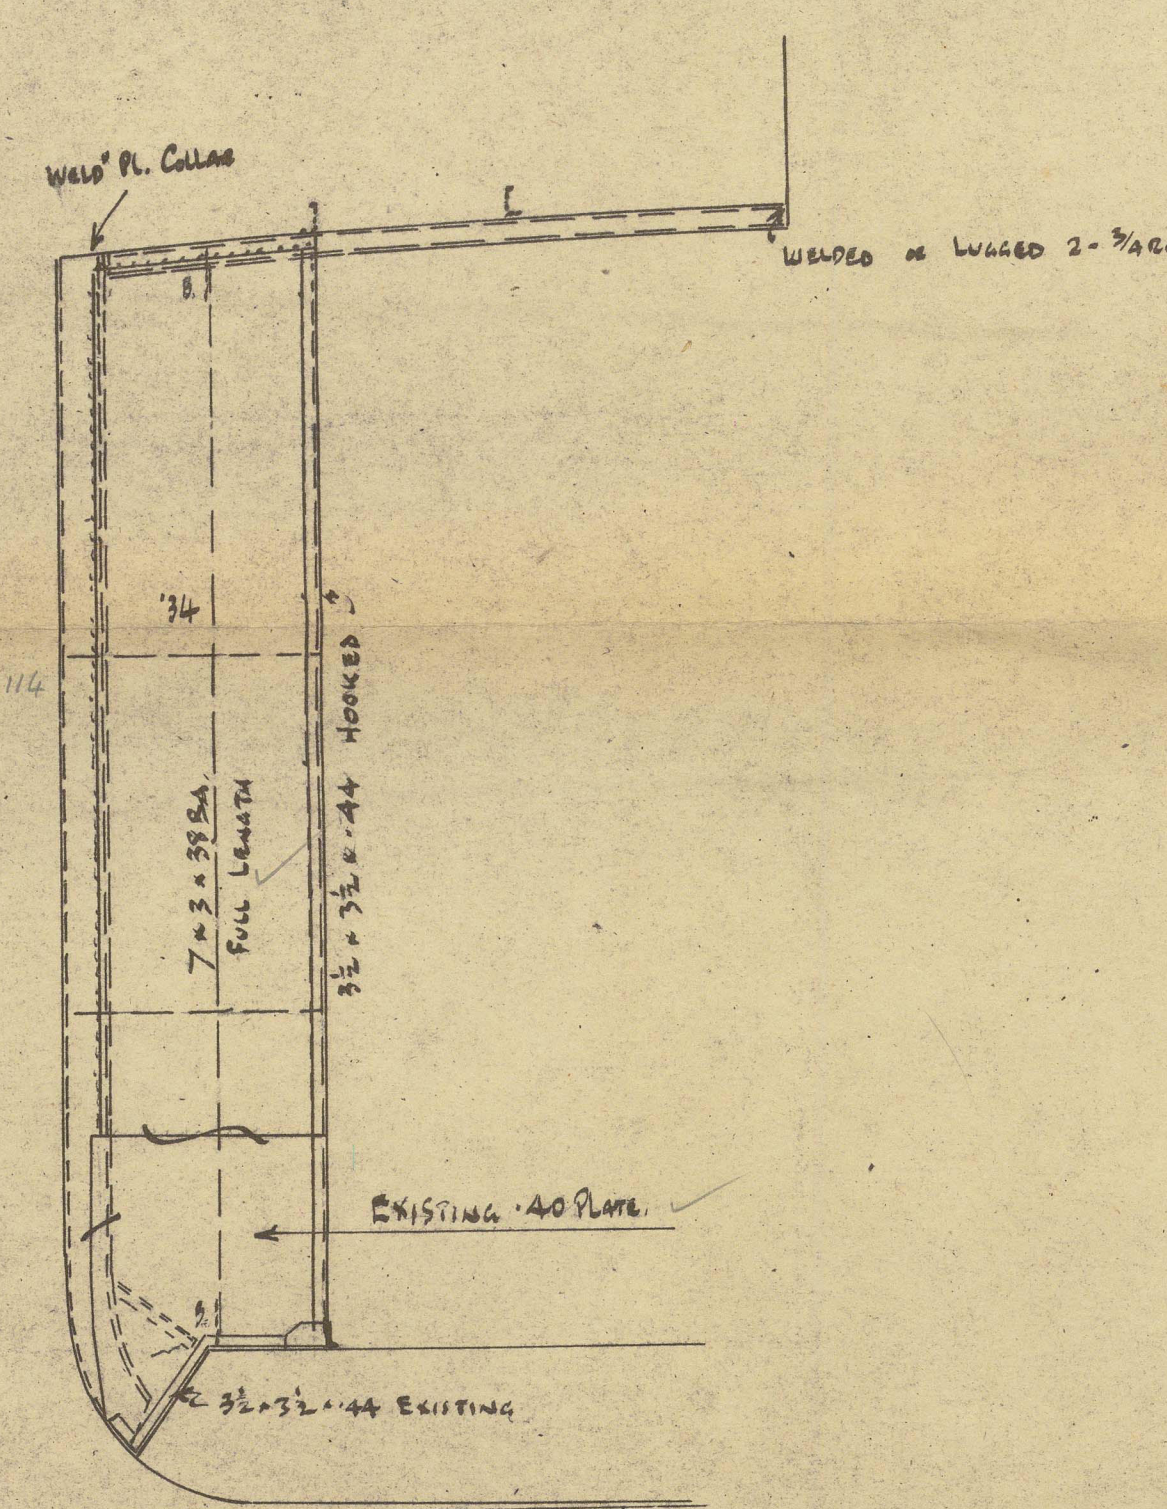

SECTION AT FRAME 74  
LOOKING FORWARD

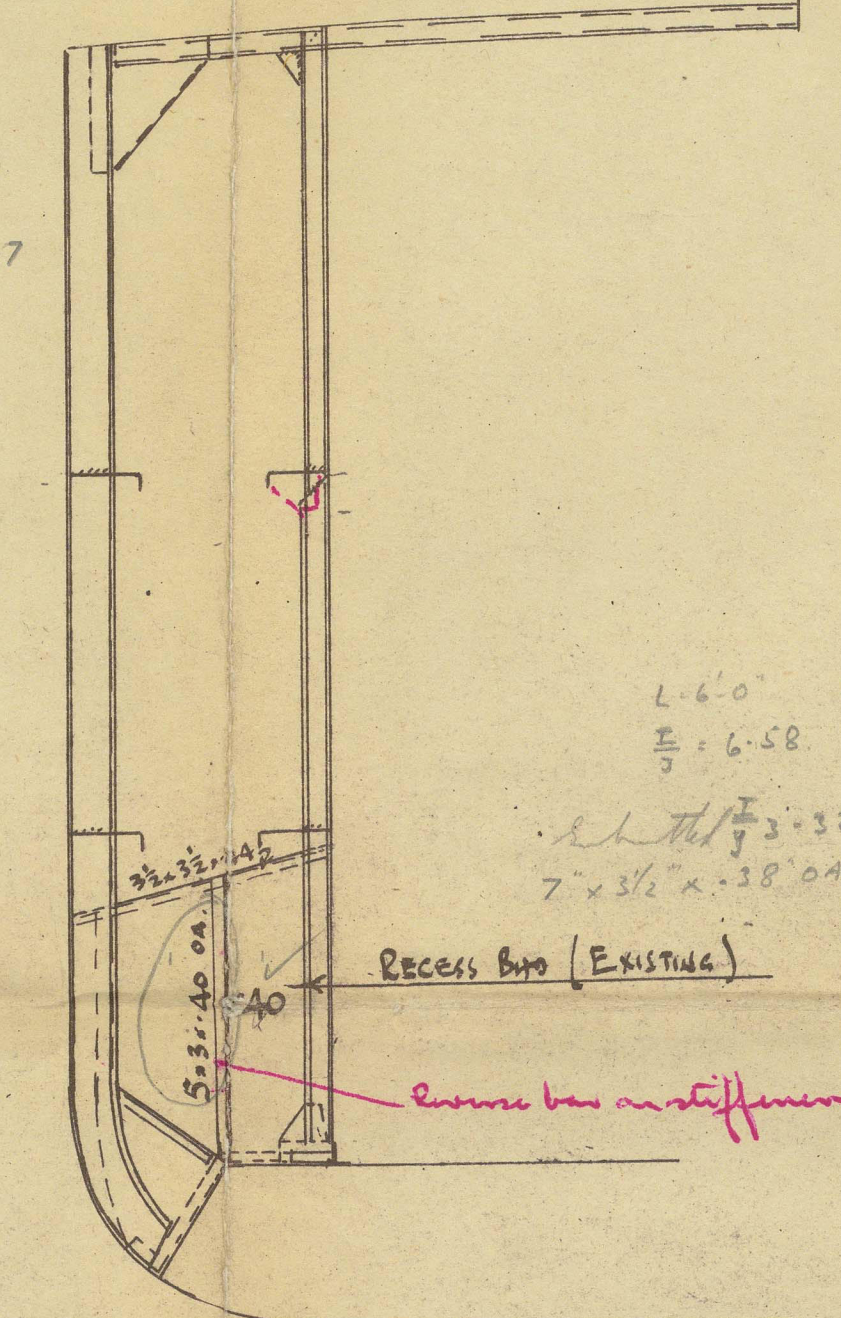

SECTION AT FRAME 79  
LOOKING FORWARD

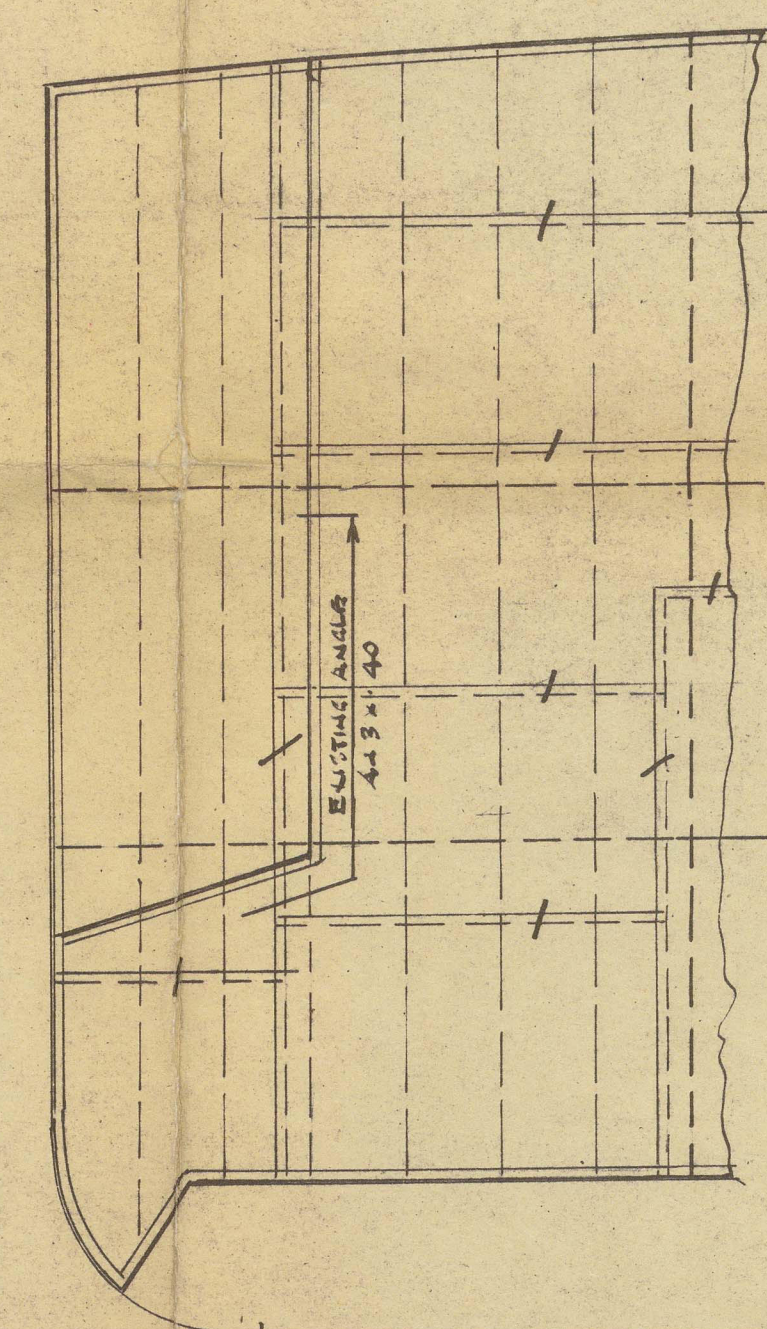

BULKING No 80  
LOOKING FORWARD

EXISTING RIVETING			
SEAMS + BUTTS	3/4 Riv.	6 Dia. ANGLE	
TANK TO CONNECTIONS TO TANK TOP	3/4	6	-
- BUNKER	3/4	6	-
CORNER BARS	3/4	7	-
STIFFENERS	3/4	8	-
CONNECTIONS TO BUD 80	3/4	5	-
TO BULKING	3/4	7	-

NEW RIVETING			
BULKING CONNECTIONS TO BULKING	3/4 Riv.	4 Dia. ANGLE	
- DECK	3/4	5	-
OVERLAP OF PLATING	3/4	4	-

Blairspey.  
TO ACCOMPANY NINC. REPORT No 113310  
DATED 4.56

19 JAN 1956



"Blairspey"

Amendments to existing coal side Bunkers.

Misc. Rpt. No 11331D.



© 2021

Lloyd's Register  
Foundation

013390-013396-0043