

Lloyd's Register
Foundation

General sketch of proposed
conversion from coal to oil
fuel

"Karnal"


Rpt. no. Syd. 26526




© 2021

Lloyd's Register
Foundation

013390-013396-0207

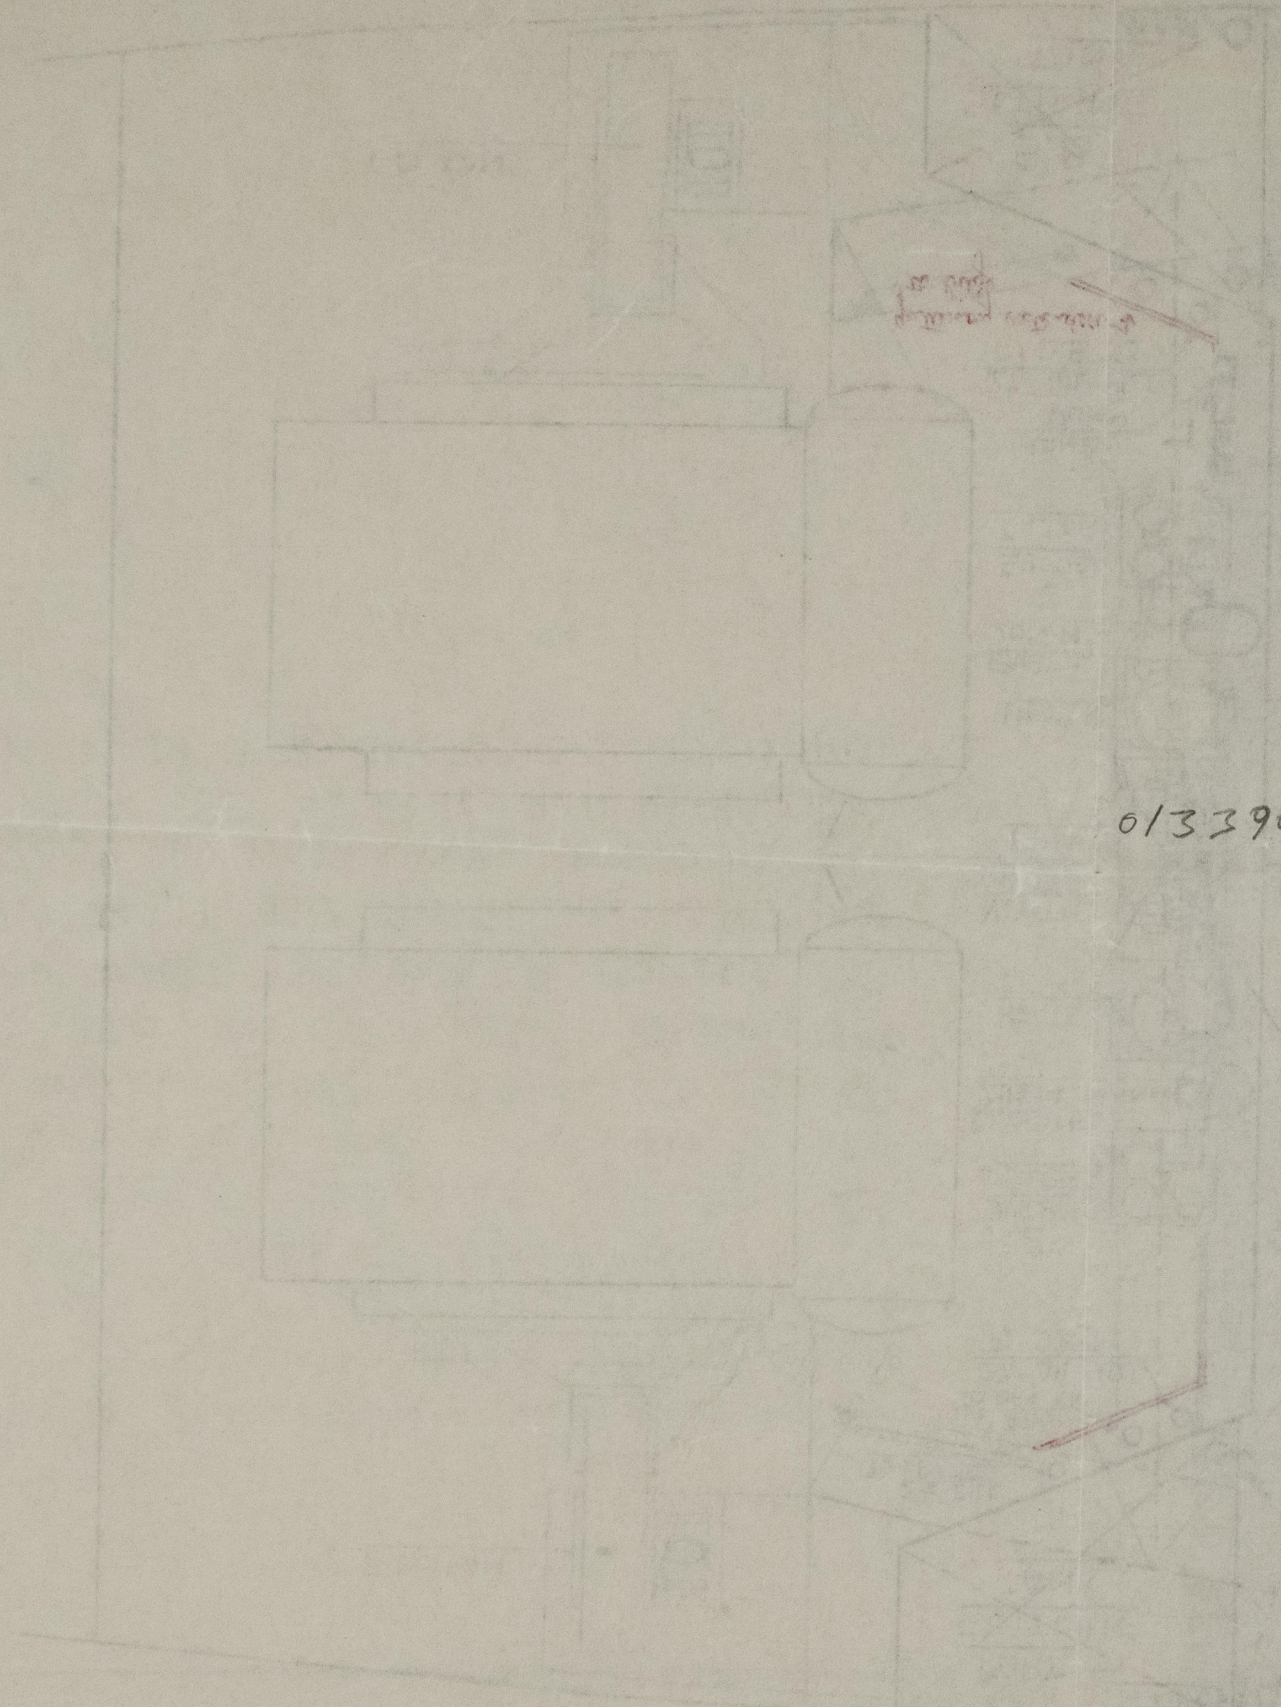

Handwritten red text, possibly a signature or note.

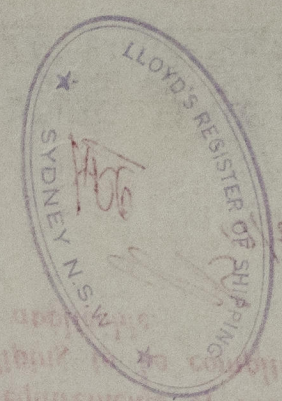

5/23

Handwritten red text, possibly a signature or note.

013390 - 013396 - 0207

Handwritten red text, possibly a signature or note.



© 2021
Lloyd's Register
Foundation

Handwritten red text at the bottom of the page.