
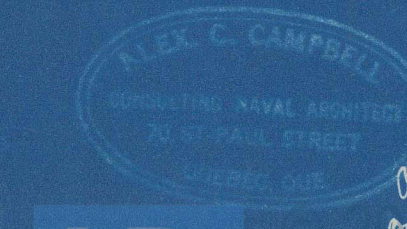


DIMENSIONS

LENGTH B.P.	156'-0"
BREADTH AT DECK	32'-0"
BREADTH AT BOTTOM	24'-0"
DEPTH	11'-9"
DRAFT MAX.	10'-0"

"Laurie van Monton"
 DIESEL ENGINE
 PULPWOOD BARGE
 GENERAL ARRANGEMENT
 SCALE 1/8" = 1 FOOT

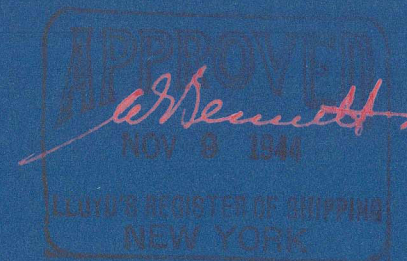

Des. No. 1944-2A

2

~~PA~~
'CAP SAUMON'

M/M.13410

GEO. T. DAVIE & SONS LTD
YARD No. 34.

—
DIESEL-ENGINEED PULPWOOD
—
BARGE.

GENERAL ARRANGEMENT



© 2021

Lloyd's Register
Foundation

013409-013416-0044