


KNUCKLE LINE OF TANK TOP.

### RECESS IN DOUBLE BOTTOM UNDER PROPULSION MOTOR

SCALE  $\frac{1}{2}" = \text{ONE FOOT.}$

PLAN VIEW ON TANK TOP

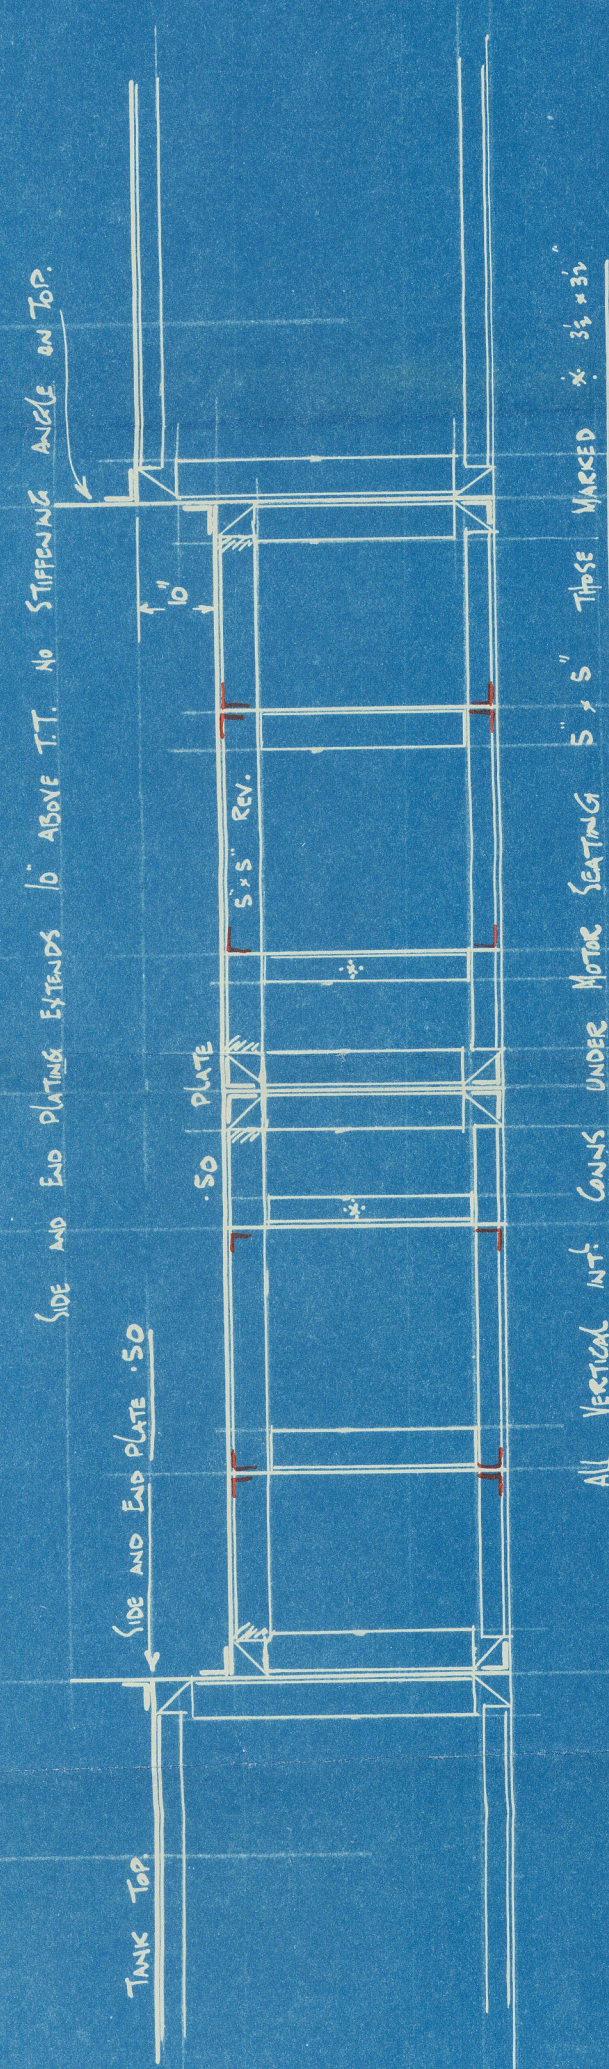

SECTION AT FRAME NO. 56:



City of Kimberley

Recess in double bottom  
for motor.

---

(also applies to "City of Salisbury")

Belfast 11175 =

013449 - 013453 - 0083



© 2021

Lloyd's Register  
Foundation