

Copy of approval.

H.M. MONARK

EX HALLBERG-56

EX MASILIA-54. X. D.S. 607


Gin Bosc 2036.

Midship Section

S.S. No 257 & 258

Oscarshamns Mekanska Verkstad

Oscarshamn.

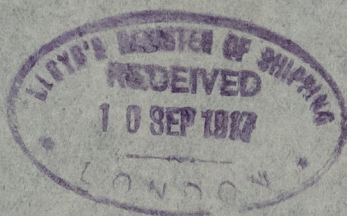

S. Masilia
Goth. 3685.



© 2021

Lloyd's Register
Foundation

013484-013496-0247