



8 AUG 1960

FLY TO DRAWING. Y69/4. MIDSHIP SECTION.  

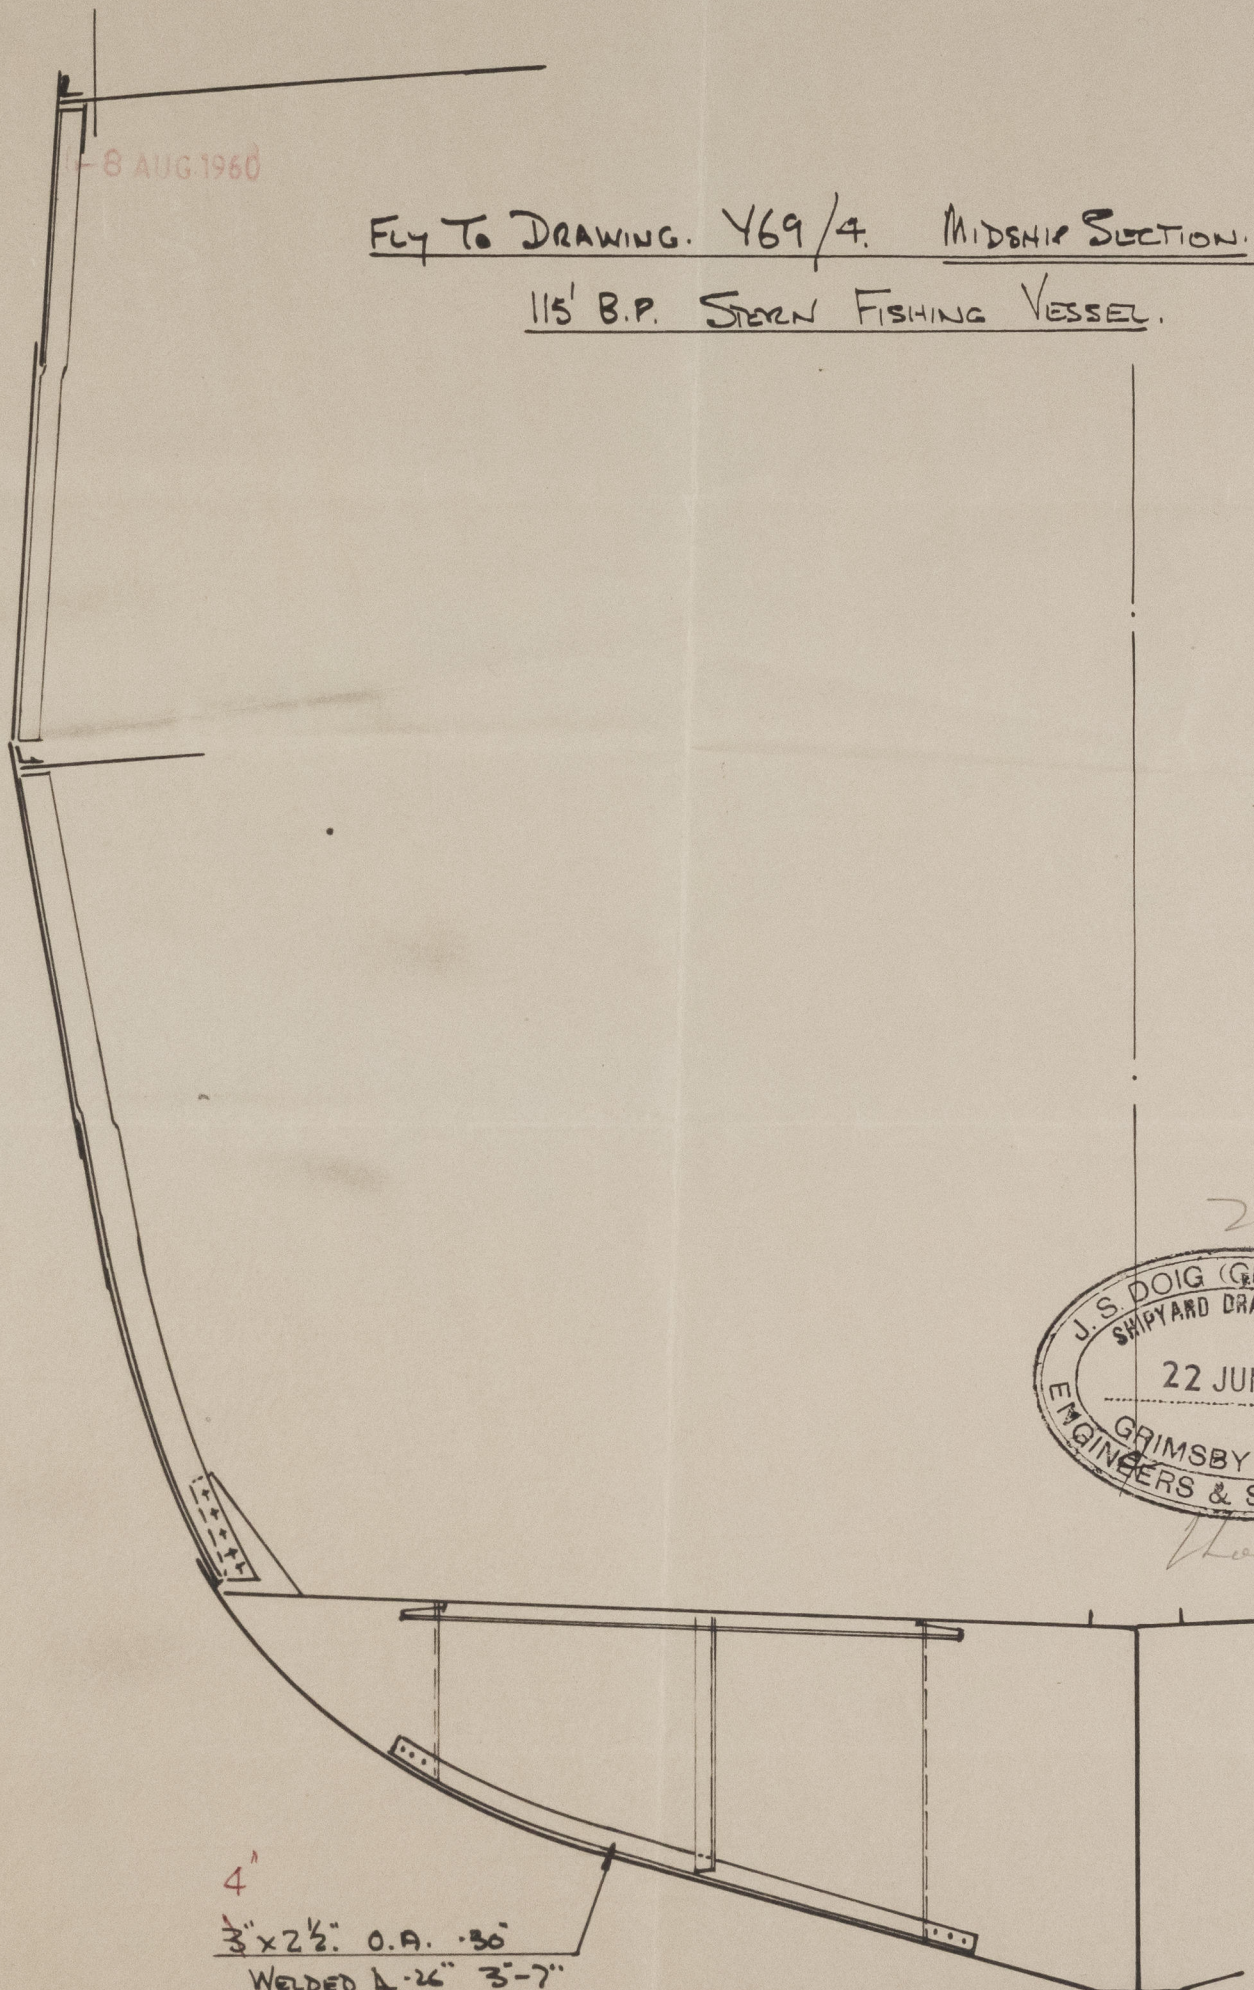

4"  
3" x 2 1/2" O.A. .30  
WELDED L-26 3-7"

MODIFIED FRAME. REMAINDER AS ORIGINAL.

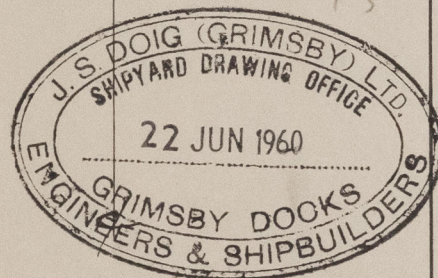

*Lloyds*

*RGL*

*8/8/60*

J.S. DOIG. (GRIMSBY) LTD

F.H. 22/6/60.

Lloyd's Register  
Foundation

013447 013507 0103

FLY SHEET TO DRG No. Y. 69/4

MIDSHIP SECTION

J.S. DOIG (GRIMSBY) LTD, YARD No. 69.

012497-013507-0103



© 2021

Lloyd's Register  
Foundation