


完
成
圖

番 號

Foundation

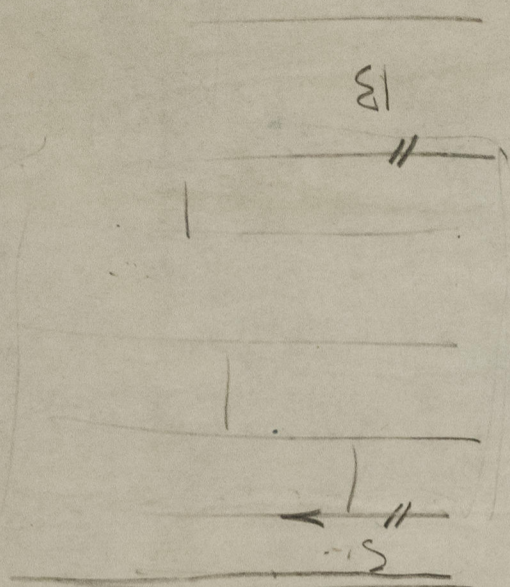


013536 - 013544 - 0028

"YUKIKAWA MARU" ★

General arr.

RECORDS DEPT.
LONDON

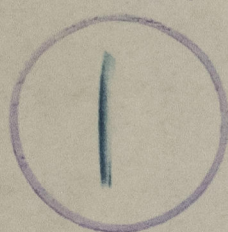

596

58.

6



354

328



© 2021

Lloyd's Register
Foundation

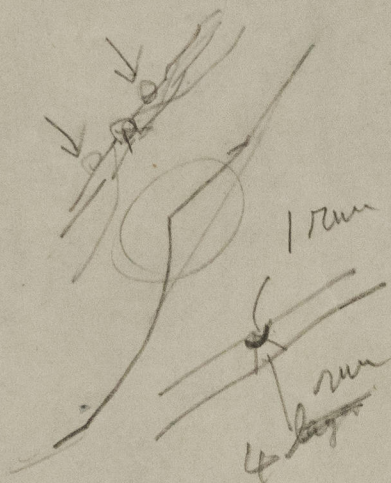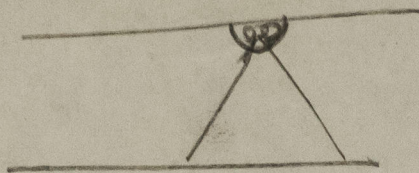

© 2021

Lloyd's Register
Foundation

013536-013544-0028