

NOTE! DETAIL SHOWN IN BROWN 'AS FITTED'

38FT DIESEL TRAWLER (SHIP 508)  
GENERAL ARRANGEMENT  
SCALE 1/4" = 1 FT.

R.S. HEYES (P.O.) LTD  
THE DOCKYARD  
FENESTON DOCK  
DRA 508/1

LENGTH O.A. 107'-0"  
LENGTH L.W.L. 100'-0"  
LENGTH B.P. 98'-0"  
BREADTH M.L.D. 23'-0"  
DEPTH M.L.D. 11'-9"  
DRAFT AFT. 11'-3"



505

General arrangements.  
(as fitted) 505/1 (27.6.55)


Motor Launcher

" "   
Norrad Star. ★

Wilford Haven { F.E. Rpt.  
N° 8137.

12/52

RECORDS DEPT.  
LONDON.

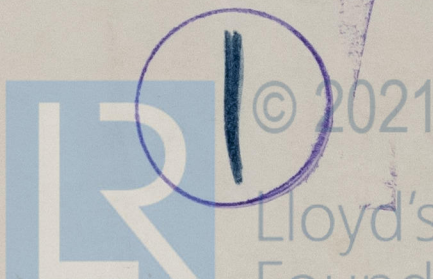

Lloyd's Register  
Foundation

013571-013578-0044