




5

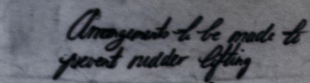



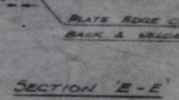

SECTION 'E-E'

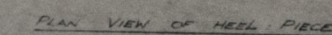

PLAN VIEW OF HEEL PIECE

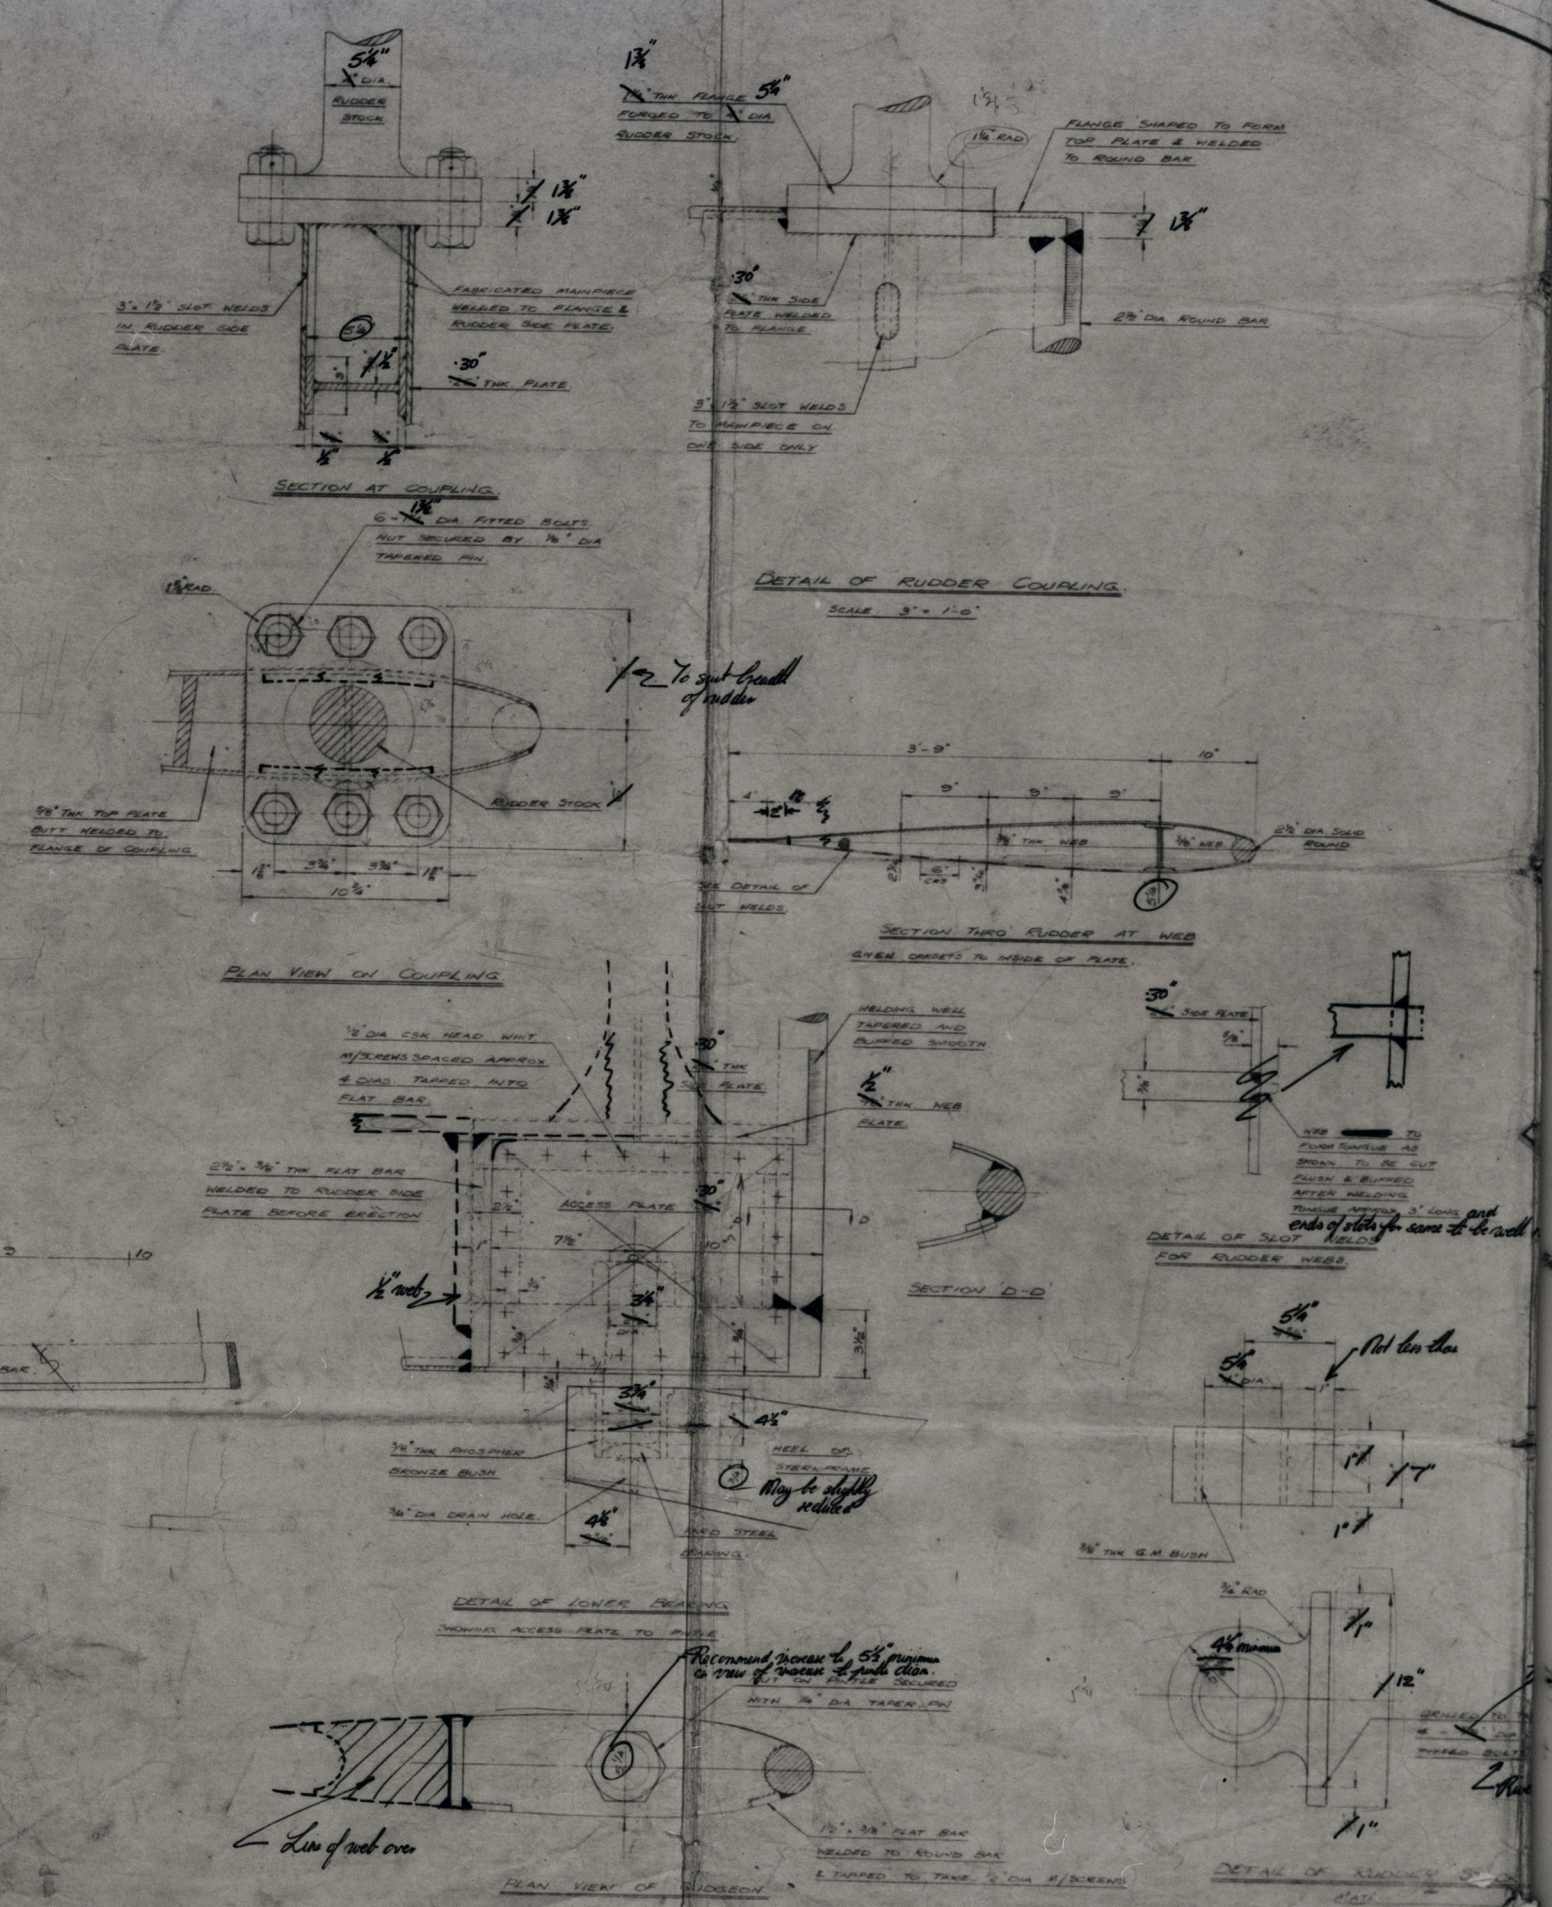

DETAIL OF RUDDER COUPLING

SCALE: 3" = 1'-0"



SECTION 'D-D'

nd. vicax L. 5½ minima

WELDED TO ROUND BAR

✓
1000