



NAGASAKI F.E. RPT. N° 1130

MITSUBISHI N° 1561

"MANHATTAN MARU" ★

STERNFRAME (AS BUILT)

RECORDS DEPT.
LONDON.

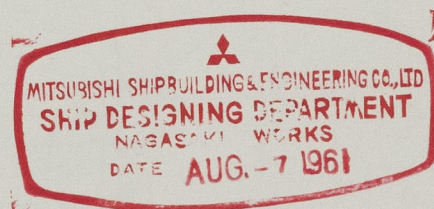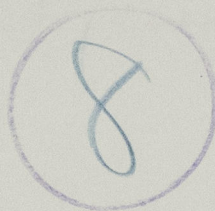

© 2021 *Chiyota*

Lloyd's Register
Foundation

013596 - 013603 - 0083