
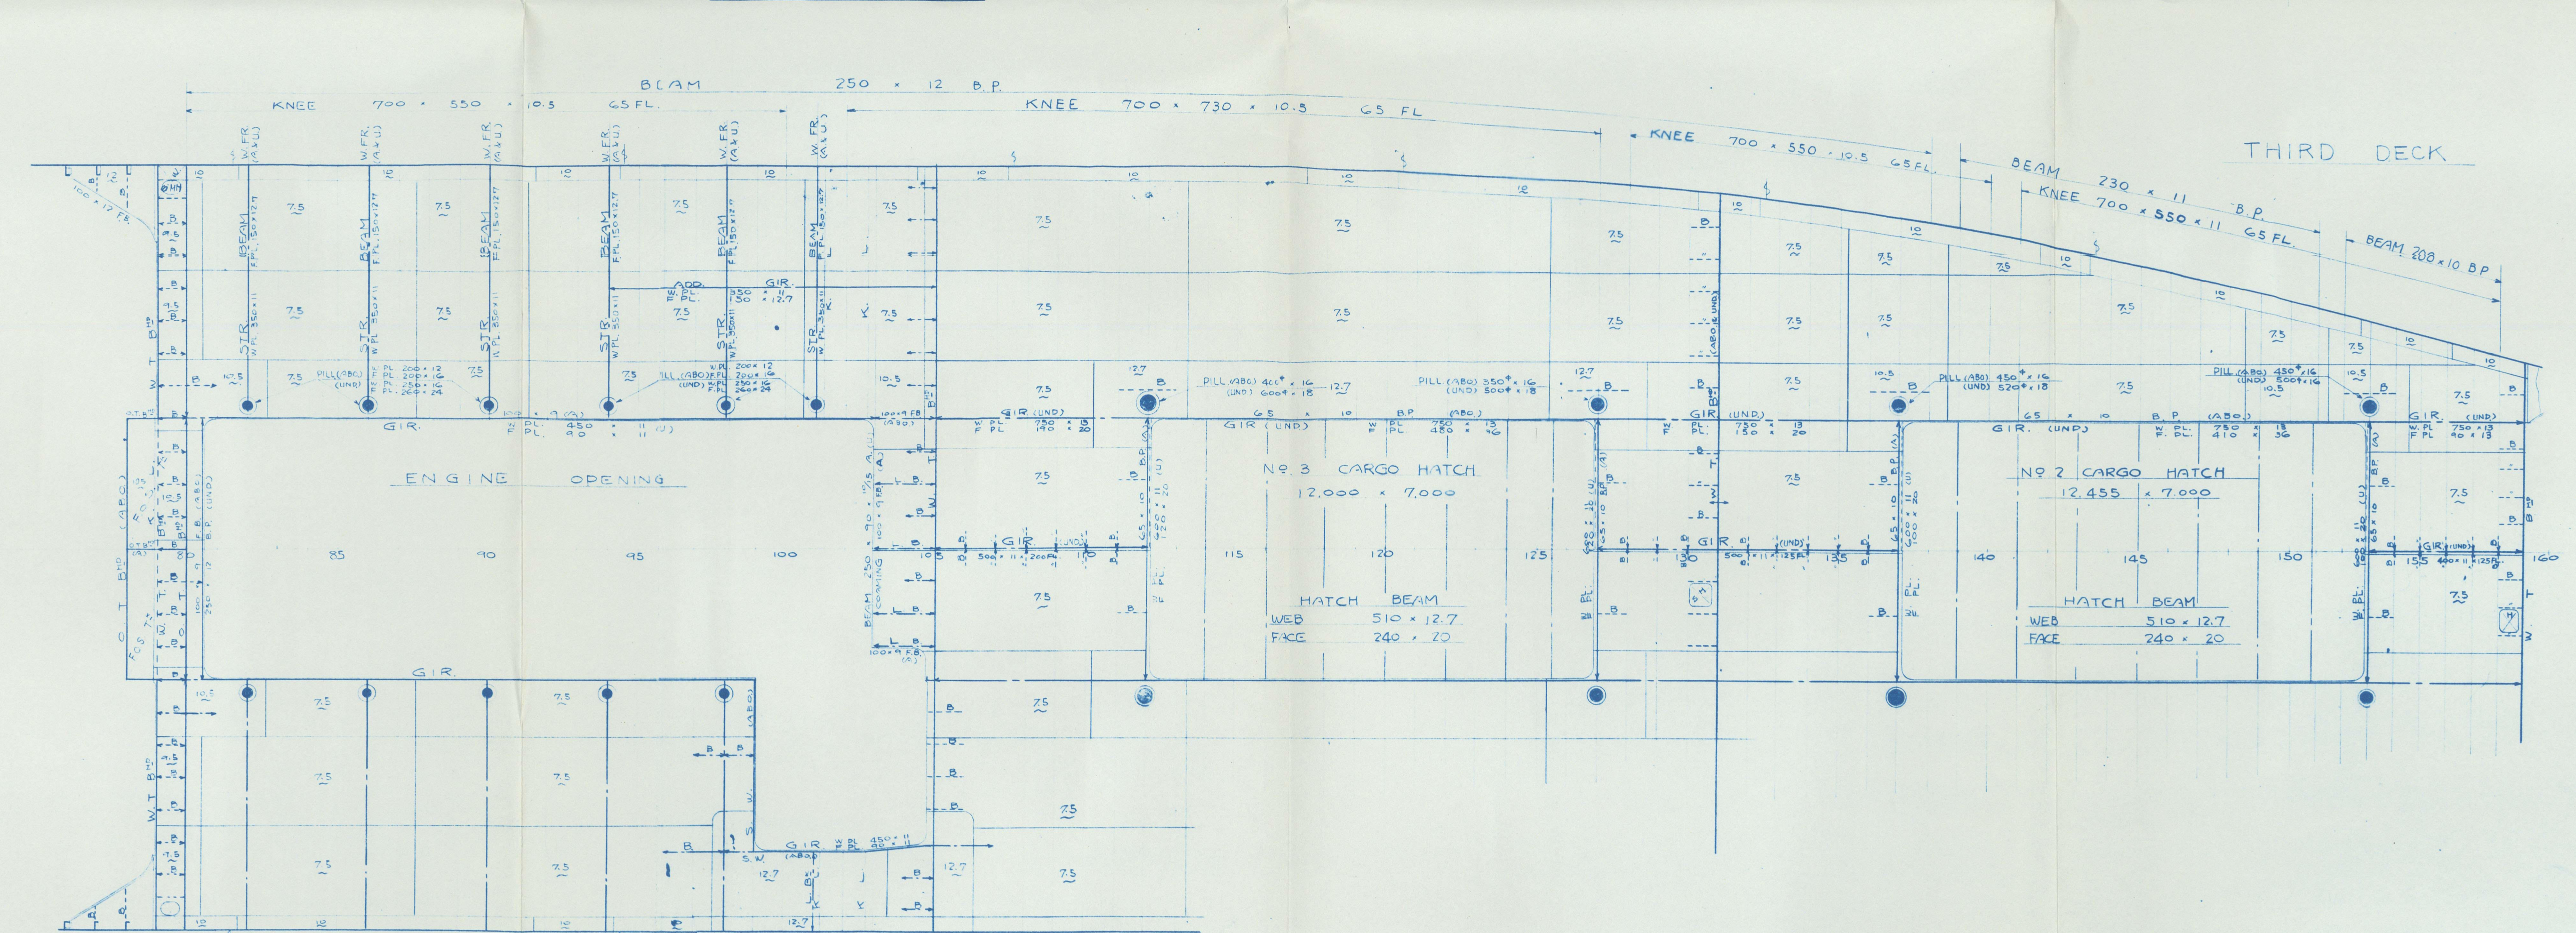
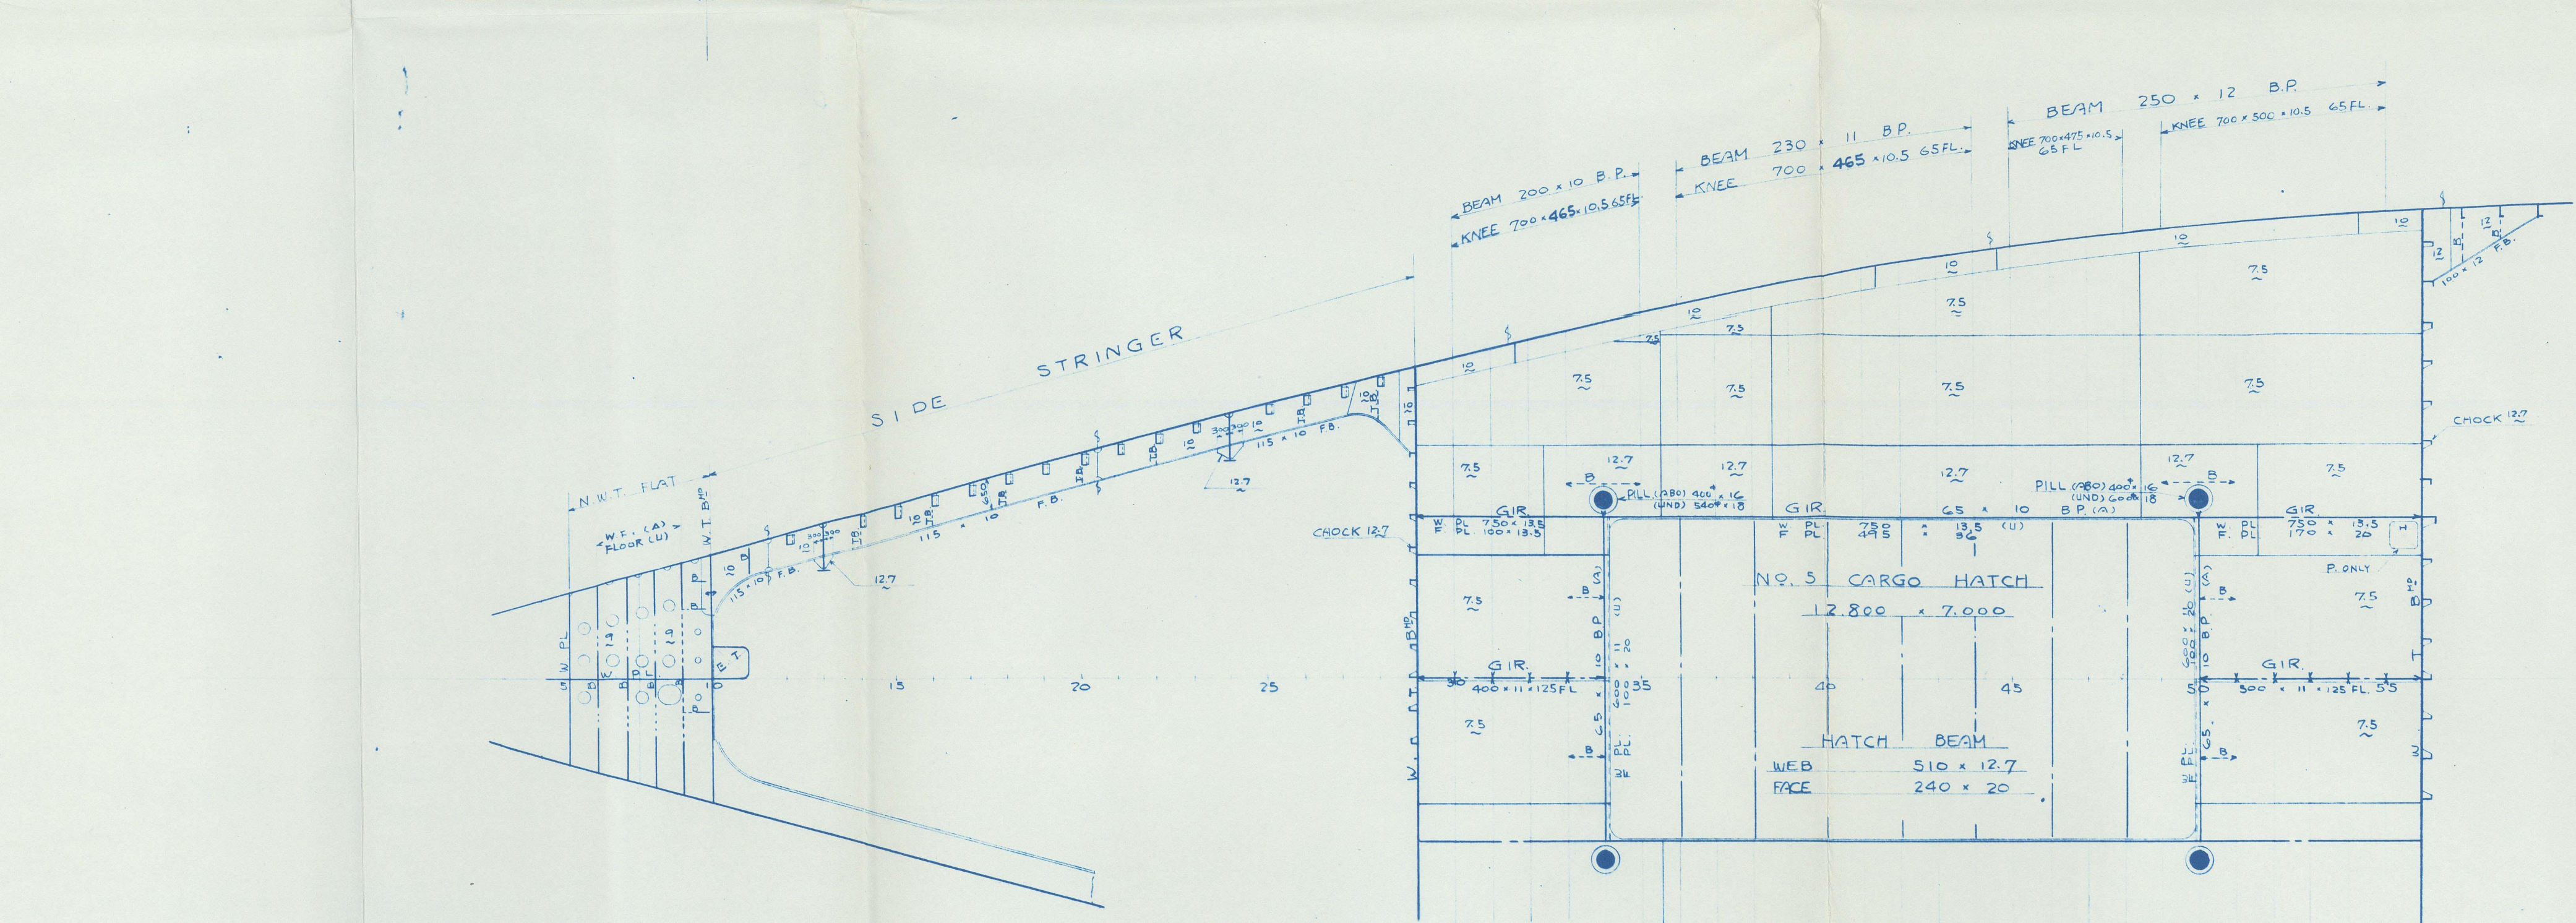


NOTE:
 1. MARKS SHOW PILLAR ABOVE
 2. MARKS SHOW PILLAR UNDER
 3. MARKS SHOW PILLAR ABOVE & UNDER
 4. MARKS SHOW PILLAR ABOVE & UNDER
 5. MARKS SHOW PILLAR ABOVE & UNDER

 

DAIDO KAIUN
 MANHATTAN MARU

CONSTRUCTION
 PROFILE &
 DECK PLAN
 SHEET II
 (FINISHED PLAN)

DIMENSION 148'0.205'12'5"
 SCALE 1/100 CLASS S.R.
 HULL DESIGNING SECTION
 SHIP DESIGNING DEPARTMENT
 NAGASAKI WORKS
 CHIEF OF DEPT. *Hasegawa*
 CHIEF *Wakabayashi*
 HEAD *Wakabayashi*
 CHECKED *Wakabayashi*
 DRAWN *Wakabayashi*
 DATE AUG 10 1935
 TOKYO JAPAN

SHIP NO 1561
 DWG NO H-207B21

NAGASAKI. F.E. RPT. N° 1130

MITSUBISHI N° 1561


"MANHATTAN MARU"



PROFILE AND DECKS (SHEET 2)

(AS BUILT)

RECORDS DEPT.
LONDON.

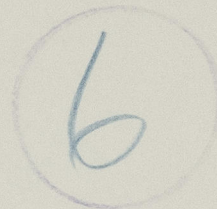

Lloyd's Register
Foundation

013596-013603-0084