

DAIICHI KAIFU  
MANHATTAN MARU

CONSTRUCTION  
PROFILE &  
DECK PLAN  
SHEET 1  
(FINISHED PLAN)

148'0" x 20'5" x 12'5"

SCALE 1/100 CLASS L.R.

HULL DESIGNING SECTION  
SHIP DESIGNING DEPARTMENT  
NAGASAKI WORKS

CHIEF OF DEPT. *[Signature]*  
CHIEF *[Signature]*  
CHECKED *[Signature]*  
DRAWN *[Signature]*  
DATE AUG. 1, 1961 REG. NO.  
MITSUBISHI ZOSEN KAWASAKI KANSAI  
YOKOHAMA  
SHIP NO. 1561  
DWG NO. H-2070A



NAGASAKI F.E. RPT. N° 1130


MITSUBISHI N° 1561

"MANHATTAN MARU"

PROFILE AND DECKS (SHEET 1)  
(AS BUILT)

RECORDS DEPT.,  
LONDON.

5

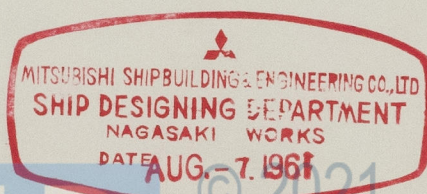

*Sh. Fujita*

Lloyd's Register  
Foundation

013596 - 013603 - 0085