
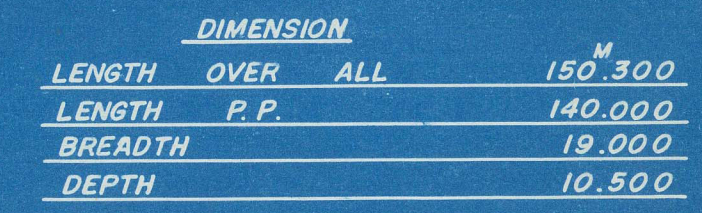


SCALE 1/200

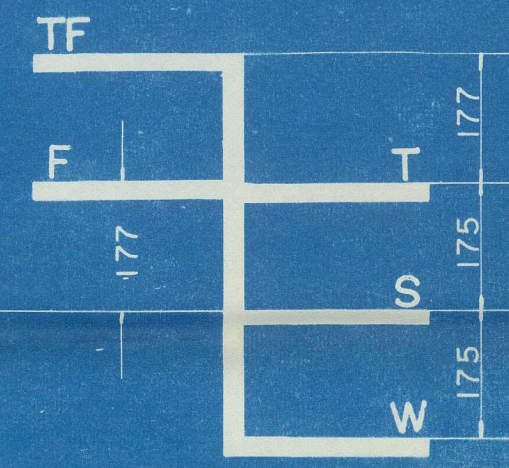

S T O R E			
I T E M	FR. NO.	CAPACITY	
		CUB. M.	
BOON STORE (FOLS)	168 - E	44.40	
CARPENTER SHOP (,)	108 - 198	21.40	
PAINT ROOM (,)	179 - 182	16.76	
LAMP ROOM (,)	176 - 180	61.76	
DRY PROV. STORE (HARRIS)	73 - 75	5.85	
PASSAGE ROOM (HARRIS)	75 - 83	88.24	
DRY PROV. STORE (,)	82 - 93	14.77	
MAIL ROOM (,)	82 - 91	51.80	
RICE STORE (,)	70 - 82	74.70	
DRY PROV. STORE (,)	73 - 85	65.81	
WET. PROV. STORE (,)	79 - 83	20.24	
DECK STORE (,)	51 - 53	6.65	
" (S) (,)	51 - 53	6.65	
DECK STORE (,)	138 - 134	7.80	
" (S) (,)	138 - 134	7.80	
REF. LOBBY	87 - 90	5.70	
CHAMBER	87 - 90	5.70	
(BRIDES)	90 - 95	20.01	
FISH ROOM	84 - 87	10.08	
BOON STORE (POON)	5 - 9	10.50	
CARGO GEAR STORE (HUP EN)	155 - 159	83.57	
" (S) (,)	155 - 159	74.87	
CARGO GEAR STORE (,)	22 - 30	7.63	
" (S) (,)	22 - 30	7.63	
BOON STORE (HARRIS)	180 - FE	31.75	
ENGINEER STORE (,)	93 - 94	9.00	
BOON STORE (,)	A-E	54.95	
T O T A L		827.36	

NAGOYA SHIPBUILDING CO. LTD.

CAPACITY PLAN

WITH

D.W. SCALE





DRAWER

APRIL 7th 1953

完 一 一 一


7041

12
11
10

"NEW YORK MARU" ★

Capacity Plan with D.W. Scale.
(as fitted).

RECORDS DEPT.
LONDON

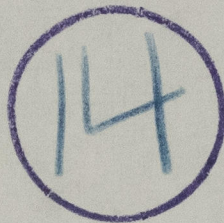

© 2021

Lloyd's Register
Foundation

013596-013603-0143

013603-0143

紐育丸

S-104

CAPACITY PLAN

WITH

D.W. SCALE

(FINISHED PLAN)

容量図


(完成圖)

SCALE	1/200	DEPARTMENT CHIEF
ITEM	H-1	神谷 28.5.21
HULL DESIGNING SECTION OF DESIGNING DEPARTMENT NAGOYA SHIPBUILDING CO. LTD. NAGOYA, JAPAN		
SECTION CHIEF	山田 28.5.21	IN CHARGE M. Kurosawa
CHIEF IN CHARGE	山田 28.5.21	DESIGNER H. Katow
DESIGNED	APRIL 7th 1953	
ISSUED	28.5.21	
SUB ITEM	完 11	
PL. No.	H-7041	

013596-013603-0143

As Fitted.
67

NOTE RPT. NO. 1411
DATED.

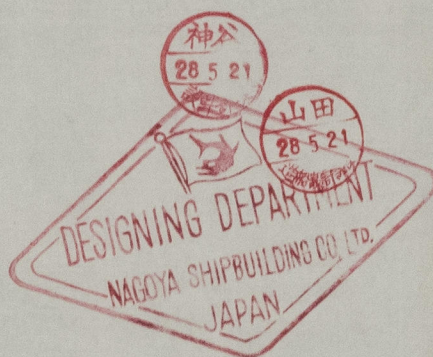

Lloyd's Register Foundation

013596-013603-0143