

TWIN SCREW LIGHTER

MIDSHIP SECTION

SCALE  $\frac{1}{2}$ " TO 1 FOOT.


DIMENSIONS :- 210.0 BP. x 42.0 MOULDED x 11.3 MOULDED.

To class BS\* for River purposes only. 6'0" draft.

These plans are submitted that the scanlings are the minimum required by the rules, errors and omissions excepted.

Equipment.

2	Bower anchors	16	cwts.	Stockless.
1	Stream anchor	50	$\frac{3}{4}$ "	sa. stock.
1	<del>Kedge anchor</del>	2	$\frac{1}{2}$ "	" " "
122	19 $\frac{1}{2}$ Chains	17	$\frac{1}{16}$ "	stad chain cable
60	"	3	"	stad wire
45	"	2	$\frac{7}{8}$ "	" "
90	"	6	$\frac{1}{2}$ "	hawser.

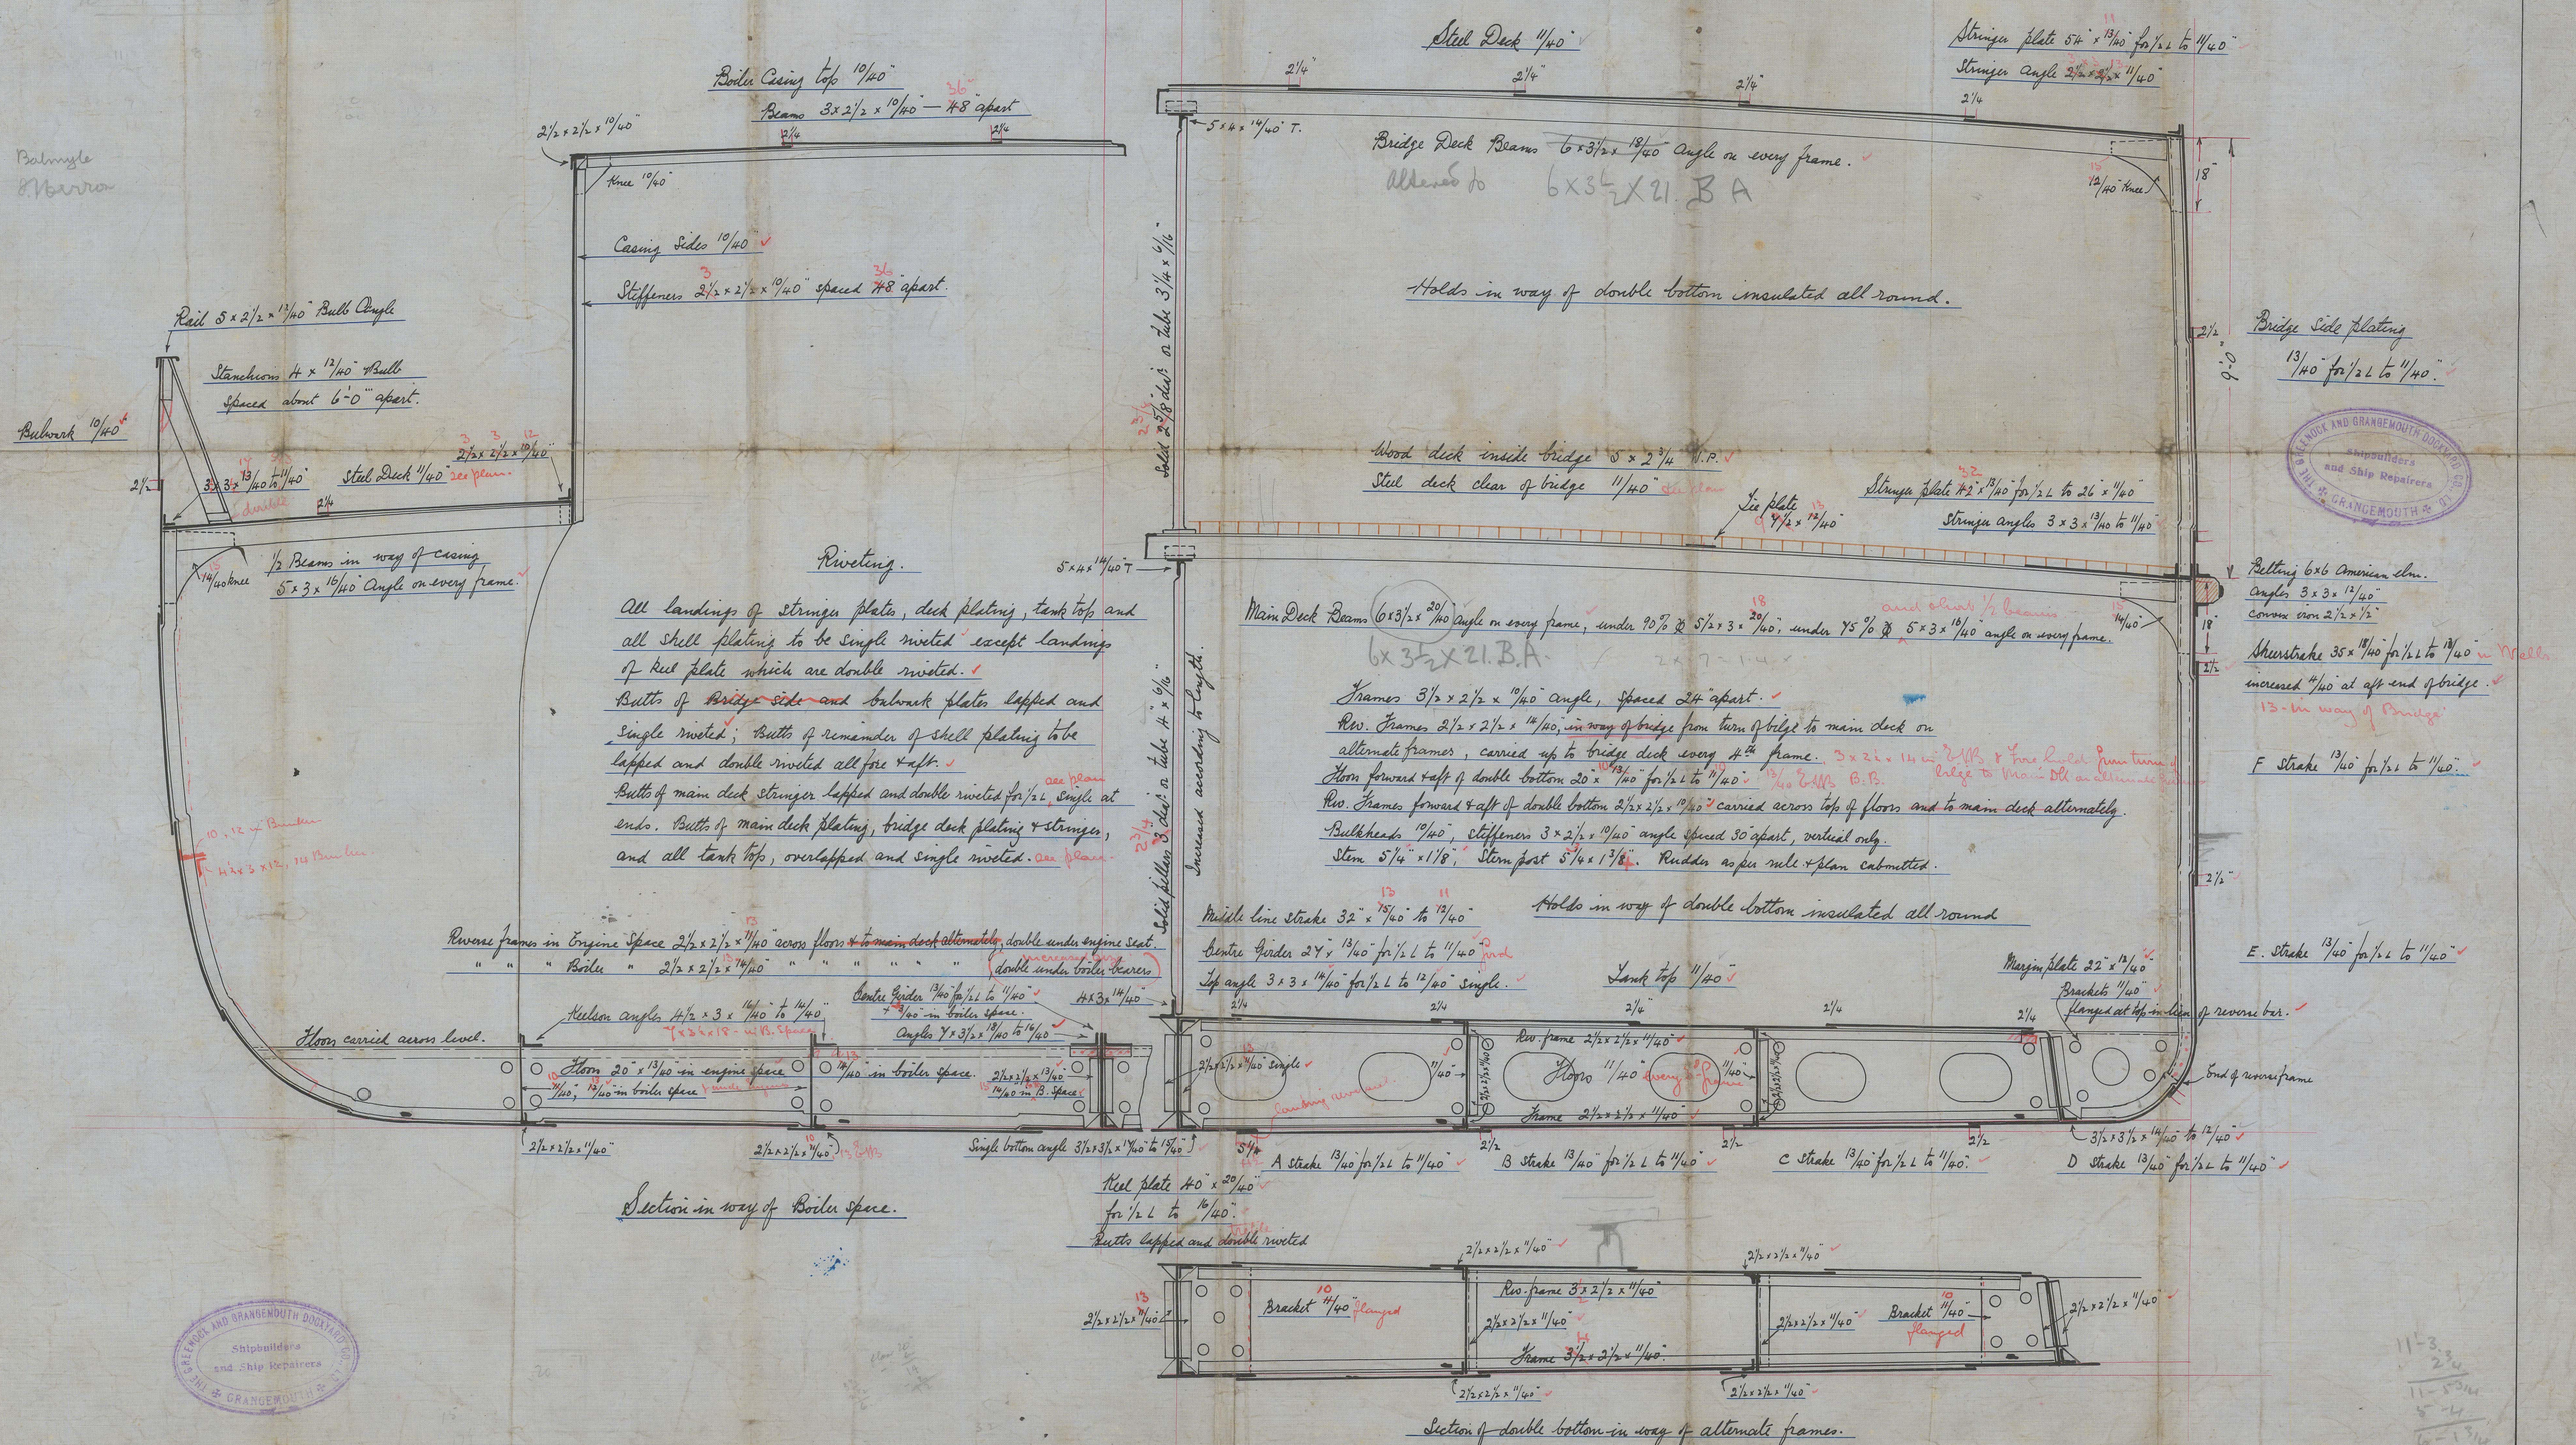



Greenock & Grangemouth 327

Midship Section

T.S.S. El Zarate

T.C. 24-8-10

013618-013626-0134



*El Zarate*  
*Greenock*








© 2021

Lloyd's Register  
Foundation