
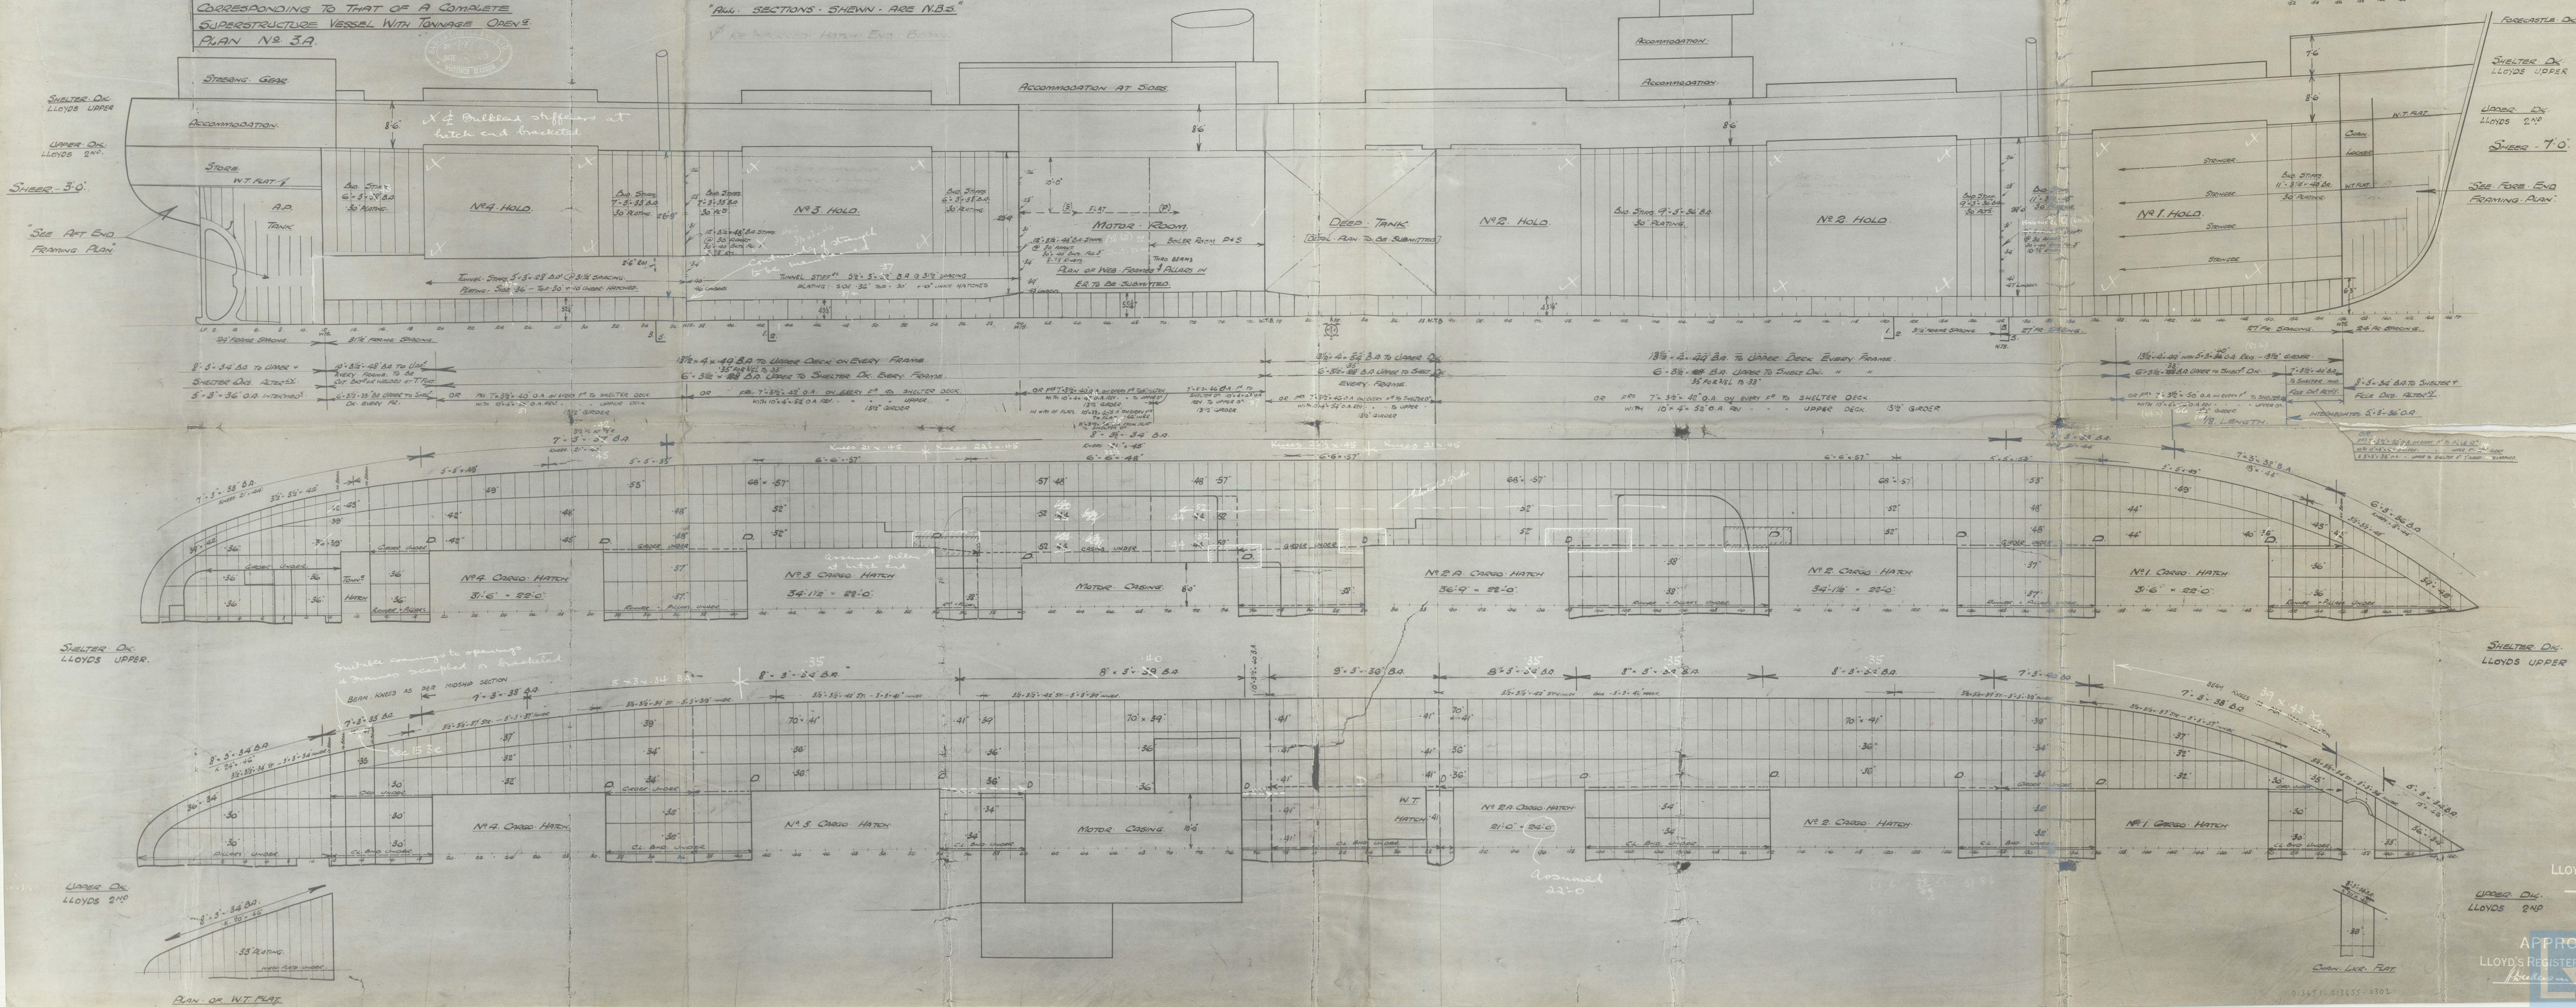


No. 658, 659 & 660 / 660.  
**PROFILE & DECKS.**  
**SCALE 1/8" = ONE FOOT.**

MUR DINGS 410'-0" x 55'-0" x 24'-0" TO CLASSE. DK (WOODS 2ND)  
CLASS 100 AT LLOYDS: WITH FREEBOARD  
CORRESPONDING TO THAT OF A COMPLETE  
SUPERSTRUCTURE VESSEL WITH TONNAGE OPEN.  
PLAN NO. 3A.

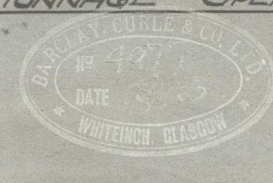

APPROVED for  
LLOYD'S REGISTER OF SHIPPING  
Hickman  
DATE 19/10/16

UPPER DECK  
LLOYDS 2ND

APPROVED © 2021  
LLOYD'S REGISTER OF SHIPPING  
Hickman  
Lloyd's Register  
Foundation



DIS/CASS  
Nº 823 C.

CATHAY TRADER 66 Z YJ

Profile & charts.

n/n 'YU LEE'

London Breeze' 658 YJ

John Breez.



© 2021

Lloyd's Register  
Foundation