

SUNDERLAND SHIPBUILDING CO. LD.
DRAWING OFFICE.
No. 13007 14 OCT. 1909
SUNDERLAND.

Saskatoon


№ 256%. PROFILE.

PRINCIPAL DIMENSIONS 250'-0" L B X 42'-6" B M L X 18'-0" D M L D.
CLASS B S * WITH FIXED FREEBOARD 14'-0" DRAFT (FRESH WATER)
SCALE 3/16" = 1'-0"

OCT 19 1909

*Approved
See letter 18.10.09
G.S.*

NOTE: - MAIN FRAMES TO EXTEND TO P'OLE DECK ALTERNATELY, AS SHOWN BELOW, WITH INTERMEDIATE STIFFENERS 3" X 3" X 1/4".

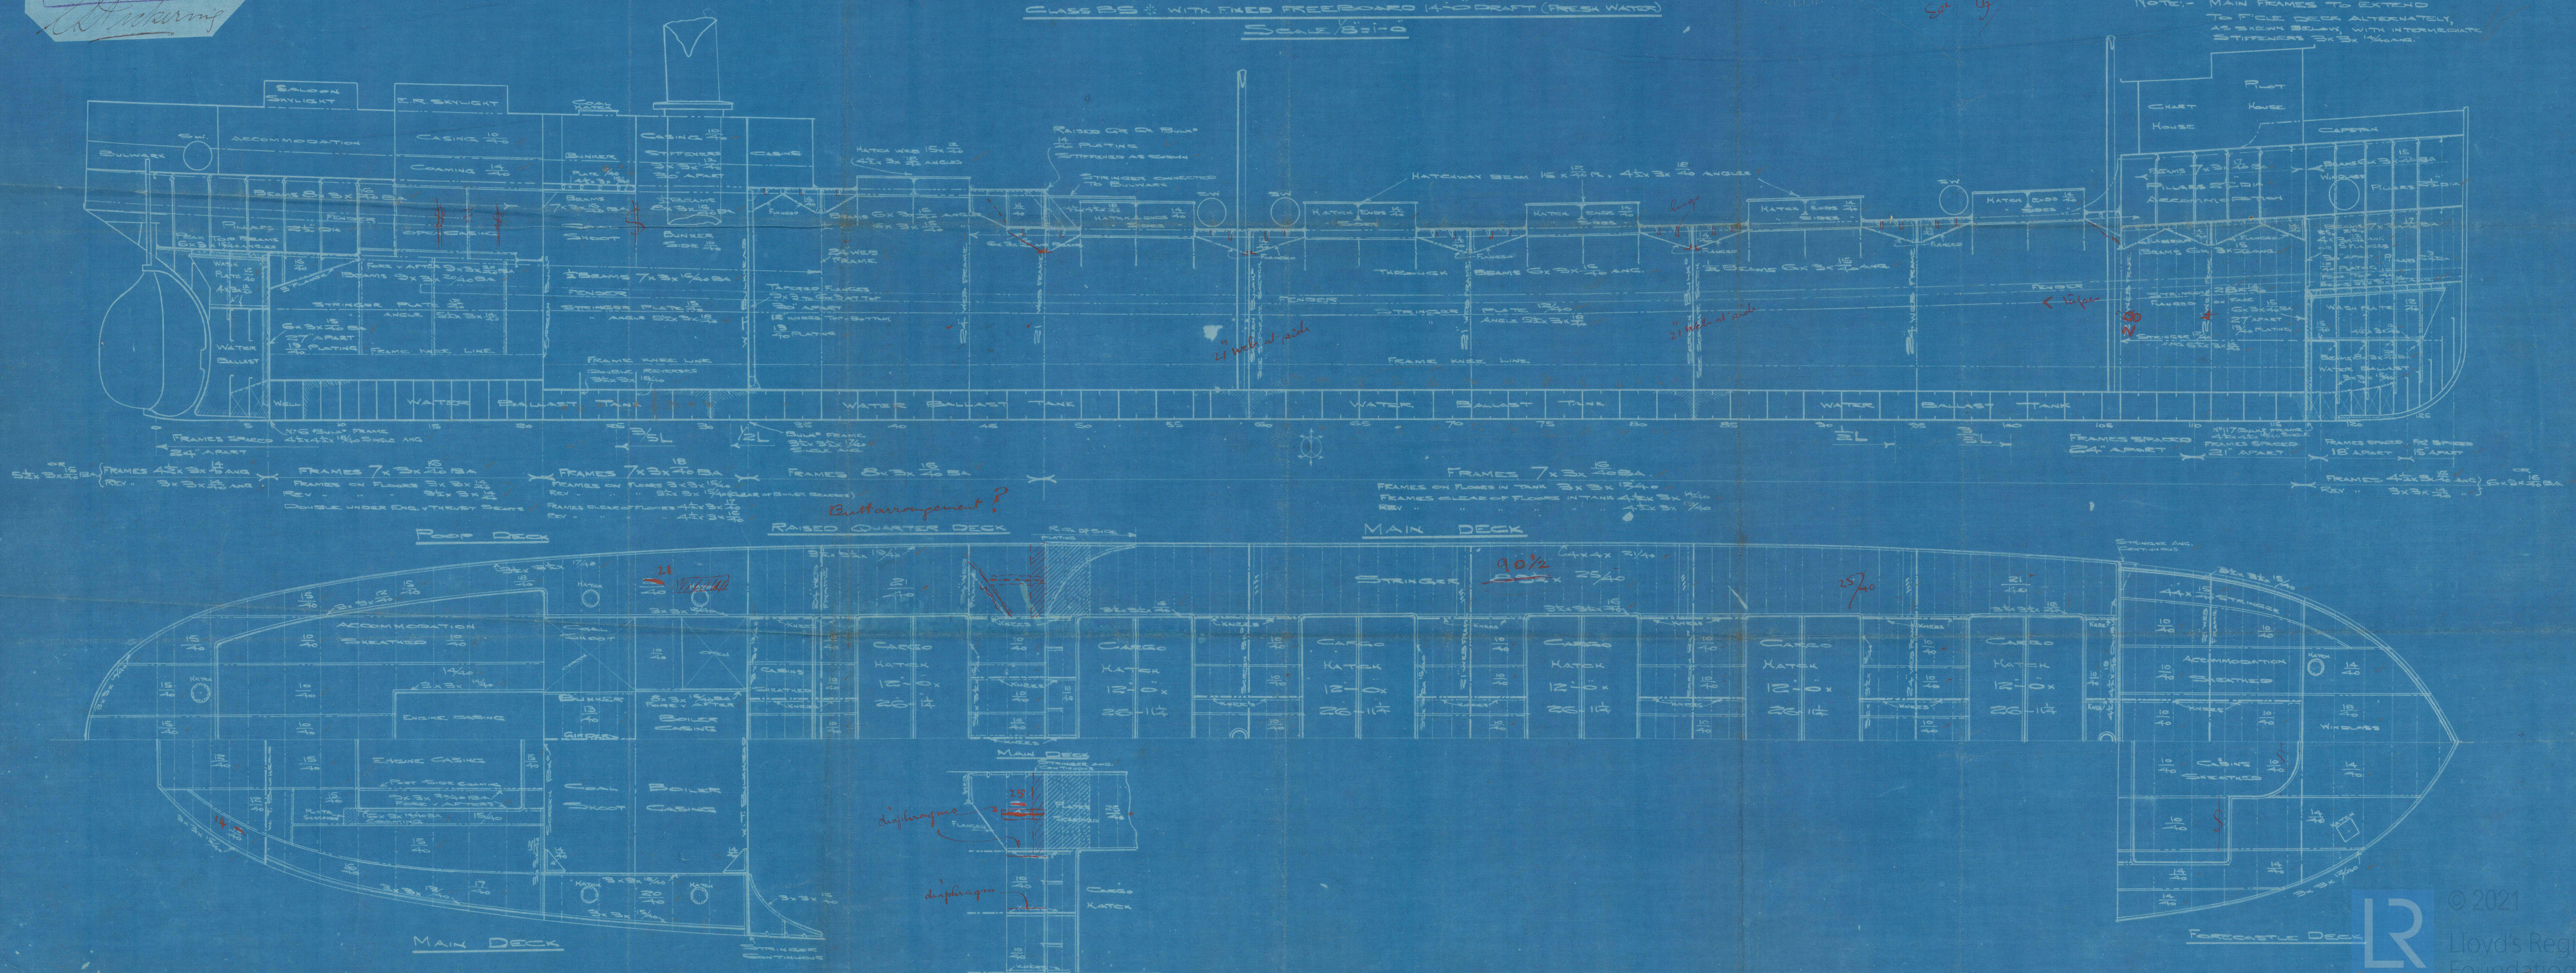

Sunderlands 256

250' x 42'-6" x 18'-6"

Profile & Deck Plans

S.S. "Baskatoon"

S.M. EMPIRE TADPOLE

T. C. 17.-11.-09.

new Basingstoke

Tondon