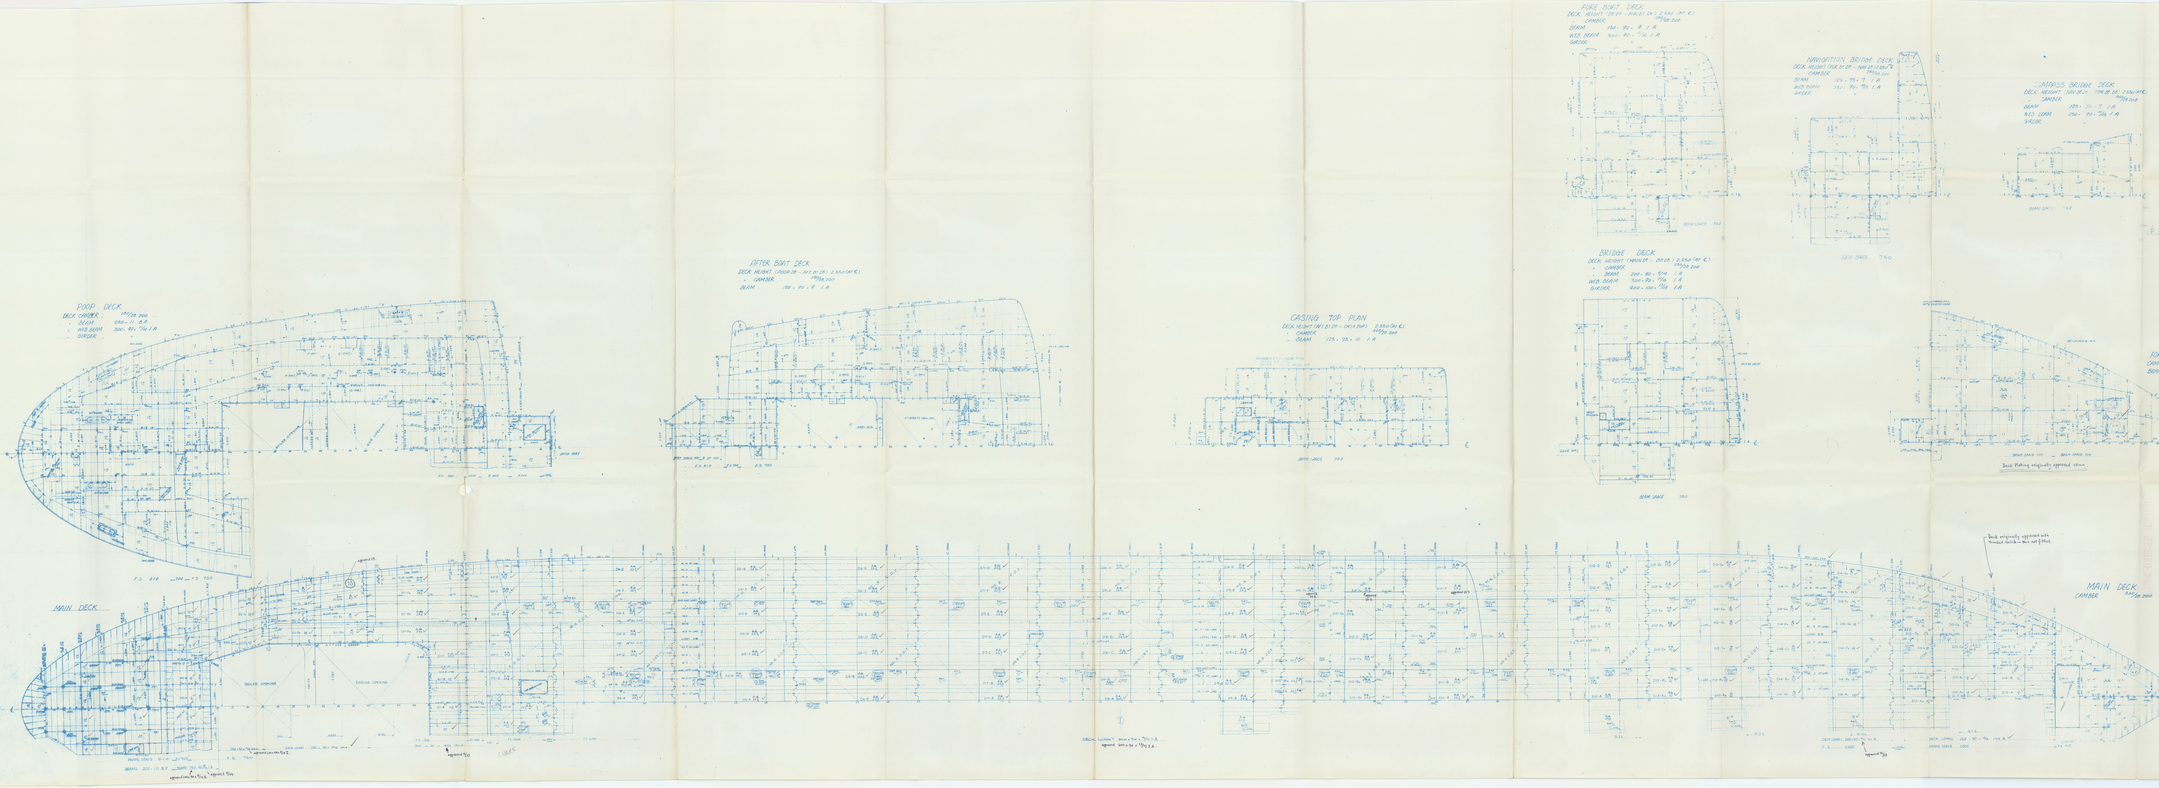

CLASS:
LLOYD'S REGISTER OF SHIPPING.
✠100A1 "CARRYING PETROLEUM IN BULK"
& ✠LMC "LONGITUDINAL FRAMING"

NIPPON KAIJI KYOKAI
NS & "DANGER, OILS - F.P. BELOW 65°C"
& MNS

PRINCIPAL DIMENSIONS:

LENGTH	P.P.	205 m 00
BREADTH	MLD	28 m 00
DEPTH	MLD	14 m 80
DRAUGHT (EXTREME)		11 m 117

NOTES:-
P. 80 & 76 MARKED PLATES TO BE OF STEEL CONFORMING TO THE REQUIREMENTS OF PS OF L.R., KSM-41 WW OF NK. & KSM-41W OF N.K.

FINISHED PLAN

GEKKO MARU
月 来 丸

TITLE

CONSTRUCTION PROFILE & DECK PLAN

1/2

SCALE 1/100 JOB NO.

KAWASAKI DOCKYARD CO. LTD.
KOBE JAPAN
SHIPDESIGNING DEPARTMENT

CHIEF OF DEPARTMENT
CHIEF OF SECTION
CHECKED BY
DRAWN BY
DATE:
SECTION NO.
DRAWING NO. HA-1308

Lloyd's Register Foundation

4/2

TO LLOYDS REGISTER OF SHIPPING

RECORDS DEPT.
LONDON.

5

CERTIFIED COPY OF APPROVED PLAN

PLACE OF APPROVAL KOBE JAPAN. DATE 1-2-57.

CERTIFIED BY W. M. Henckel DATE 23-11-59.

Kobe Rpt. No.	FE 6715
Port of Survey.	KOBE
Name of Ship.	GEKKO MARU
Title of Plan.	CONST. PROFILE + DK. 1/2.

23-11-59.

© 2021
Lloyd's Register Foundation

013735-013739-0003