

13.2.19
26.2.19
24.3.19.

SCANTLING PLAN FOR CARCO STEAMER. YARD No 233.

DRAWING No 1651.

W. J. YAPWOOD & SONS LTD.

THE DOCK,

NORTHWICH.

LENGTH 96'-0" B.P.


BREADTH 23'-0" MOULDED.

SCALE $\frac{1}{4}$ " = 1 FOOT.

DEPTH 10'-0"

FEB. 6TH 1919.

96'-0"
23'-0"
10'-0" + 3" floor

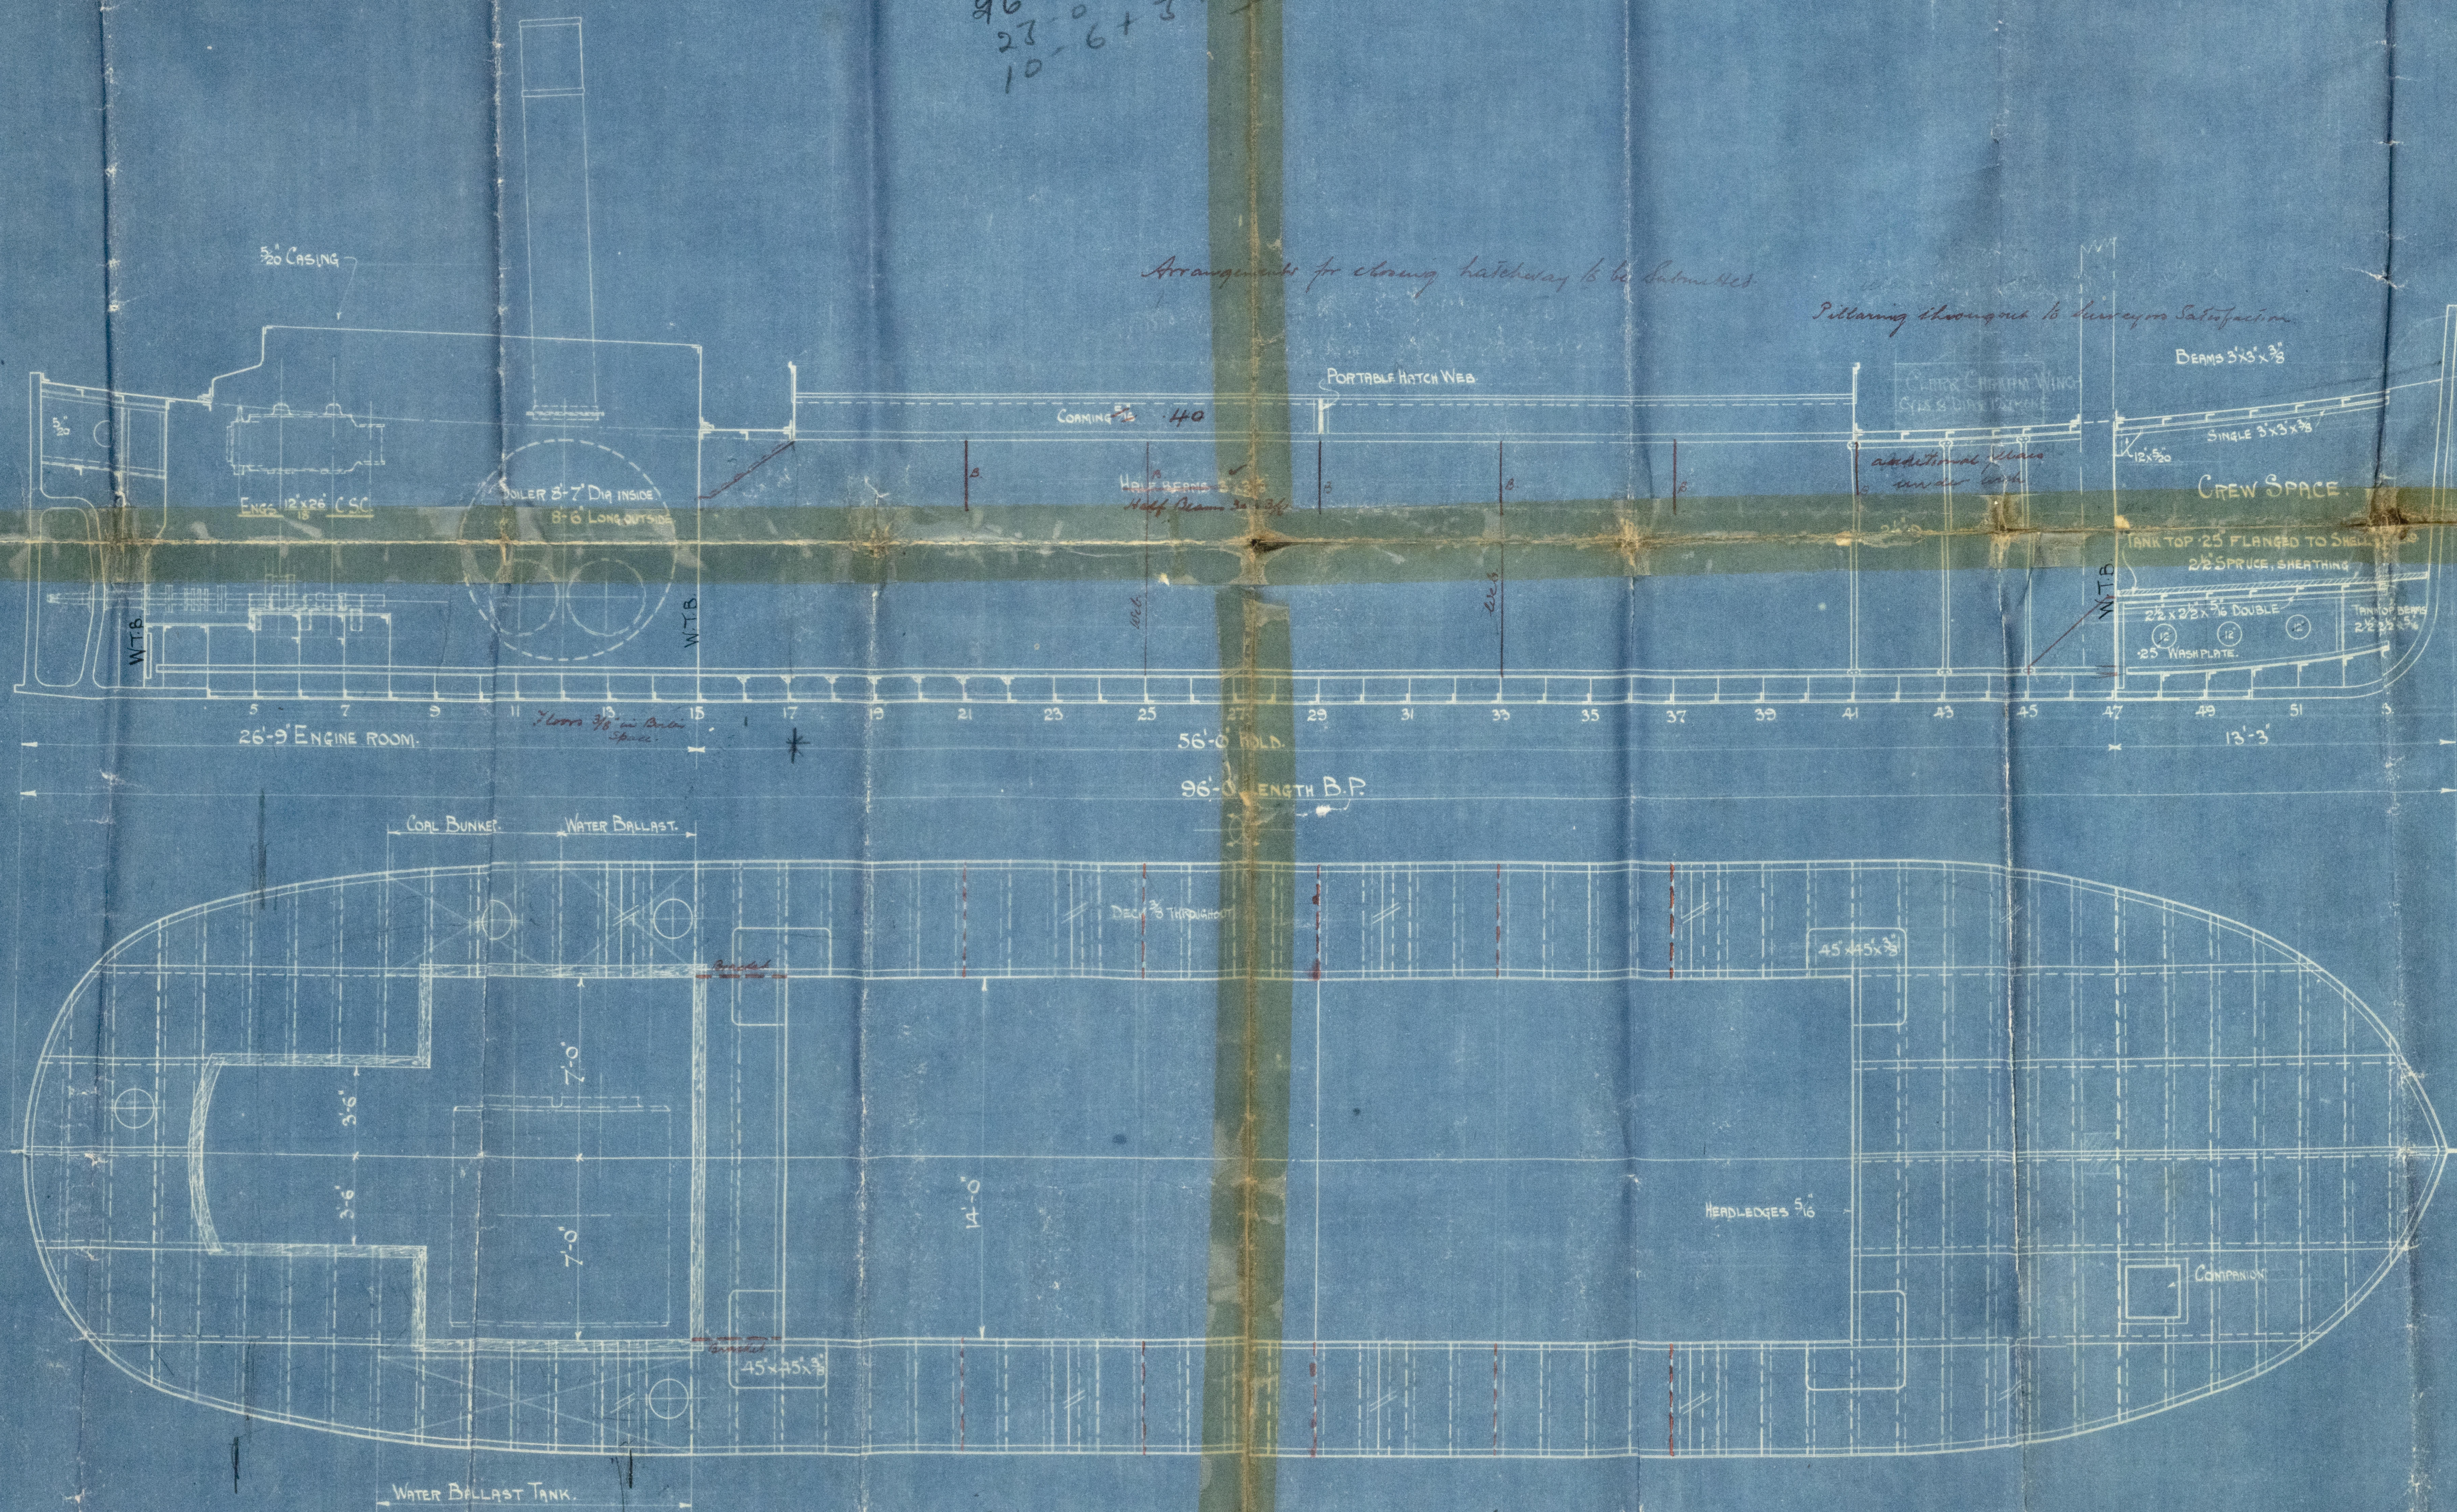

Arrangements for closing hatchway to be submitted

Pitching throughout to be on satisfaction

56'-0" H.D.
96'-0" LENGTH B.P.

BBF
13.2.19.

Yarwoods
Cargo Steamer
No. 283

Profile + Deck Plan

S.S. "W. Williams"

LIVERPOOL

Report No. 80932



© 2021

Lloyd's Register
Foundation



013750-013759-0124

