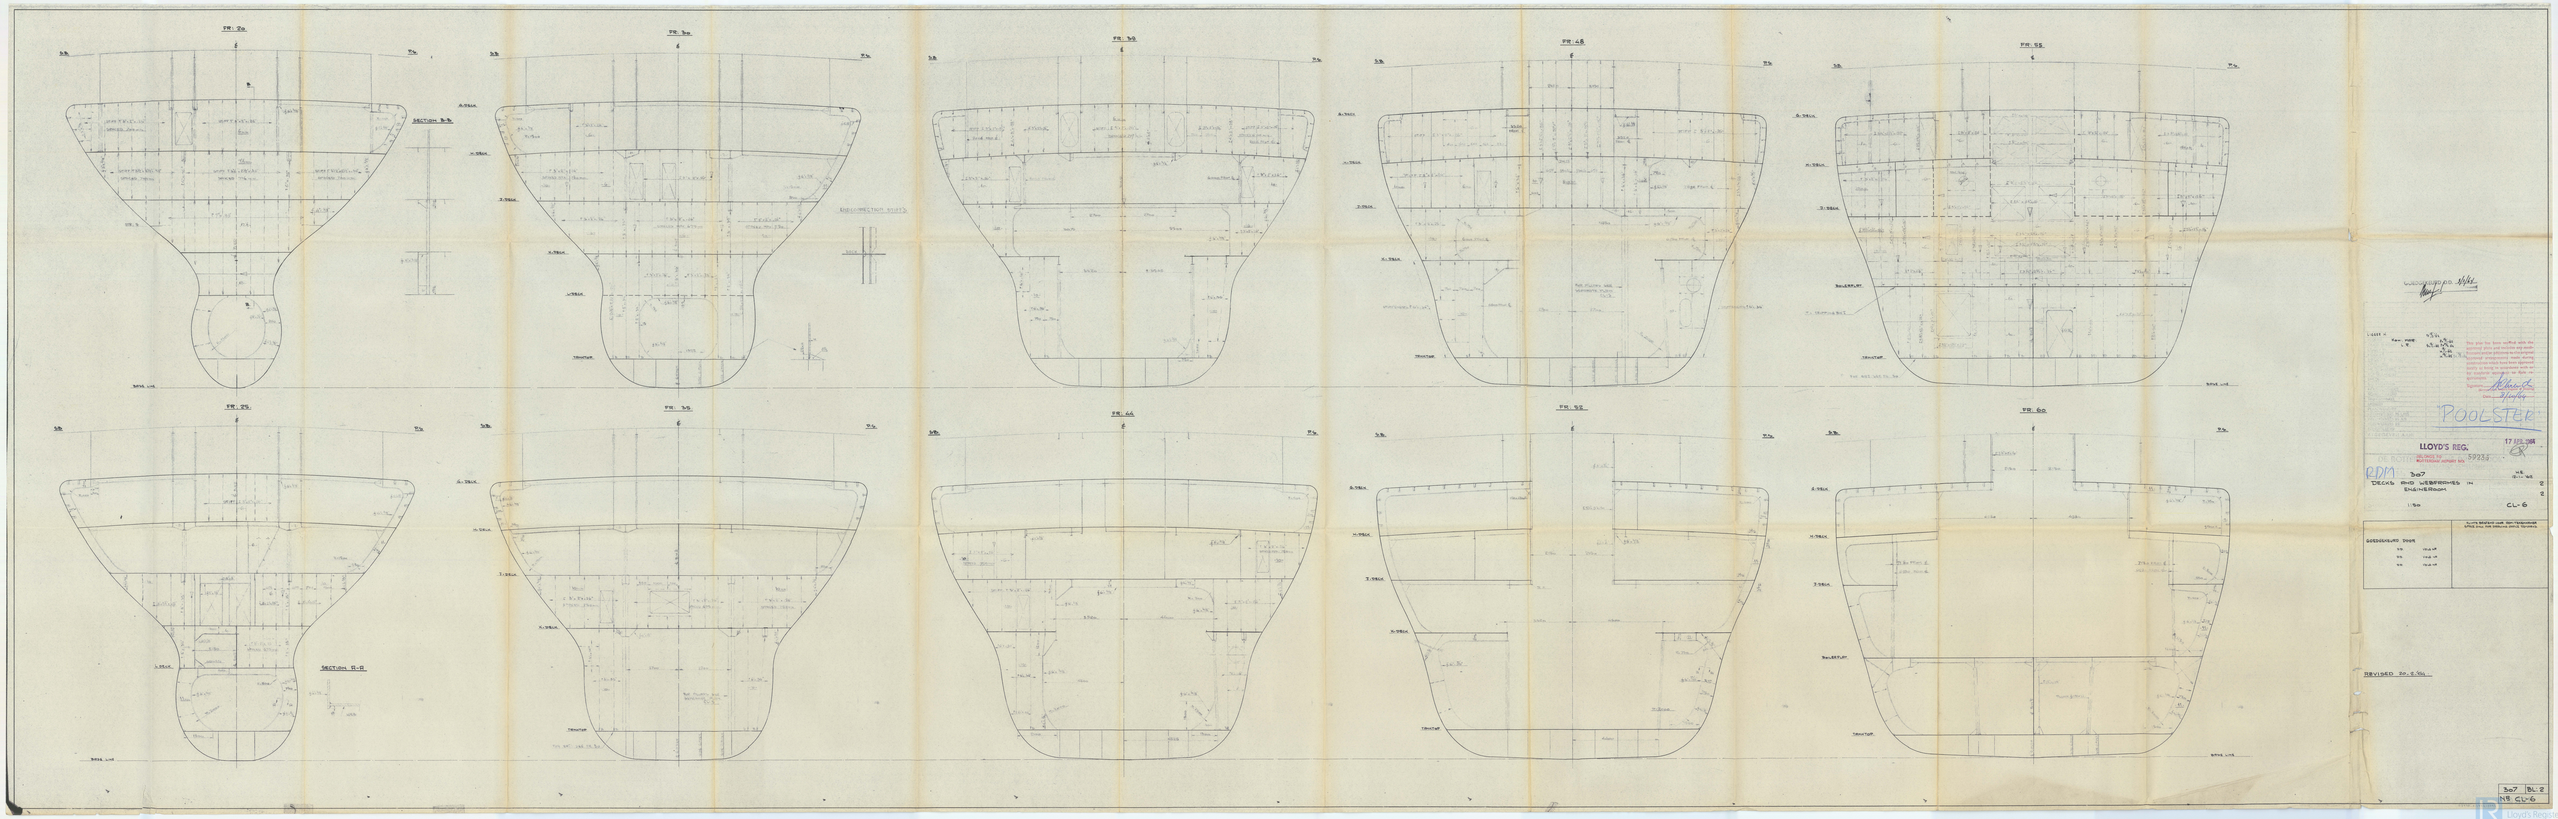
FR. 20
FR. 30
FR. 35
FR. 48
FR. 55
FR. 25
FR. 35
FR. 44
FR. 52
FR. 60
SECTION B-B
SECTION A-A
CROSSCHECKING POINTS
BASE LINE
TRANSTOR
BOILERPLAT
POOLSTER
LLOYD'S REG.
17 FEB 1964
59235
RDM 307
DECKS AND WEBFRAMES IN ENGINEROOM
1:50
CL-6
GOEDGEKEURD DOOR
REVISED 20.2.'64
307 BL-2
NB CL-6

D/S 911

RECORDS DEPT.,
LONDON.

"POOLSTER"

1

Decks & Webs frames in
E.R.

013770-013774-0092

© 2021
Lloyd's Register
Foundation