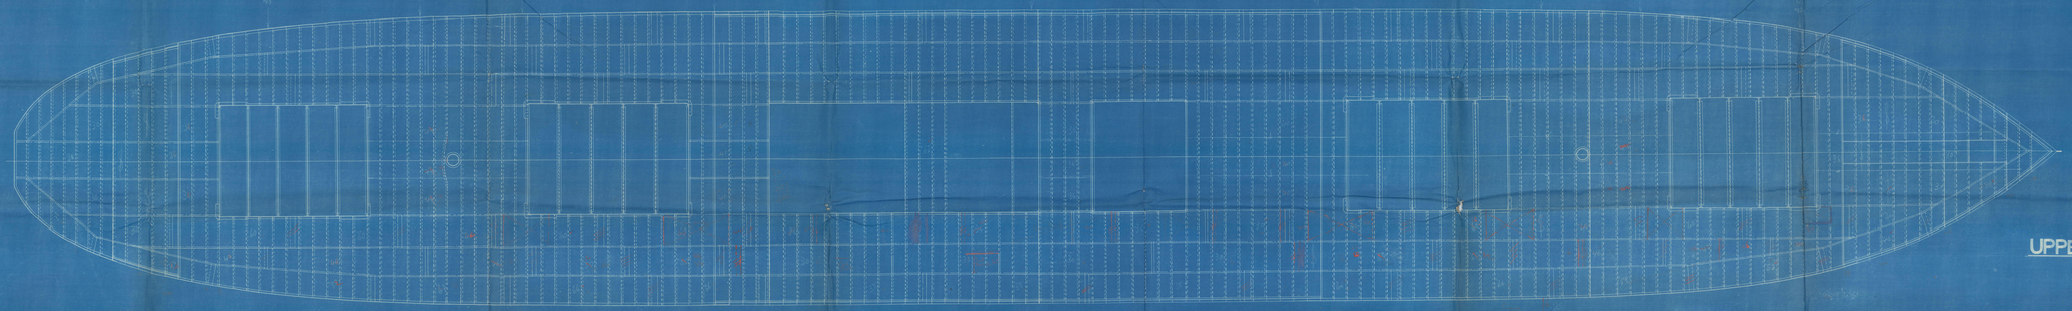

Nº 340.

UPPER DECK PLAN.

SCALE:- ¼ INCH = ONE FOOT.

Lloyd's Register Foundation

Dunlop Bremners

340 S/S

Deck plan

Bag 1

013775-013782-0067

Dunlop Bremner + CL

340

Deck plans

(10)

8. 9. 19

SS ELMONTECILLO

© 2021 Lloyd's Register Foundation