

V. No. 136.

# PROFILE & DEK PLAN.

Dimensions:- 105'-0" B.P. x 27'-0" Mid. x 13'-6" Mid.

Scale  $\frac{1}{4}$  in. = 1 ft.

LLOYDS NUMERALS

$L \times D = 105 \times 27 = 2835$

$L(B+D) = 105(27+13.5) = 4252.5$

$d = 11.84$

$D = 135 = 7.77$

CLASS:- LLOYDS 100 A.I. FOR TOWING SERVICES

29/12/25 R.P.

30" CASING TOP  
3 1/2" x 3 1/2" x 35" O.A. BEAMS  
SPACED ABOUT 30" APART.

BOILER CASING

SIDE PLATING 1/2" THK COAMING 30" THK  
STIFFENERS 3 1/2" x 3 1/2" x 35" O.A.  
SPACED ABOUT 30" APART.

SAILOON

3" x 3" x 32" HORIZONTAL  
LUGS 6 LONG

3" x 3" x 30" SINGLE LUGS

STORE

WOOD FLAT

CHAIN LOCKER

3" x 3" x 30" BRACKETS

3" x 3" x 30" SINGLE LUGS

WOOD FLAT

CHAIN LOCKER





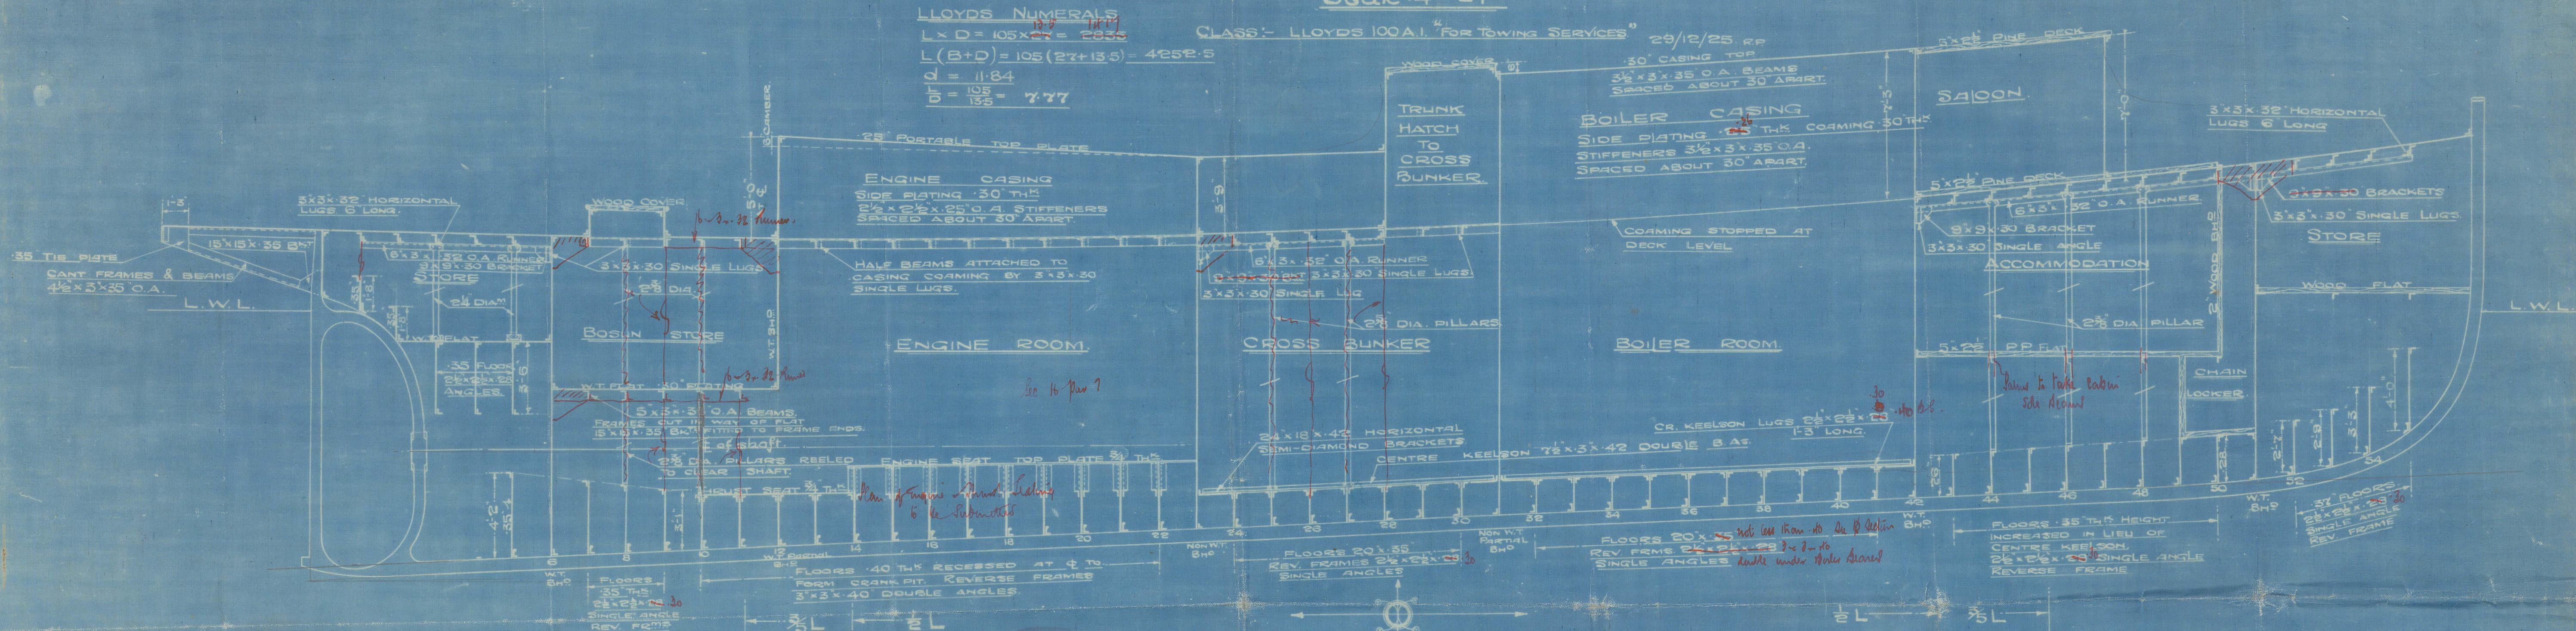

FRAMES SPACED 22" APART THROUGHOUT  
FRAMES IN AFT PEAK TANK 4 1/2" x 5" x 38" O.A.  
FRAMES ELSEWHERE 4 1/2" x 3" x 35" B.A.  
BULKHEAD FRAMES 3" x 3" x 40" O.A.

## PROFILE

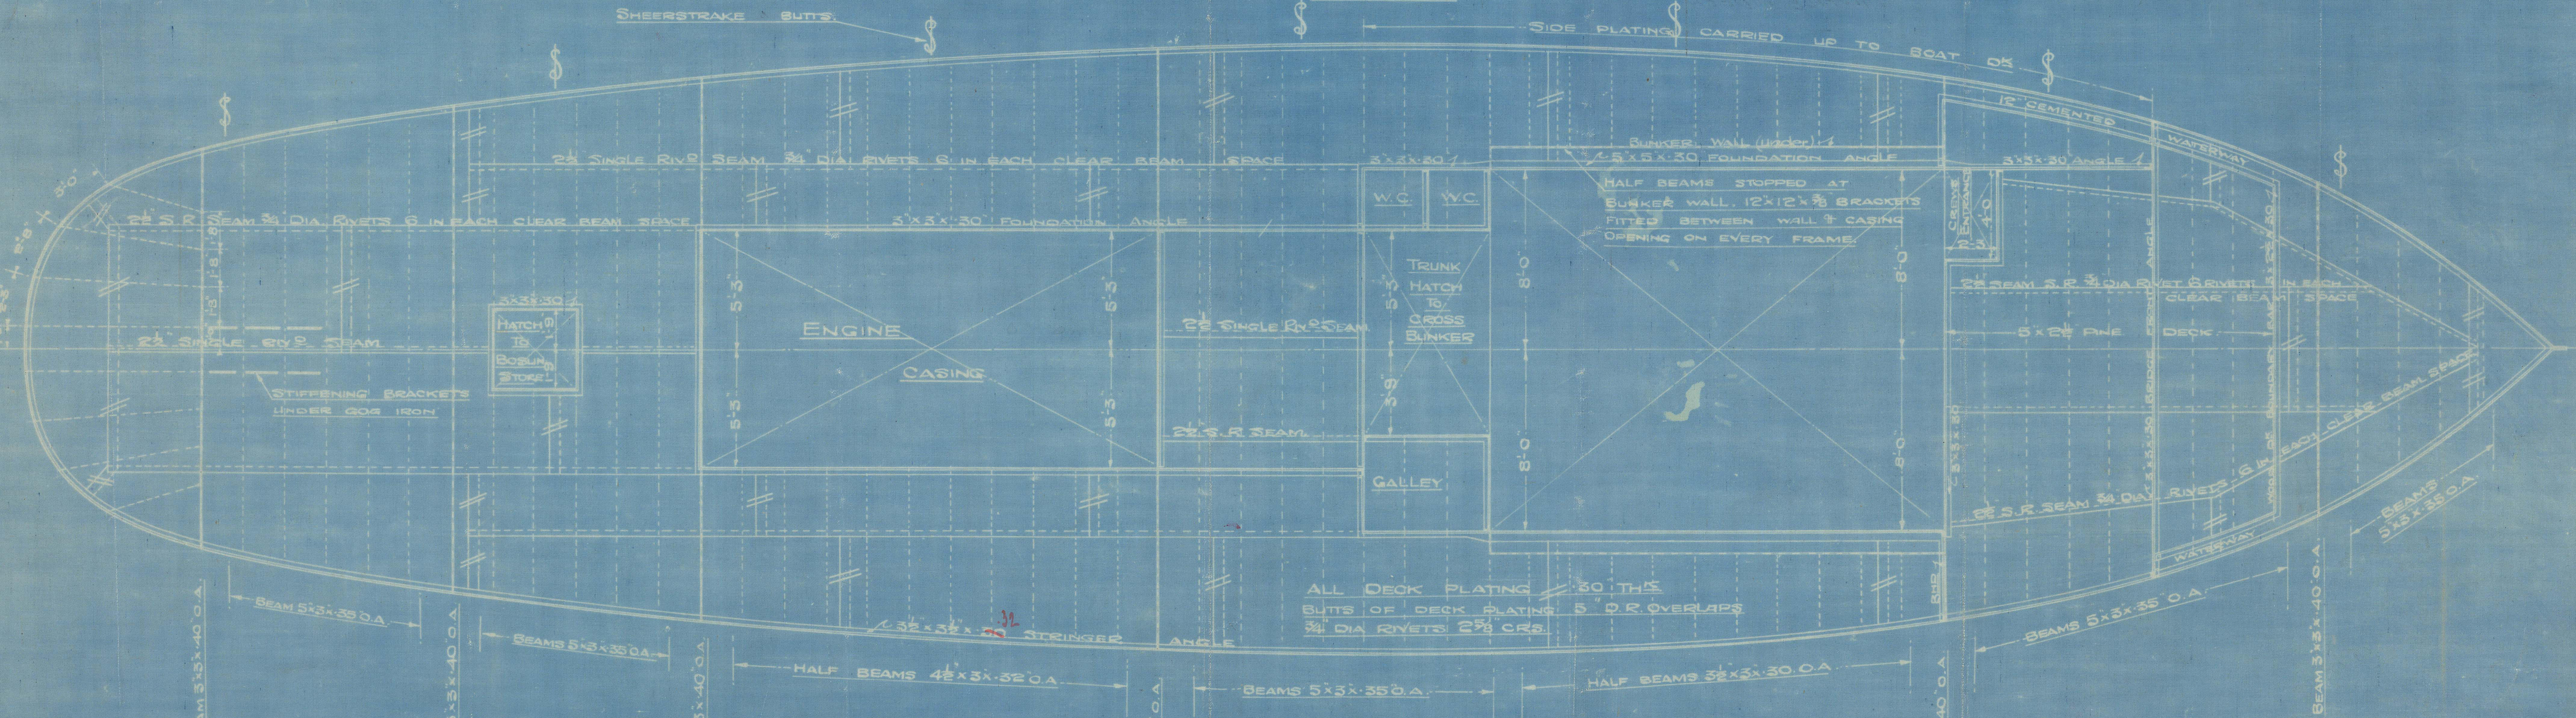

## MAIN DECK PLAN

APPROVED  
LLOYDS REGISTER OF SHIPPING


Management per [Signature]



Museo Can. & Smithsonian Lt.  
V N°136

PROFILE & DECK

S.S. "Wellington"

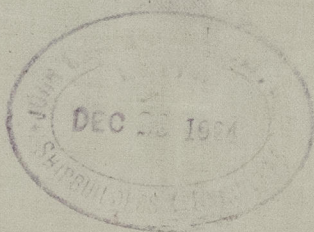

25  
29  
5460  
3260  
00

013794-013805-0184



© 2021

Lloyd's Register  
Foundation