

V. N<sup>o</sup> 136.

# STERNFRAME & RUDDER.

SCALES 1/2" & 3/4" = 1 FT.

ALL TO LLOYDS TESTS & REQUIREMENTS

A x D = 50.47 x 2.58 = 130.2




DIAM OF RUDDER HEAD (per Table 41) SPEED

NOT EXCEEDING 10 KNOTS =  $5\frac{1}{2}$  123 = d


DIAM OF RUDDER HEAD FOR TUGS =  $d + \frac{1}{2} = 6"$

STERNFRAME TO BE FORGED IRON.

20/1/26  
R.P.

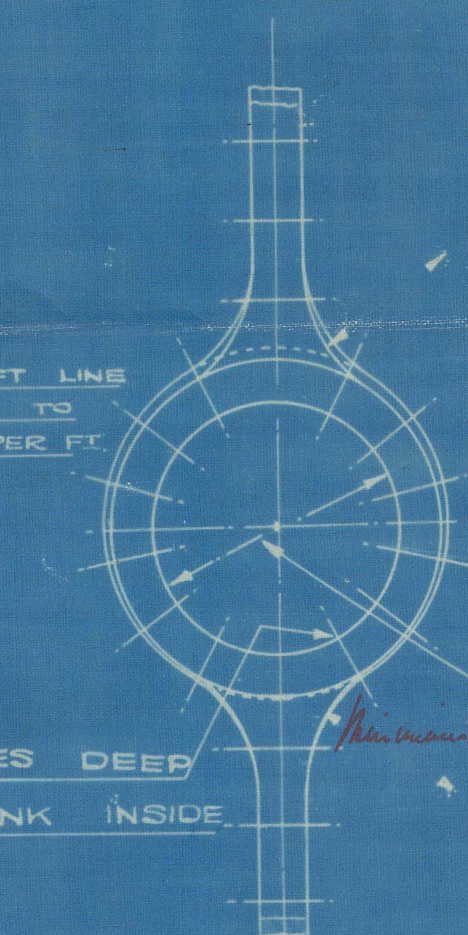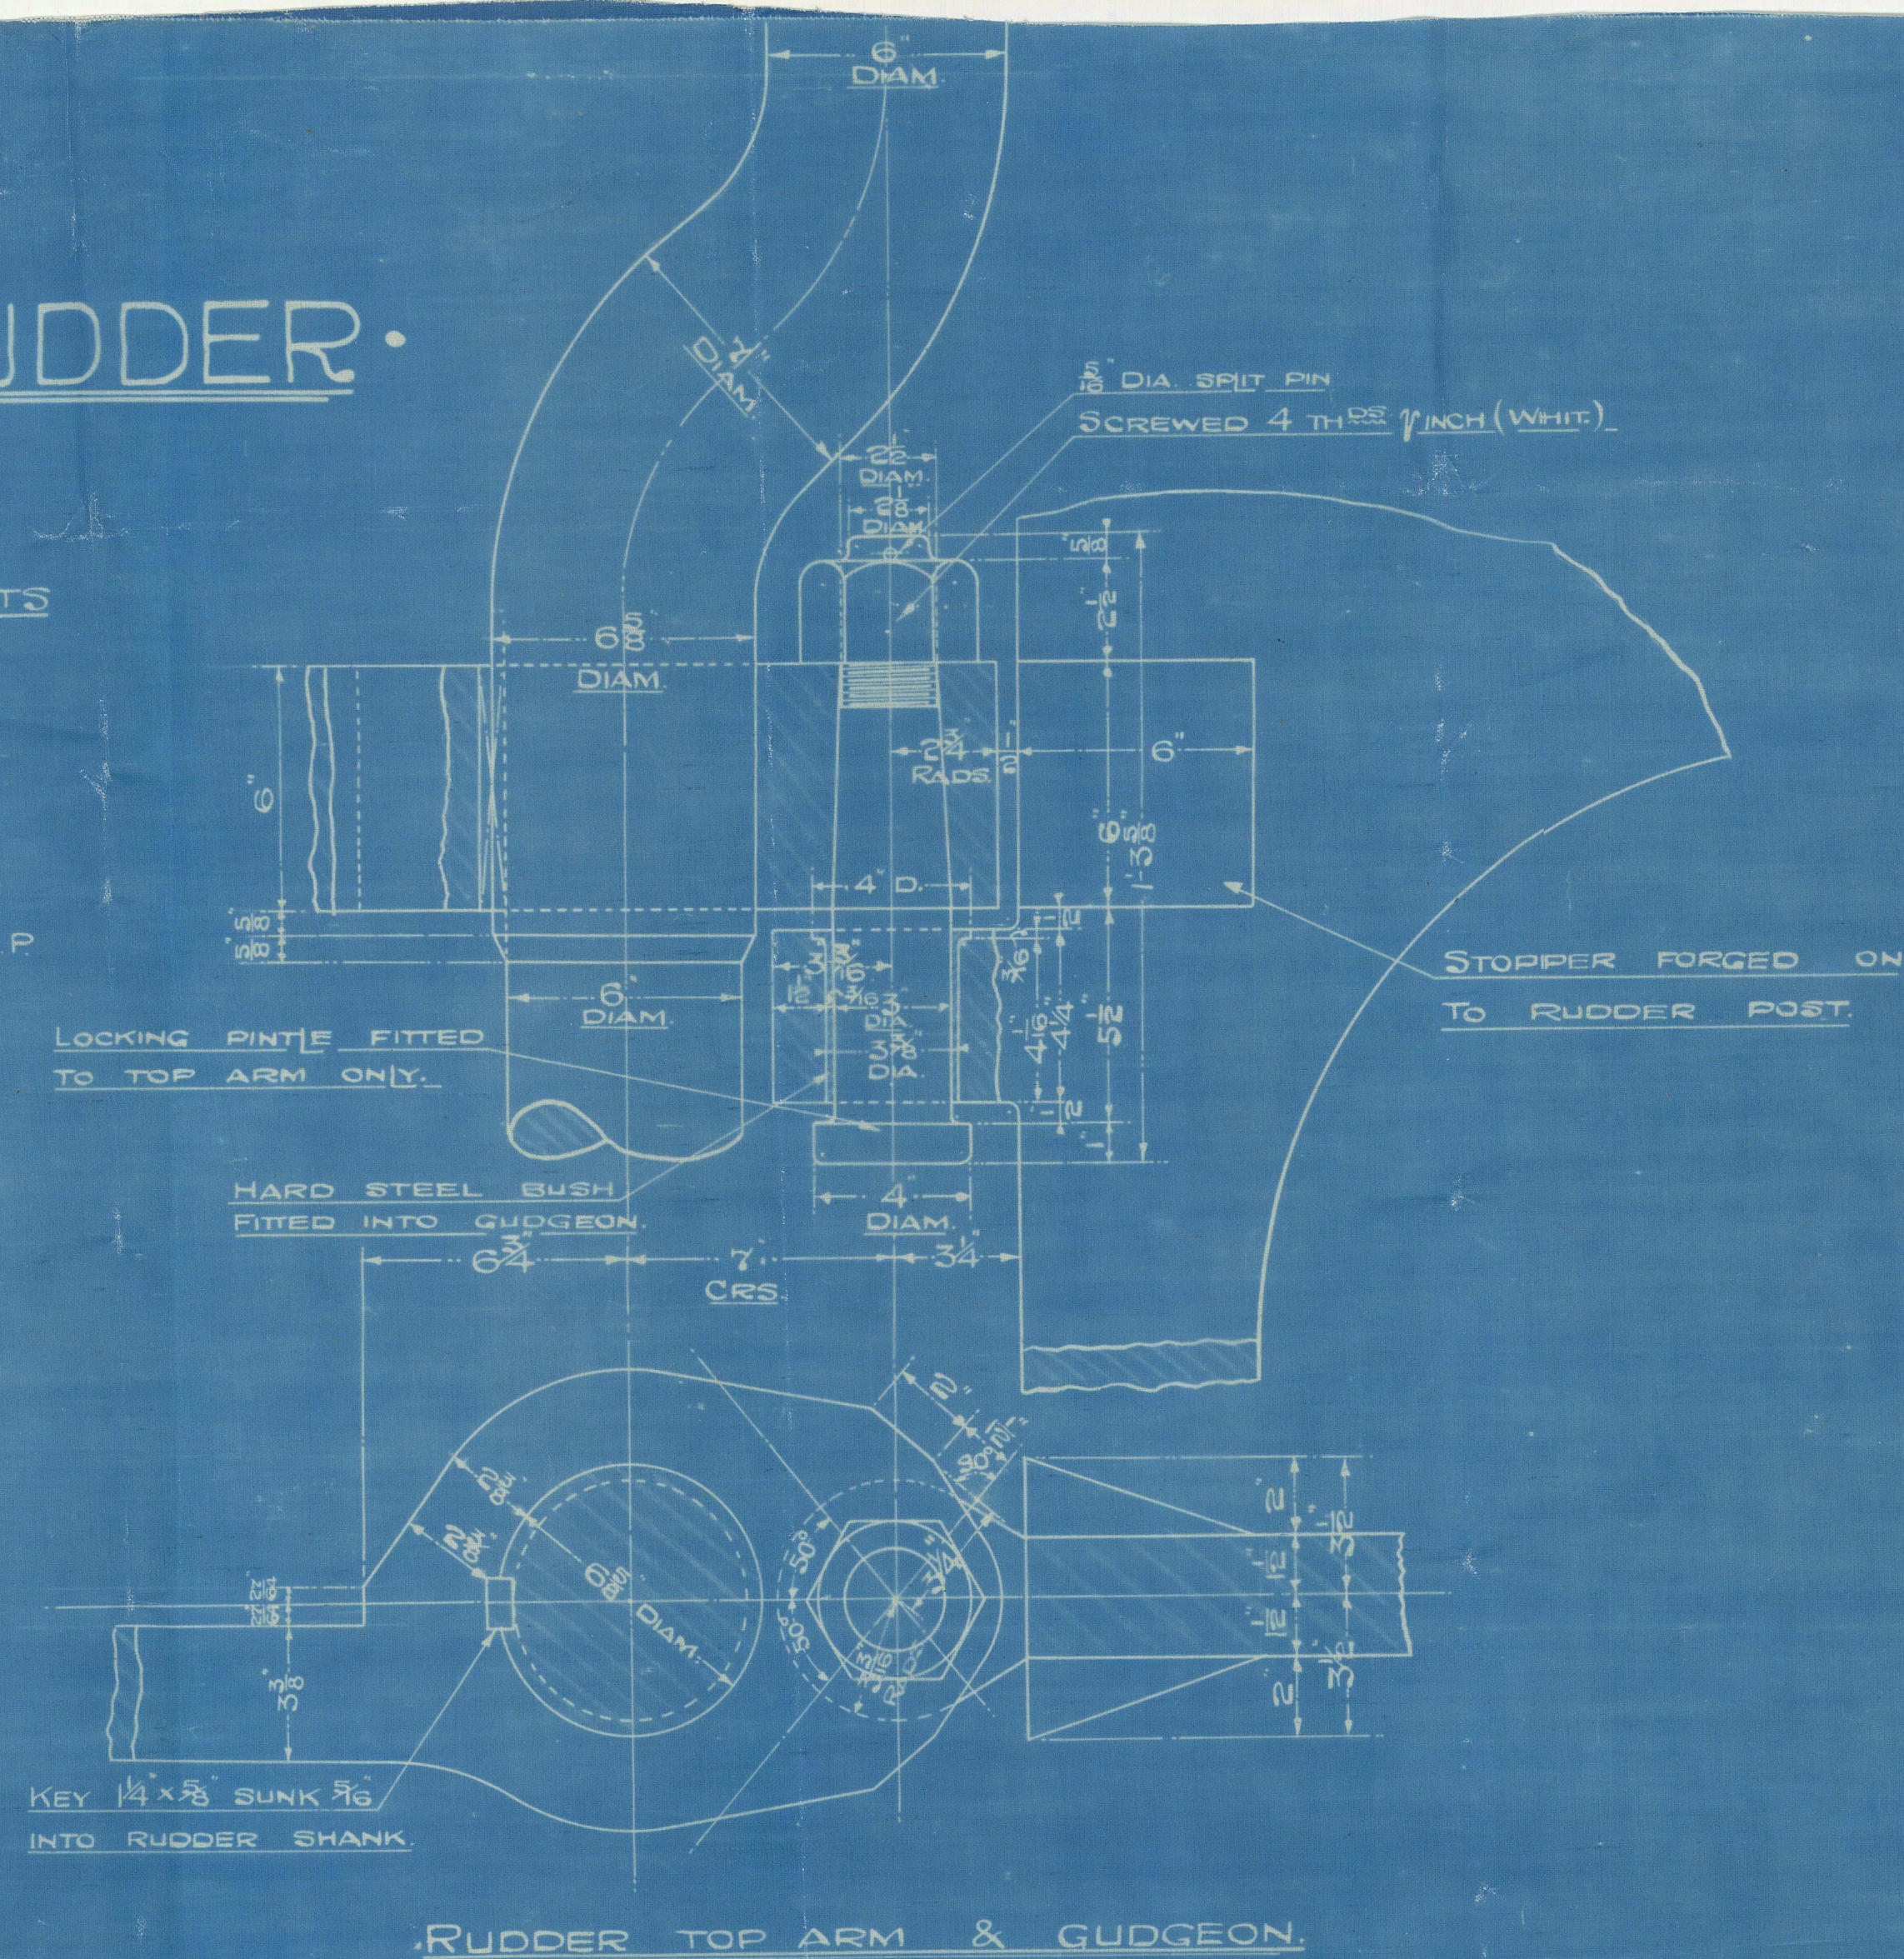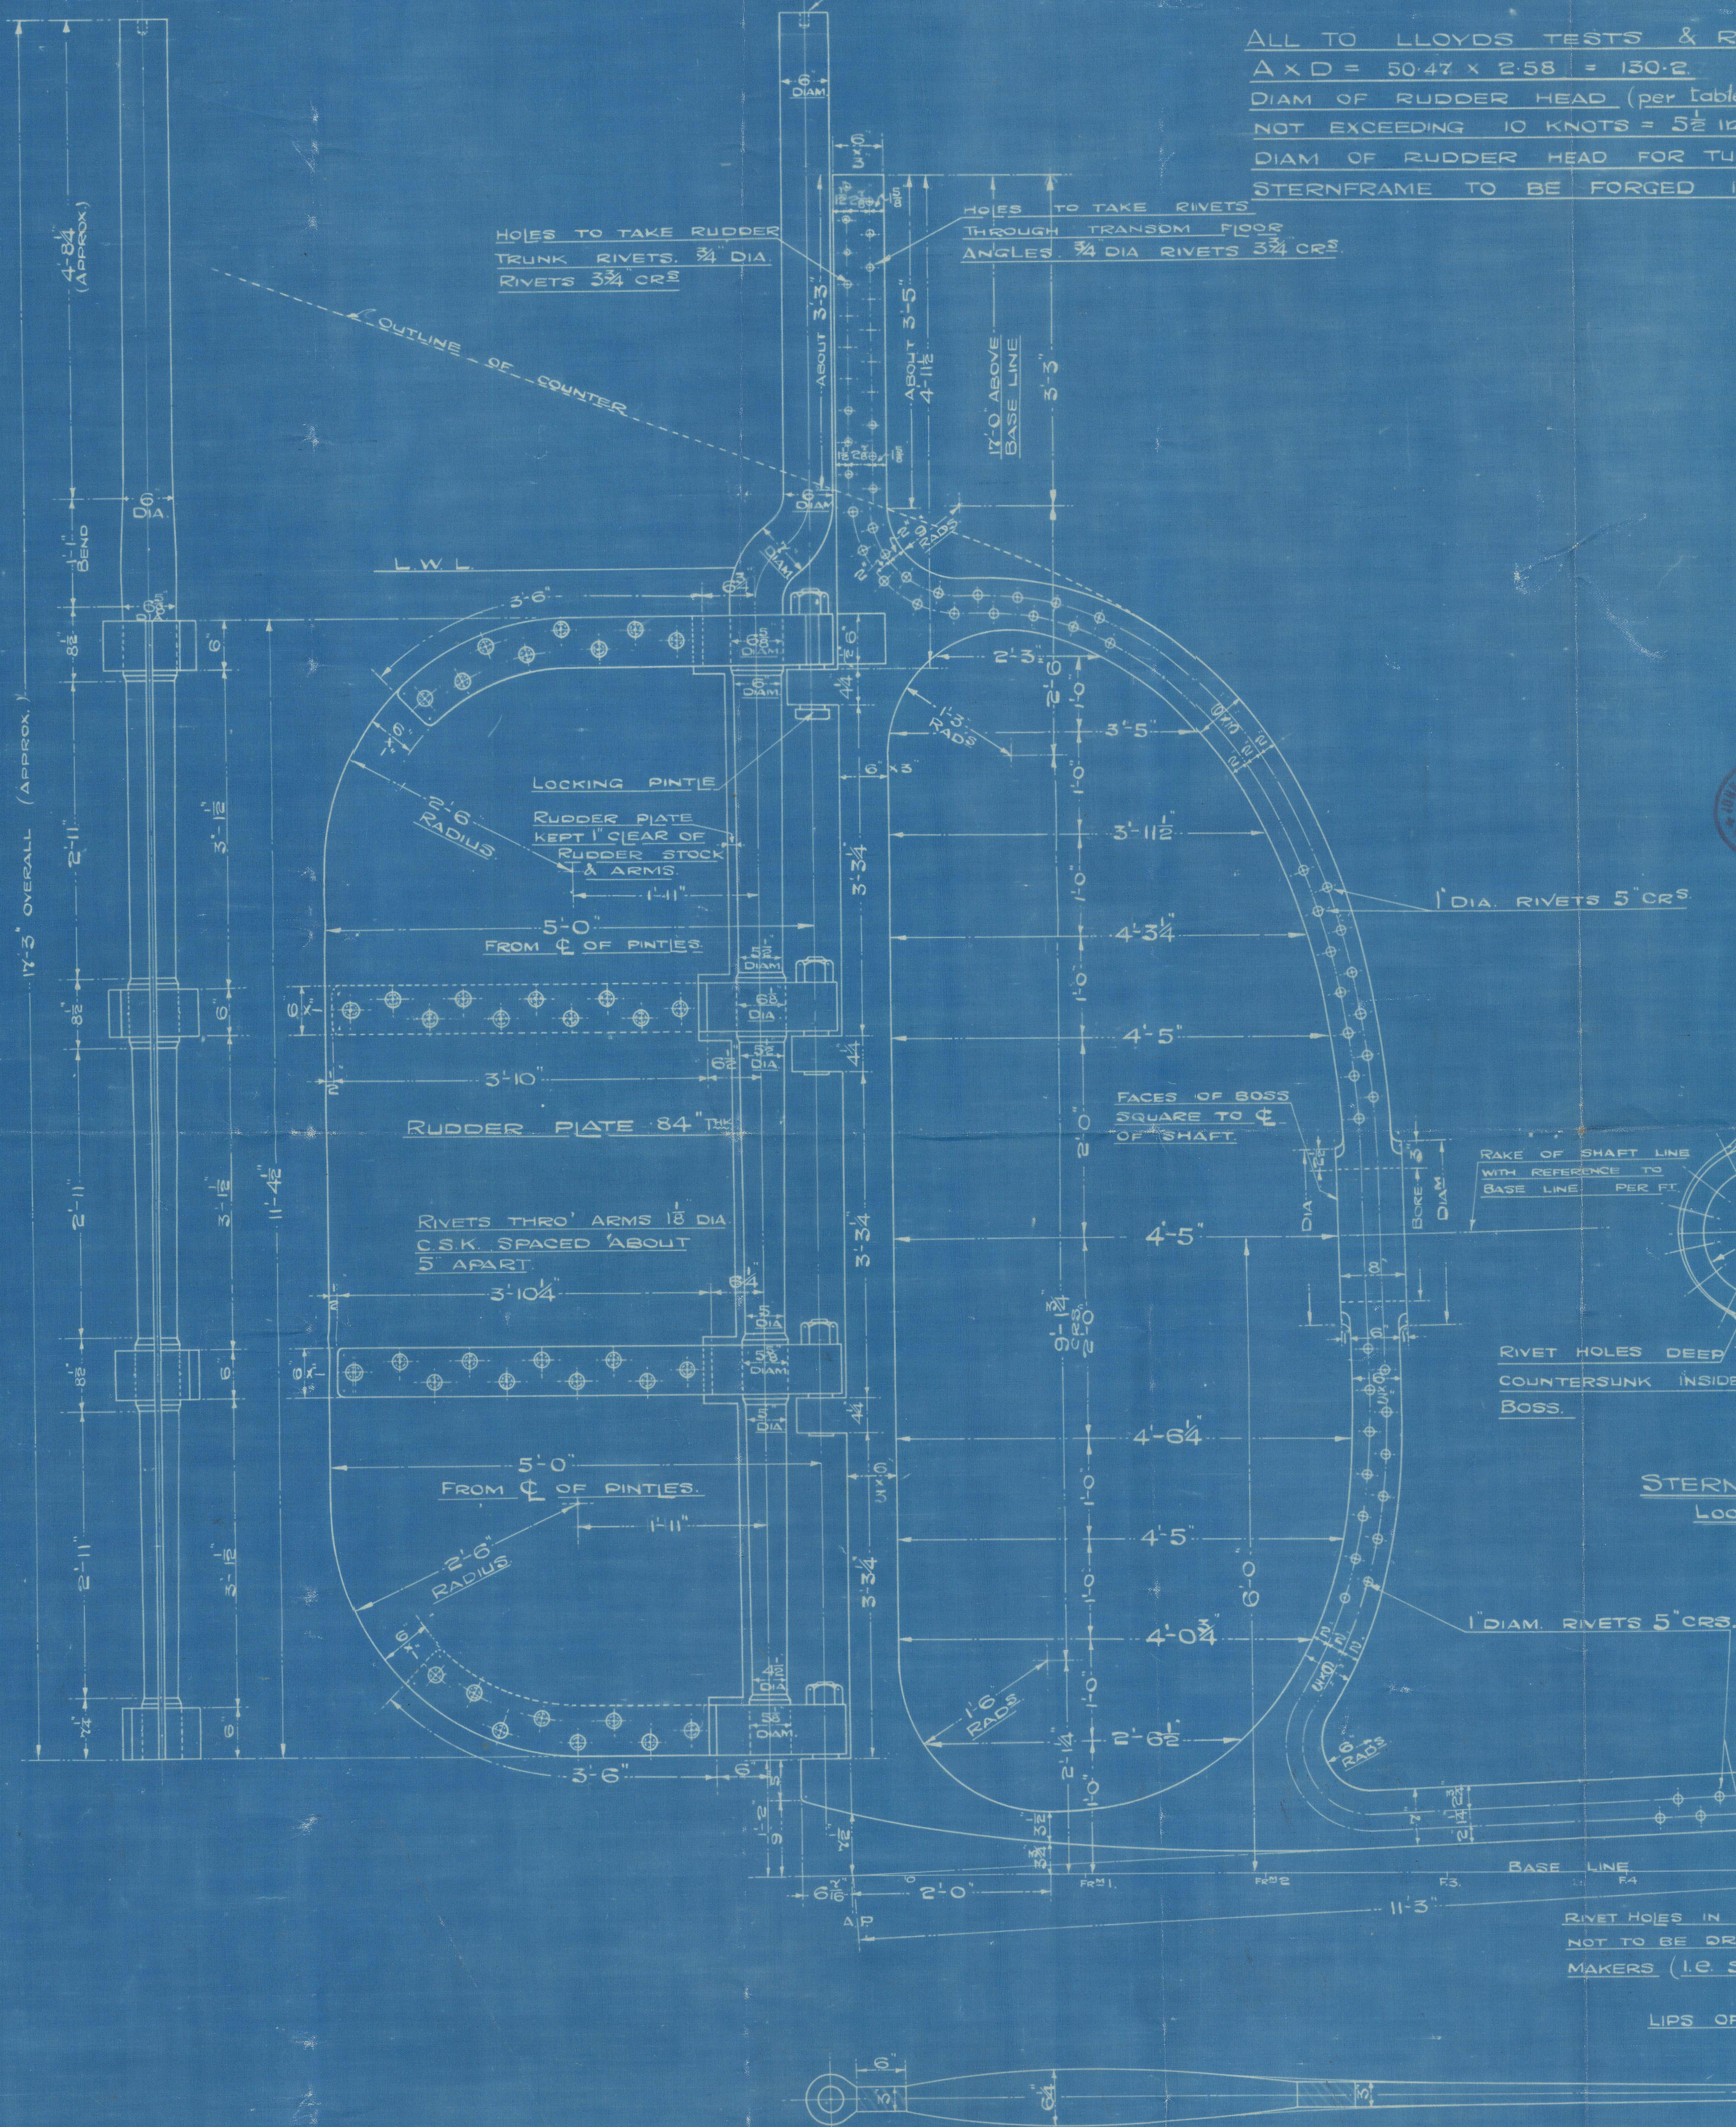

STERNFRAME BOSS  
Looking forward.

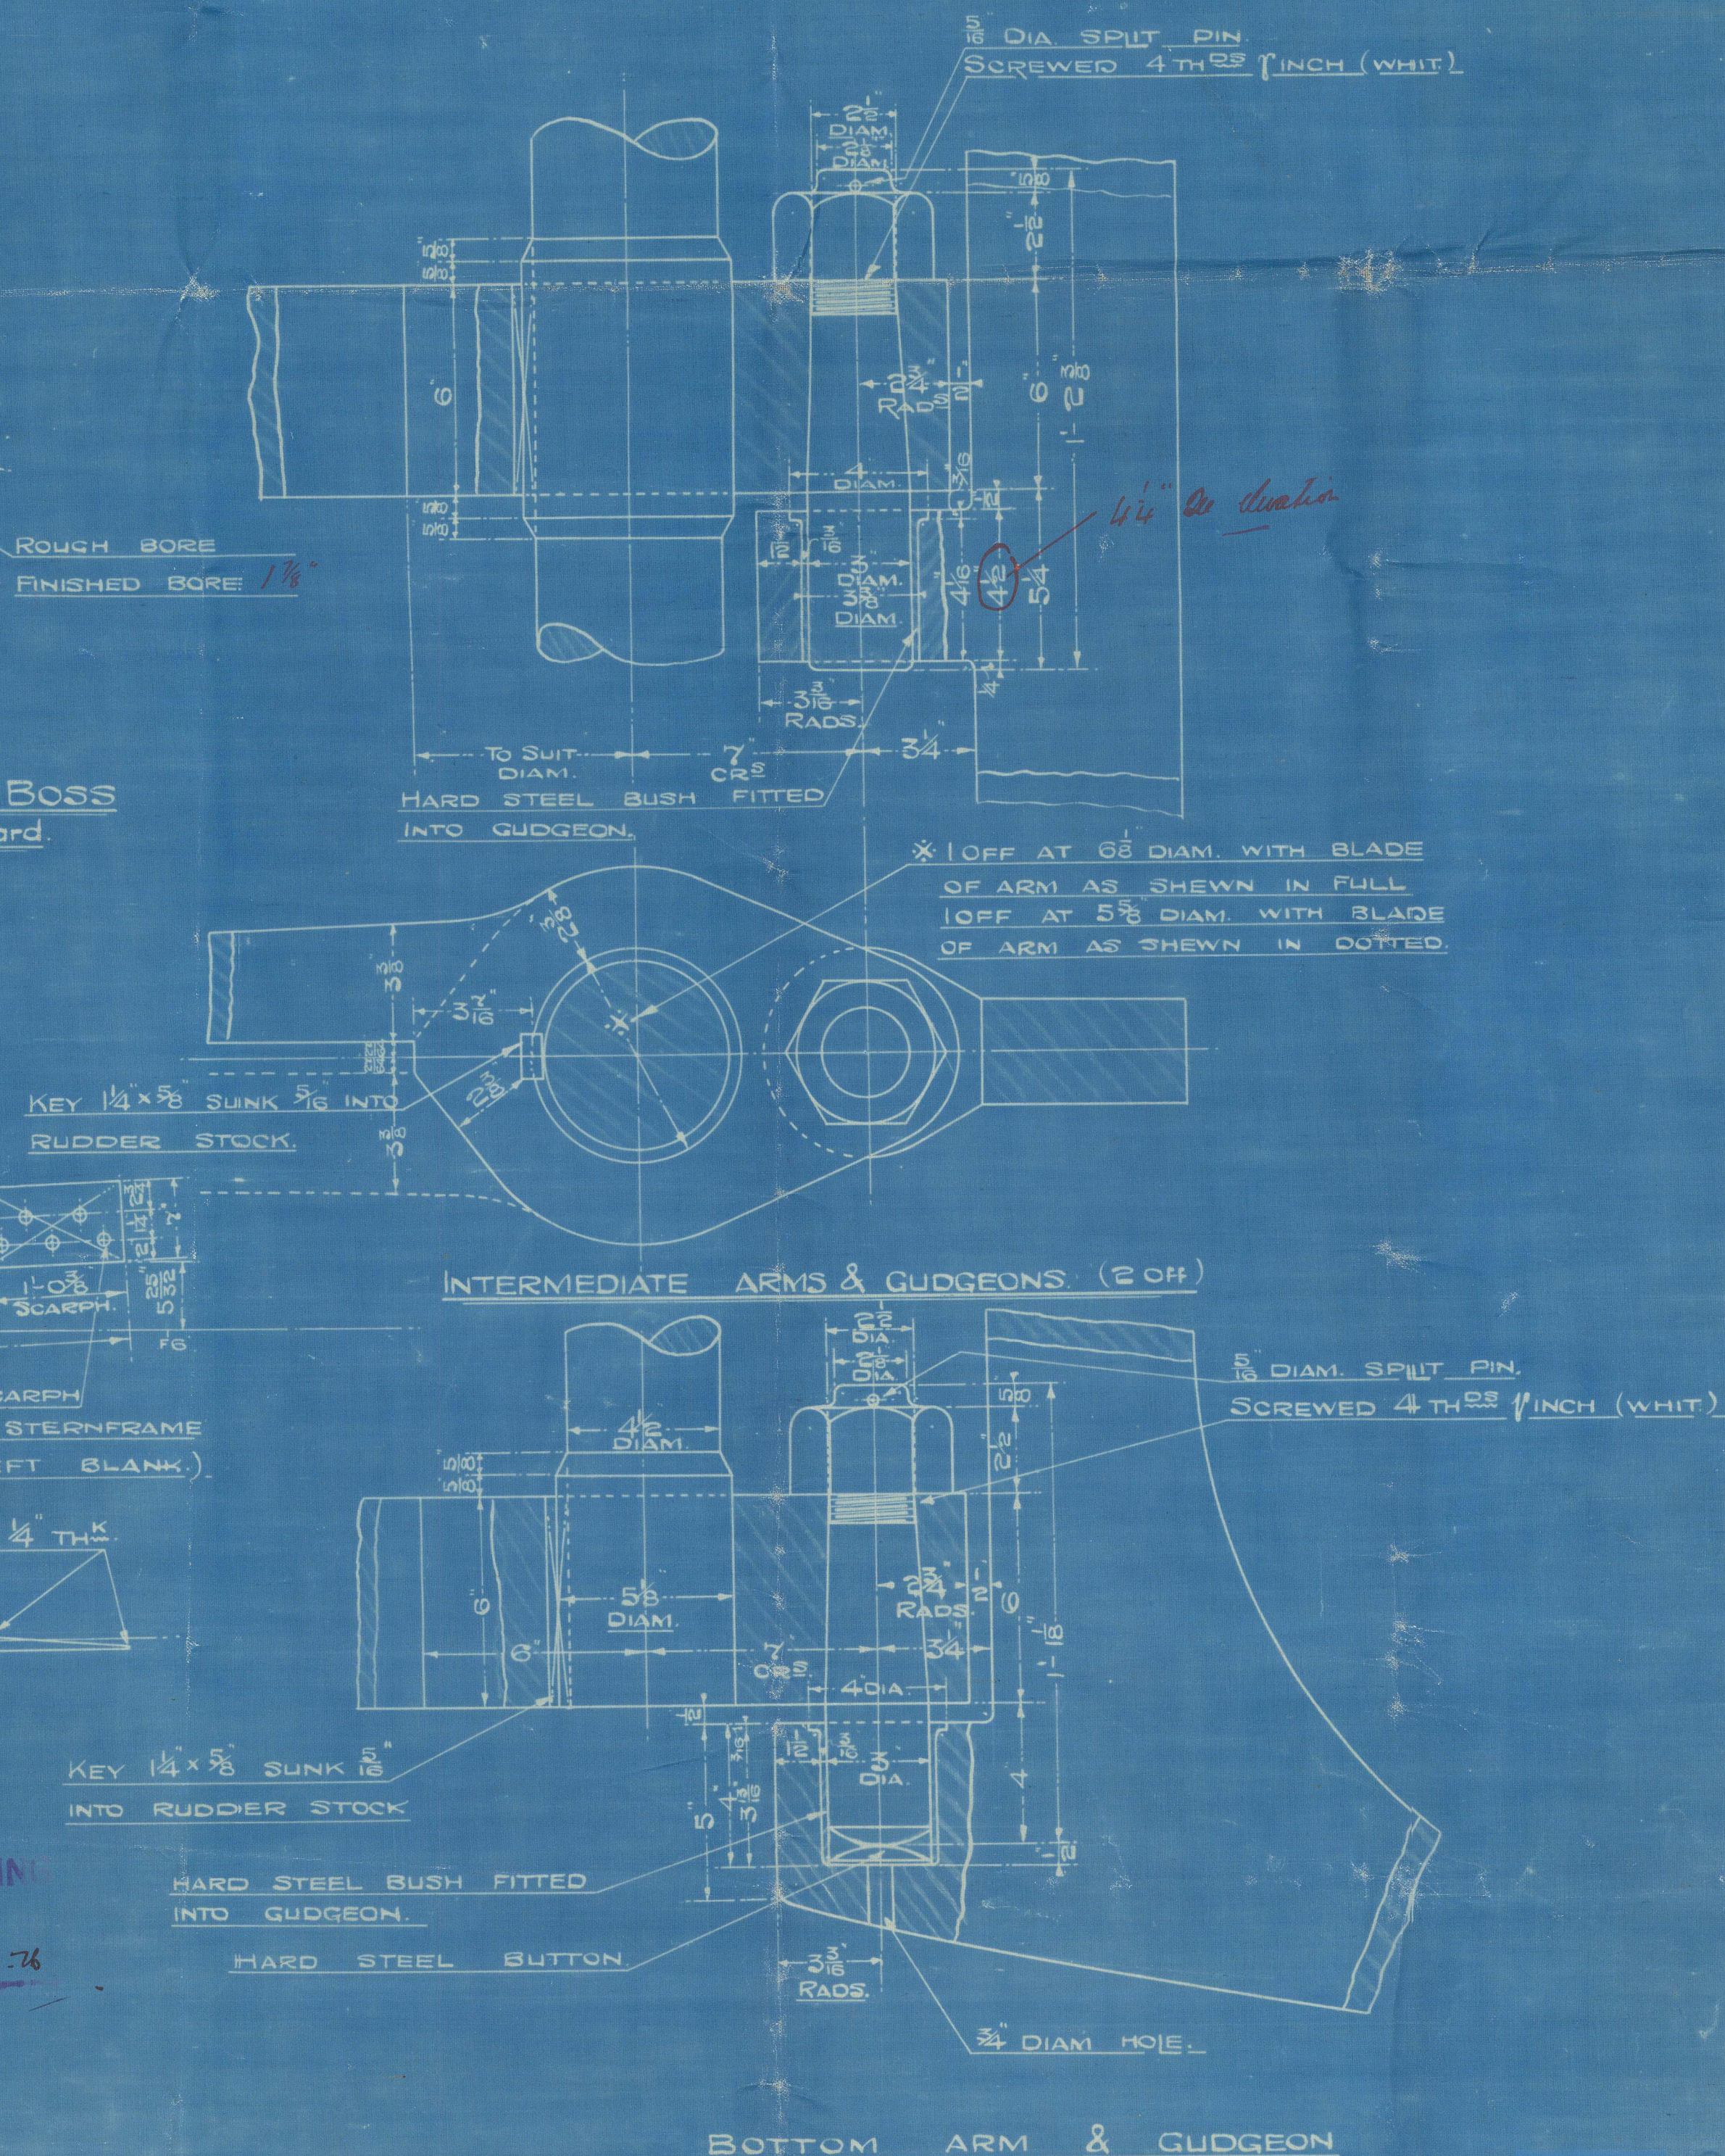

APPROVED  
LLOYDS REGISTER OF SHIPPING  
*[Signature]*  
DATE 26-1-26



J CRAN + SOMERVILLE 4<sup>a</sup>  
SS N<sup>o</sup> 136  
STERN FRAME + RUDDER

S.S. "Wellington"



© 2021

Lloyd's Register  
Foundation

013794-013805-0186