

Son 19/5/32

6 SEP 1932

Index No. 32073
(For London Office only.)

16,993.

Lloyd's Register of Shipping.
SURVEYS FOR FREEBOARD.—STEAM SHIPS.PARTICULARS RELATING TO ALL STEAM SHIPS EITHER FLUSH DECKED, OR WITH
TOP GALLANT FORECASTLES, SHORT POOPS AND BRIDGE HOUSES DISCONNECTED, OR
WITH TOP GALLANT FORECASTLES HAVING LONG POOPS OR RAISED QUARTER DECKS
CONNECTED WITH BRIDGE HOUSES, OR OTHERWISE.Port of Survey *Leith*
Date of Survey *19 June 1932*
Name of Surveyor *John Edwards*Ship's Name. "WELLINGTON"
Port of Registry and Nationality. *Leirpool*
Official Number. *149599*
Gross Tonnage. *285.42*
Date of Build. *1926*
Particulars of Classification. *Contingent +100A1 FOR TOWING SERVICES.*Number in Register Book *✓ 90524*

Registered dimensions from Ship's Register.	LENGTH.	BREADTH.	DEPTH.	UNDER DECK TONNAGE.
	<i>105.0</i>	<i>27.0</i>	<i>12.25</i>	<i>240.66</i>
Length on LOADLINE.	<i>105.0</i>	Frame Depth <i>4 1/2</i> Rule <i>3</i>	CEILING <i>7.20</i> SHEER <i>7.43</i> Tanks <i>in</i>	
		<i>1 1/2</i> <i>no plating +33</i>	<i>12.42</i>	
CORRECTED DIMENSIONS.	<i>105.0</i>	<i>27.08</i>	<i>13.05</i>	<i>240.66</i>

Co-efficient of fineness..... *.649*
Any modification necessary {
[Para. 4 (a) to (e)]* *✓*
Co-efficient as corrected *.68 (lowest in Table)*Sheer { Stem..... *35*
at { Sternpost *31* } $66.0 \div 2 = 33.0$ Mean *35.91*
Sheer at $\frac{1}{2}$ of the length from { Stem *20*
Sternpost *19 1/2* } $39.5 \div 2 = 19.75$ Mean *35.91*
Gradual mean Sheer *allowed 34.45*
Standard mean Sheer [Table, Para. 18] *20.50* Correction
Difference..... $\frac{13.95}{4} = 3.48$
§ If limited as Para. 18 (f) $\frac{20.50}{2} \div 4 = 2.56$
*-2 1/2*Rise in Sheer { At front of bridge house..... *✓*
from amidships {
[Para. 18 (e)] { At after end of forecastleFall in Sheer {
Para. 18 (d) } $\div 2 =$ *✓*
Length uncovered Correction

ALLOWANCE FOR DECK ERECTIONS:—

Freeboard, Table C.....
Correction for Length, if required (Para. 12, 13, and 14)Freeboard by Table A, corrected for sheer, and for length, }
if required (Para. 12, 13, and 14) }Difference
Percentage as below.....Correction for R. Q. Dk. if engine and boiler openings not
covered by bridge house (Para. 11) }

Allowance for Deck Erections

	Length.	Length allowed.	Height.
Forecastle.....			
Bridge House.....			
† Raised Qr. Dk.....			
Poop.....			

Total

Length of Ship

Corresponding percentage {
(Para. 11, 12, 13, or 14) }

FREEBOARD recommended amidships from centre of Disc to top of Statutory Deck Line, Wood (Steel) Deck:—

Fresh Water Line	above centre of Disc	...
Indian Summer Line	" " "	...
Winter Line	below " "	...
Winter North Atlantic Line	" " "	...

7 - SEP 1926

* If the frames, skin planking, or ceiling are of unusual thickness the breadth of vessel to inside

† In vessels obtaining an allowance for deck erections under Para. 11 where the sheer drops abaft amid-

ships the height of the R.Q.D. is to be taken from the level of the top of the amidship beam.

§ In flush-decked vessels the total standard mean sheer means the sheer measured at the stem and stern-

post. In vessels having poops and forecastles, it means the sheer measured at points distant

one-eighth of the vessel's length from stem and stern-post.

Moulded Depth as measured..... *13-6"*
Reduced mid depth
Addition for Keel below base line *2 1/2"*
for draught record..... *7* inches.NOTE.—If the
depth is measured
when vessel is
aloft, the details
of measurement
should be reported.*13-6"*
7
14-1"
1-8"
12-5"

CORRECTION FOR LENGTH

Length of Ship on Loadline..... *105.0*
Length in Table *159.5*
Difference *54.5*
Correction for 10ft., Table A. *.9* Table C.
× Difference divided by 10 *4.905* (if required.)
If $\frac{1}{10}$ ths length covered divide by 2 *-5"*

CORRECTION FOR IRON DECK.

Proportion covered, if less than $\frac{1}{10}$ ths length covered
Thickness of usual wood deck, less stringer *2 1/2"*
Induced mid depth

CORRECTION FOR ROUND OF BEAM.

Breadth at Gunwale amidships..... *27-0"*
Round of Beam *7 3/4"*
Normal round..... *6 3/4"*
Difference $\frac{1}{4} \div 2 =$ *1/8"*
Proportion of Deck uncovered (Para. 19)NOTE.—The
round of beam
should be report-
ed on the full
breadth of vessel
at the gunwale.Freeboard, Table A *1-11 1/2"*
Correction for Sheer *-2 1/2"*
Correction for Length *-5"*
Allowance for Deck Erections *-4"*
Correction for Round of Beam..... *✓*
Correction for fall in Sheer (if any)..... *✓*
Correction for Steel Deck (if required) *allowed in reduced mid depth*
Additions for non-compliance with provisions of }
Para. 11 (d) and (e) † } *✓*
Other Corrections (if any) *✓*Winter Freeboard *1-4"*
Summer Freeboard *1-2 3/4"*
Indian Summer Freeboard *1-1 1/2"*
N. A. Winter Freeboard *✓*Correction necessary because clearside amidships, measured
in accordance with the Statute is not taken at the
intersection of the wood or steel deck with side. *1"*Winter Freeboard from deck line *1-5"*
Summer " " " " *1-3 3/4"*
Indian Summer " " " "
N. A. Winter " " " " *✓*Winter Freeboard from deck line *1-3 1/2"* *1-4 3/4"*Fresh Water Line above centre of Disc ... *3"*Indian Summer Line " " " " ... *1 1/2"*Winter Line below " " " " ... *1 1/2"*Winter North Atlantic Line " " " " ... *✓*The Surveyor should state whether the fall in sheer as reported is measured relatively to the straight
line of keel or to the water line. It measured relatively to water line the vessel's draft at time of
survey, and also the usual load draft forward and aft should be reported.
to allow same.

Do all the Frames extend to the top height in the Poop? ☒ Raised Quarter Deck? ☒ Bridge House? ☒ Forecastle? ☒

To what height do the Reverse Frames extend? ☒

Has the Poop or Raised Quarter Deck an efficient Iron Bulkhead at the fore end? ☒

Give particulars of the means for closing the openings in Bulkhead ☒

Is the Poop or Raised Quarter Deck connected with the Bridge House? ☒ Has the Bridge House an efficient Bulkhead at the fore end? ☒

Give particulars of the means for closing the openings in Bulkhead ☒

What is the thickness of the Bridge Front plating? ☒ and Coaming plate? ☒

Give scantlings and spacing of the Stiffeners ☒

Are bracket plates fitted at each end of the Stiffeners? ☒ Are hor'l. brackets fitted connecting Bridge Bulk'd. with Bulwarks? ☒

Has the Bridge House an efficient Iron Bulkhead at the after end? ☒

How are the openings closed? ☒

Is the Forecastle at least as high as the main or top-gallant rail? ☒ Has the Forecastle an efficient Iron or Wood Bulk'd. at after end? ☒

Are the Engine and Boiler openings covered by a Bridge, Poop, Raised Quarter Deck, or enclosed by a Strong Iron or Steel Deckhouse? ☒ *by efficient casings, (as for profile plan)*

If the openings are not so protected are the exposed parts of the Casings efficiently constructed? ☒

Give thickness of plating; scantlings and spacing of Stiffeners *Coaming .30. plating .25. Stiffs 3 1/2 x 3 x .35. 30" apart.*

What is the height of the exposed Casings? *3'-9", 5'-0" + 7'-0"* Are suitable means provided for closing all openings in them in bad weather? *gas steel doors*

Are the Weather Deck Hatchways efficiently constructed and at least equal to the requirements of Section 28 of the Rules for 1904-5? Give particulars below:— ☒

Position and Size.											
Item.		Ship.	Rule.	Ship.	Rule.	Ship.	Rule.	Ship.	Rule.	Ship.	Rule.
COAMING.	Height above top of DECK										
	Thickness { Sides..... Ends.....		<input checked="" type="checkbox"/>								
SHIFTING BEAMS OR WEB PLATES.	Number										
	Section and Scantlings		<input checked="" type="checkbox"/>								
	Material										
* FORE AND AFTERS.	Number										
	Section and Scantlings		<input checked="" type="checkbox"/>								
	Material										
HATCHES Thickness											
Remarks.....											

* The depth of Fore and Afters should be stated from the underside of the hatches in all cases.

(If the sill of the lowest side scuttle will be less than 6 inches above the Indian Summer Load Line if assigned under the tables, state vertical distance from top of deck at side amidships to lower edge of lowest side scuttle.)

The following information is to be given in all Cases of vessels dealt with under Paras. 11, 12 (under 15 feet Moulded depth) and under Shelter Deck Rules.

What is the thickness of the Bridge Sheerstrake? ☒ Strake between Main and Bridge Sheerstrakes? ☒


Delete the words ☒ The Crew ~~are~~ are not, berthed in the bridge house. -
that do not apply ☒ The arrangements to enable them to get backwards and forwards from their quarters are, ~~are not~~ satisfactory.

Length of Bulwarks in well *full length of vessel*
Area of Freeing Ports required by Para. 11 (e) each side of vessel = *satisfactory* Sq. ft.

Ft. Tenth. Ft. Tenth. No. } Freeing Ports (each side of vessel) = Sq. ft.

Fore 2.5' x 2.0' x 1
Aft 2.5' x 1.5' x 3

3 Riggers led overboard Total deficiency or excess = *7'-0"* Sq. ft.

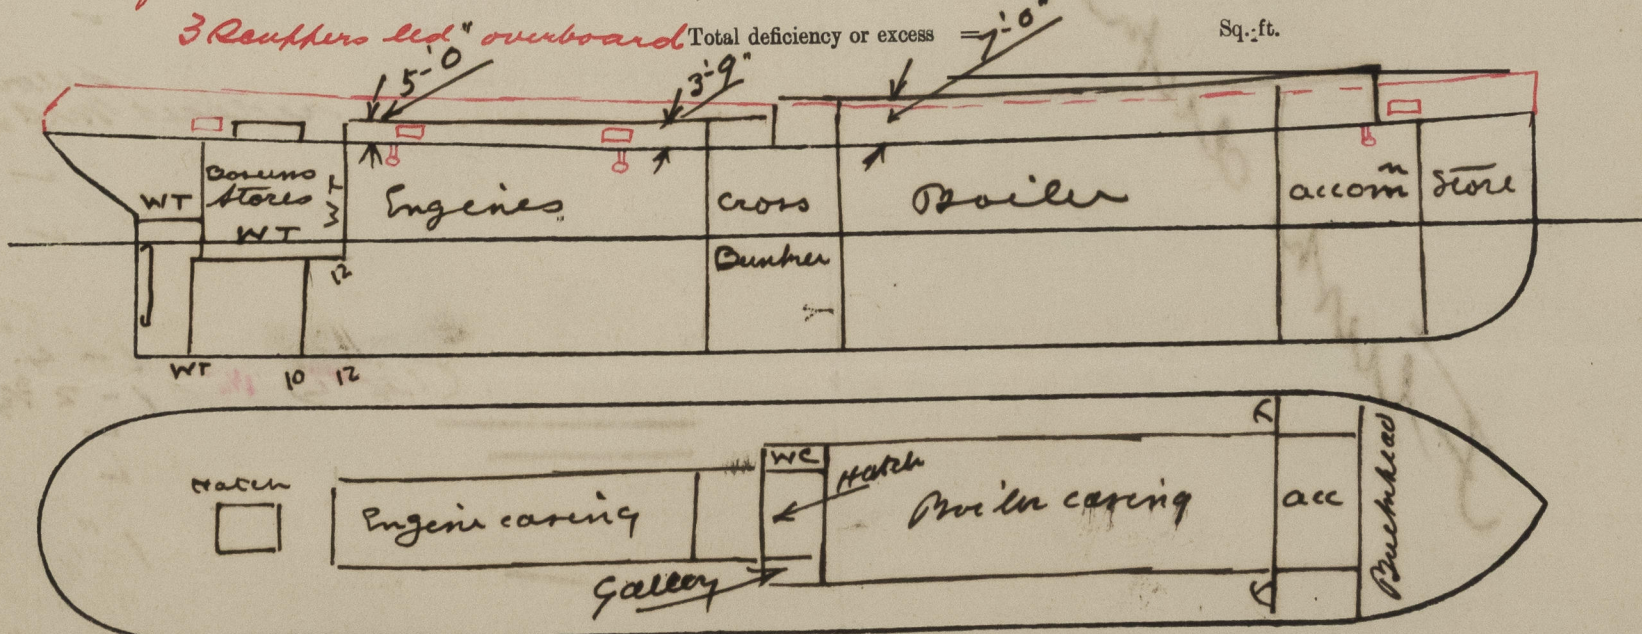

Show hereon line of Floors or Tank Top with position of any Breaks in same; also height of Peak Tank tops, &c., &c.

State any special features in the construction of the Vessel ☒

Builder's name and yard number *136*

Names of sister vessels ☒

Owners *Alexandra Towing Co Ltd*

Address *Water Street, Liverpool*

Fee £ *2*

Received by me *See F.B. Rpt.*

To be charged with Post Entry.



© 2021

Lloyd's Register Foundation